


NORTH WEST CORNER				
POINT	DESCRIPTION	NORTHING	EASTING	ELEVATION
1	PC	595862.5355	1488432.6595	569.89
2	PCC	595867.1931	1488460.7372	570.51
3	PT	595875.2214	1488465.1189	570.71
4	LP	595882.0604	1488465.2873	570.86

NORTH EAST CORNER				
POINT	DESCRIPTION	NORTHING	EASTING	ELEVATION
5	PC	595867.3808	1488505.9442	571.33
6	PCC	595862.3541	1488506.3880	571.25
7	PCC	595827.1324	1488520.0346	570.86
8	PCC	595814.0948	1488535.2849	570.77
9	PCC	595811.4922	1488542.5871	570.68
10	PT	595813.8394	1488548.2103	570.66
11	PC	595822.6747	1488553.2708	570.69
12	PT	595825.0212	1488558.8954	570.62
13	LP	595836.6794	1488561.9942	MATCH EXIST.
14	LP	595867.5200	1488520.6101	MATCH EXIST.

SOUTH WEST CORNER				
POINT	DESCRIPTION	NORTHING	EASTING	ELEVATION
15	LP	595800.7670	1488394.4178	567.82
16	PC	595806.3392	1488395.9370	567.84
17	PT	595809.8479	1488402.0761	567.88
18	PC	595801.0773	1488434.2453	568.21
19	PRC	595802.4152	1488439.1449	568.32
20	PCC	595803.1586	1488452.6035	568.52
21	PT	595773.7675	1488465.9977	567.66
22	PC	595764.4803	1488465.5135	566.81
23	POE	595742.5595	1488457.5648	565.95
24	POB	595741.0493	1488453.4960	566.06
25	FACE EX. STONE WALL			566.63
26	FACE EX. STONE WALL			567.79
27	CNR. OF EX. COBBLE STONE WALKWAY			568.75
28	WALKWAY			568.70
29	MATCH EXISTING			MATCH EX.

SOUTH EAST CORNER				
POINT	DESCRIPTION	NORTHING	EASTING	ELEVATION
30	PC	595729.9706	1488510.4683	565.46
31	PCC	595753.0845	1488513.3614	567.77
32	PCC	595764.7275	1488539.5101	569.17
33	PT	595749.6157	1488566.0117	569.09
34	PC	595744.3238	1488567.8093	568.93
35	PT	595741.0191	1488571.6144	568.82
36	LP	595739.4958	1488580.4320	568.86
37	BUILD FACE			569.64
38	BUILD FACE			566.80
39	BUILD FACE			567.89

NOTES:
 1. ELEVATIONS SHOWN AT EDGE OF PAVEMENT ARE AT THE GUTTER LINE.
 2. GRADING FOR PARK AREA SIDEWALK TO BE DETERMINED ONCE LAYOUT IS FINALIZED.
 3. WALKABLE AREAS SHALL NOT EXCEED 2% CROSS SLOPE.

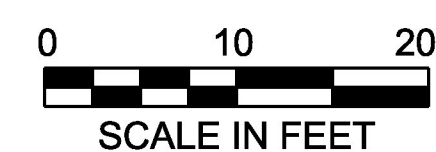

PROJECT NAME: BRISTOL
 PROJECT NUMBER: HES 021-1 (28)

FILE NAME: z10b078bdr_curbdet.dgn
 PROJECT LEADER: T. LUTHER
 DESIGNED BY: D. DEBAIE
GRADING PLAN

PLOT DATE: 4/29/2014
 DRAWN BY: P. ARMATA
 CHECKED BY: G. EDWARDS
 SHEET 13 OF 29