




**NORTH ST. STA 12+85, 34' LT
LOOKING NORTHERLY
MA 1**

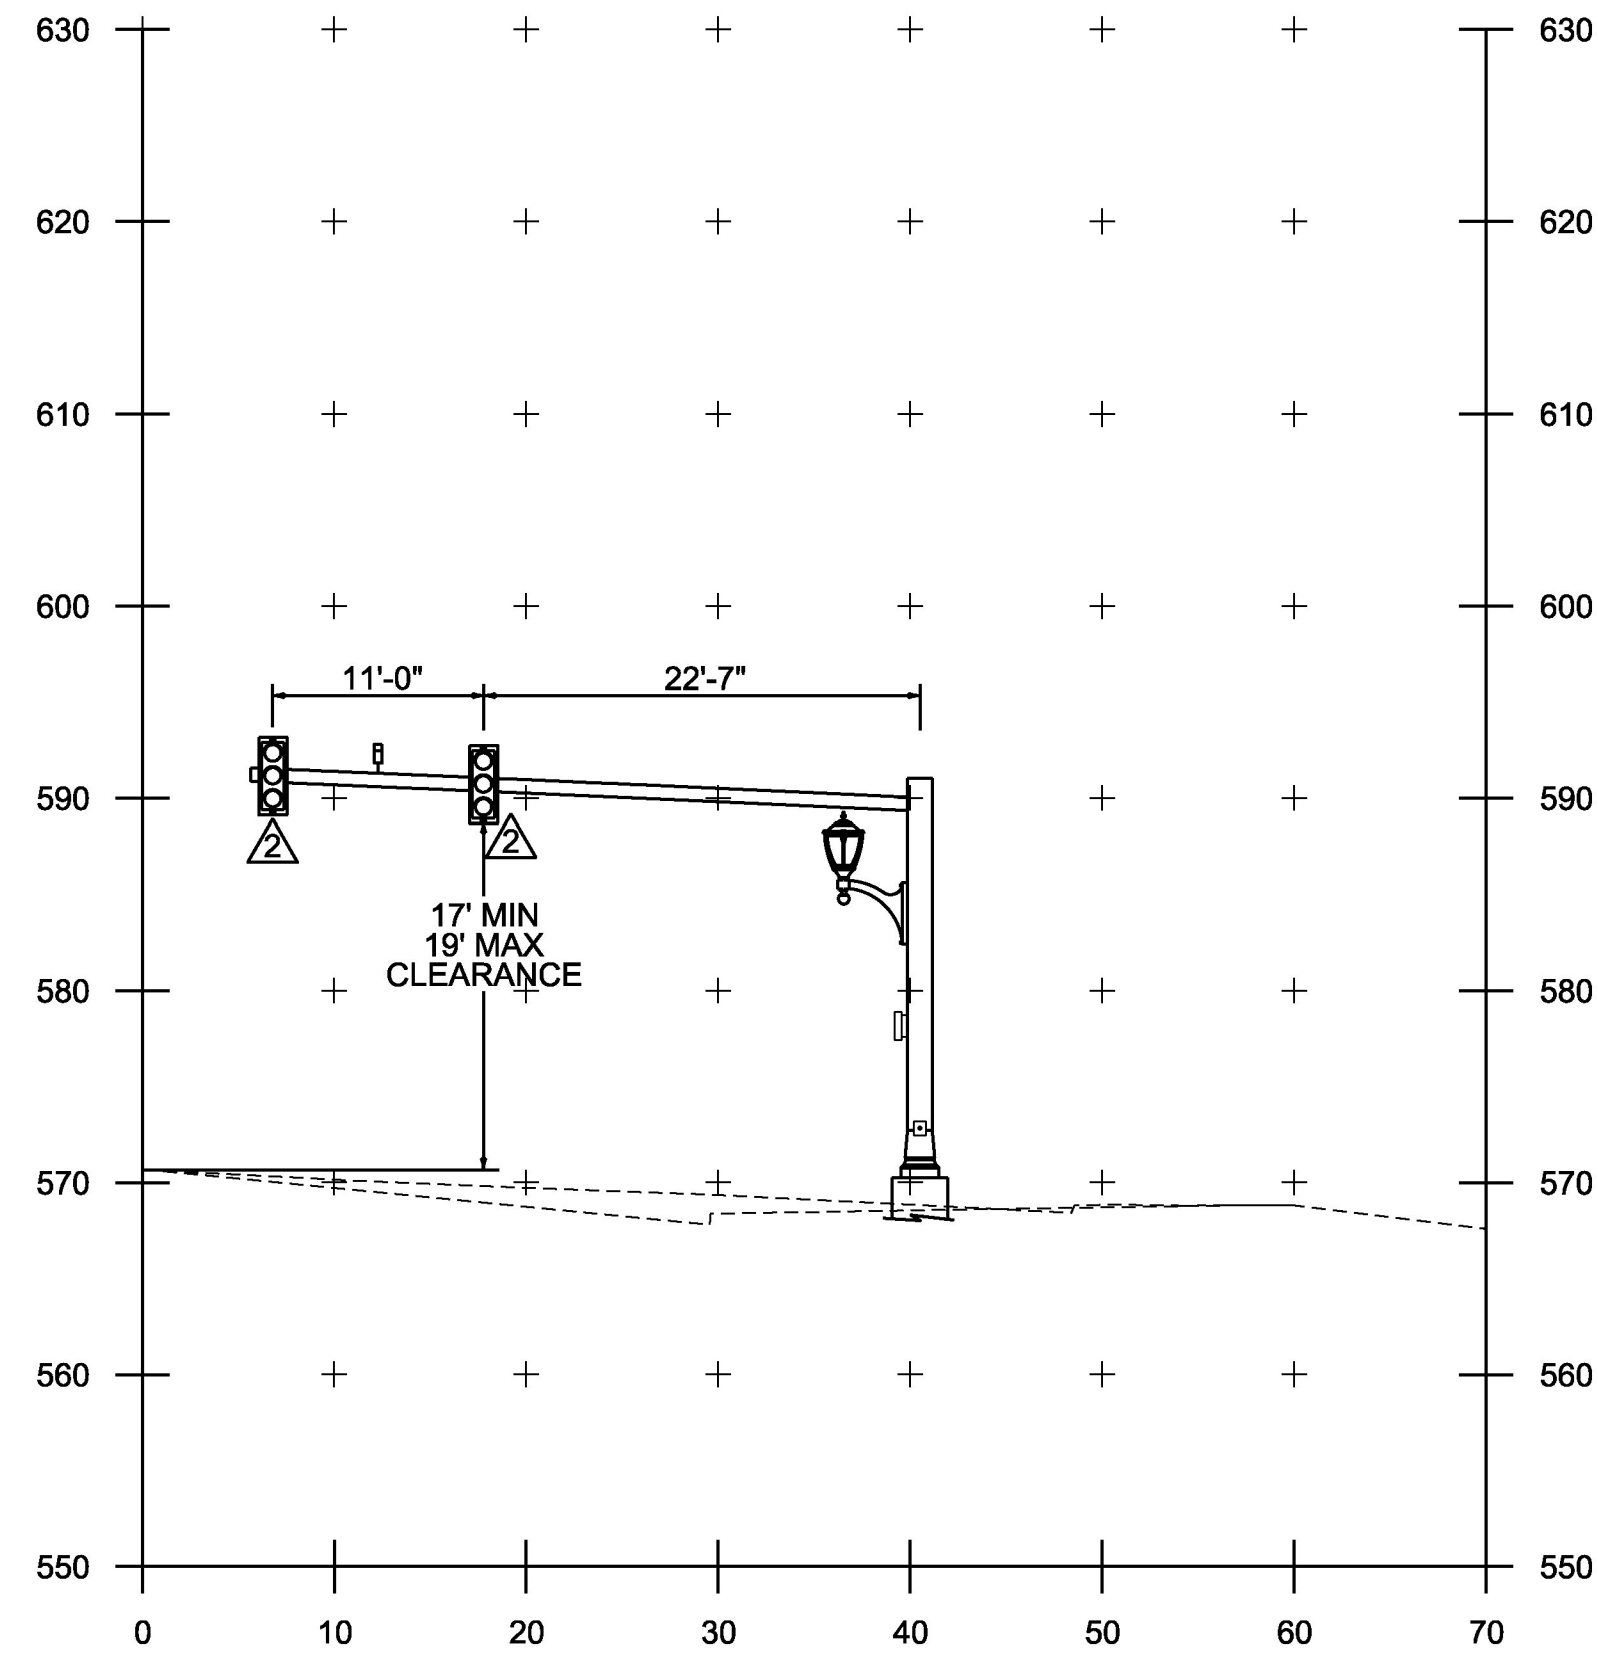


**VT ROUTE 116 STA 13+26, 40.5' RT
LOOKING EASTERLY
MA 2**

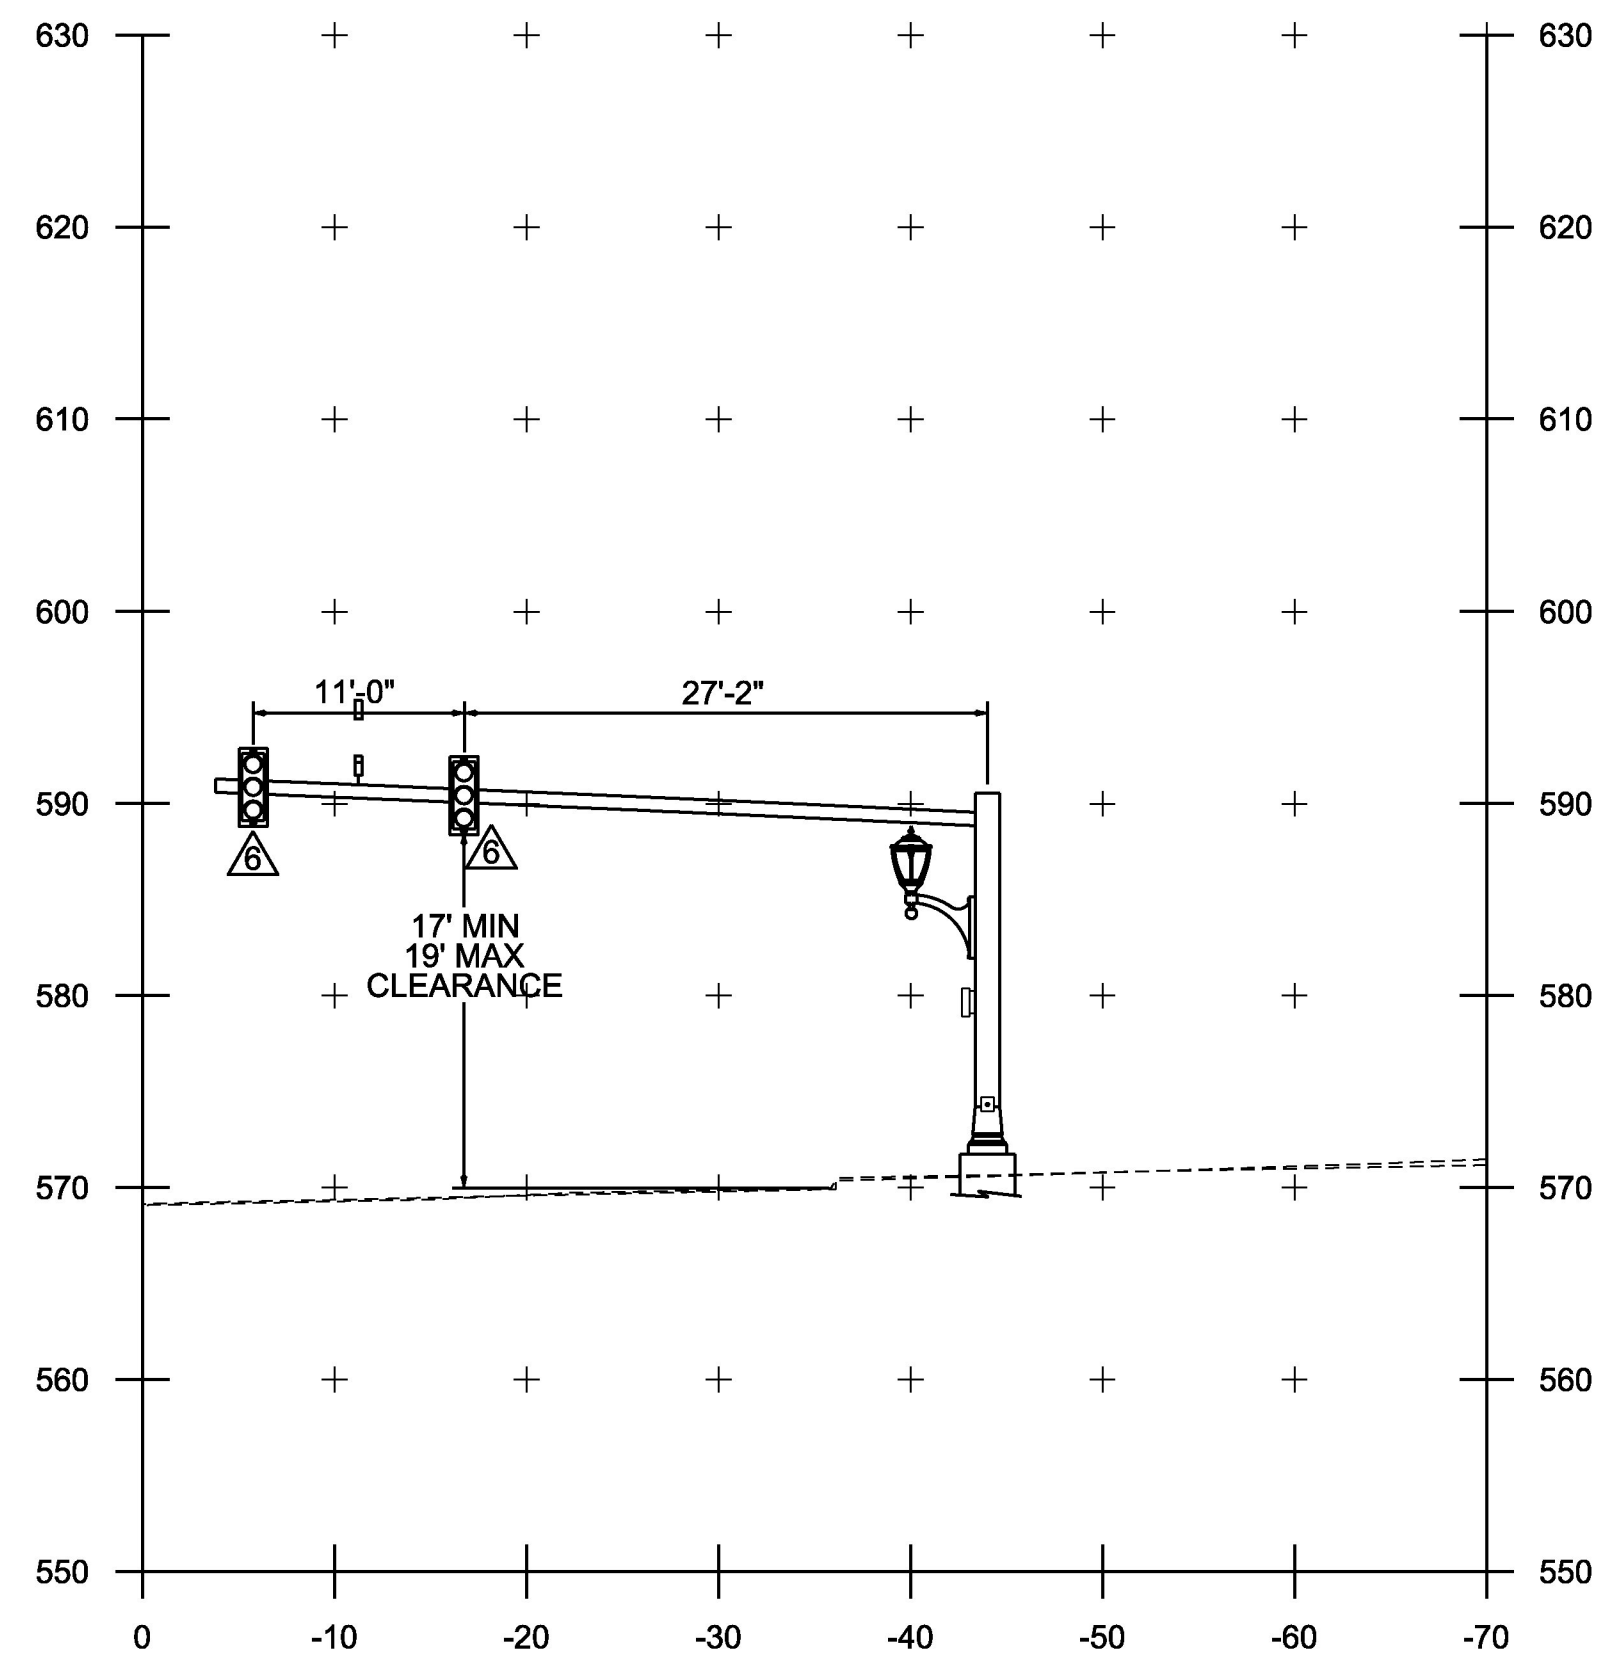

**VT ROUTE 116 STA 11+99, 44.0' LT
LOOKING WESTERLY
MA 4**

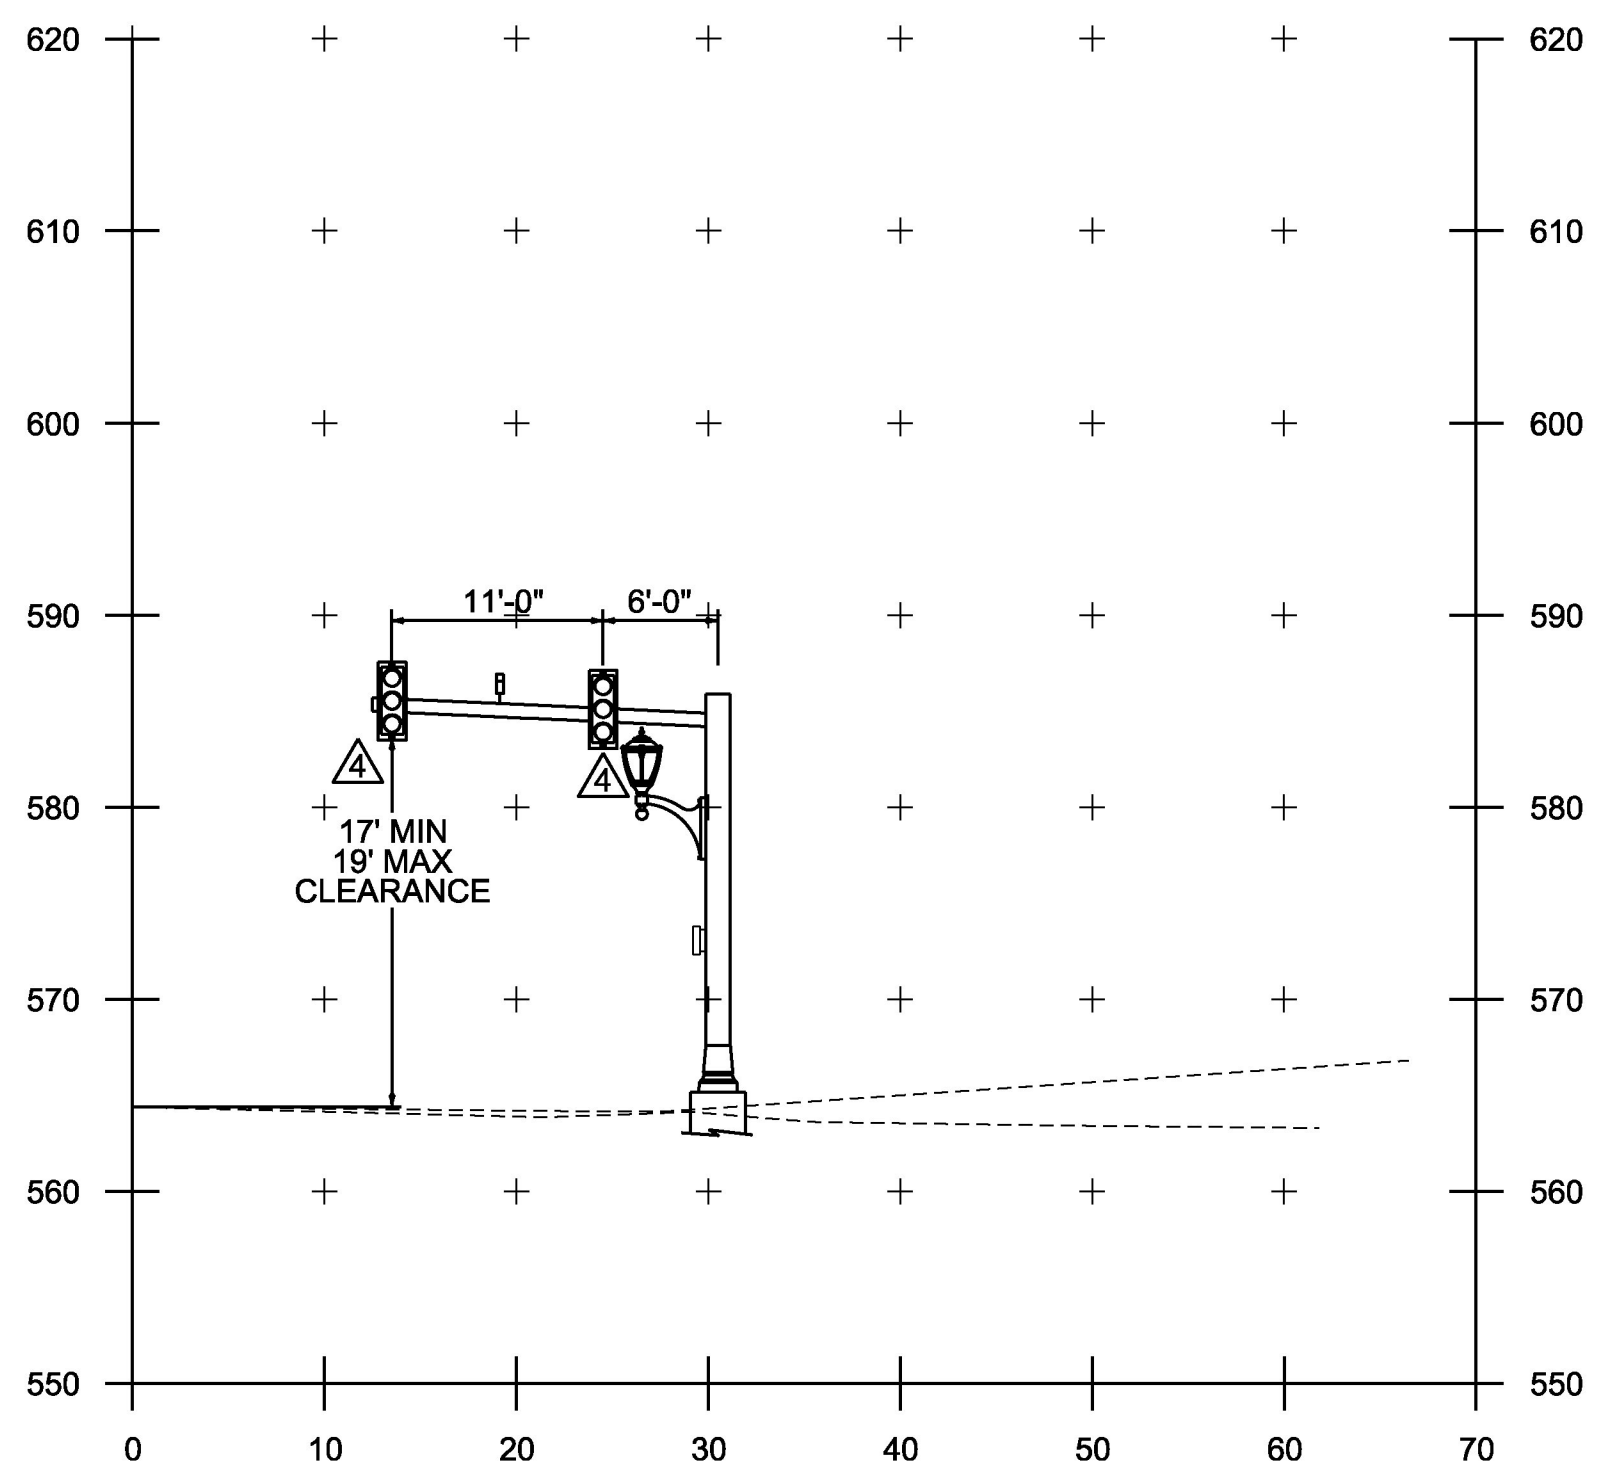

**SOUTH ST. STA 12+45, 34' RT.
LOOKING SOUTHERLY
MA 3**

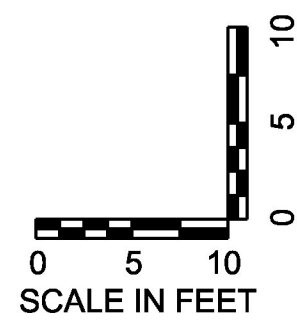

PROJECT NAME: BRISTOL
PROJECT NUMBER: HES 021-1 (28)

FILE NAME: z10b078bdr_mastxs.dgn
PROJECT LEADER: T. LUTHER
DESIGNED BY: T. LUTHER

PLOT DATE: 4/29/2014
DRAWN BY: P. ARMATA
CHECKED BY: G. EDWARDS
SHEET 20 OF 29



MAST ARM CROSS SECTION