


SEE PLAN FOR SHRUB AND PERENNIAL LOCATION AND SPACING

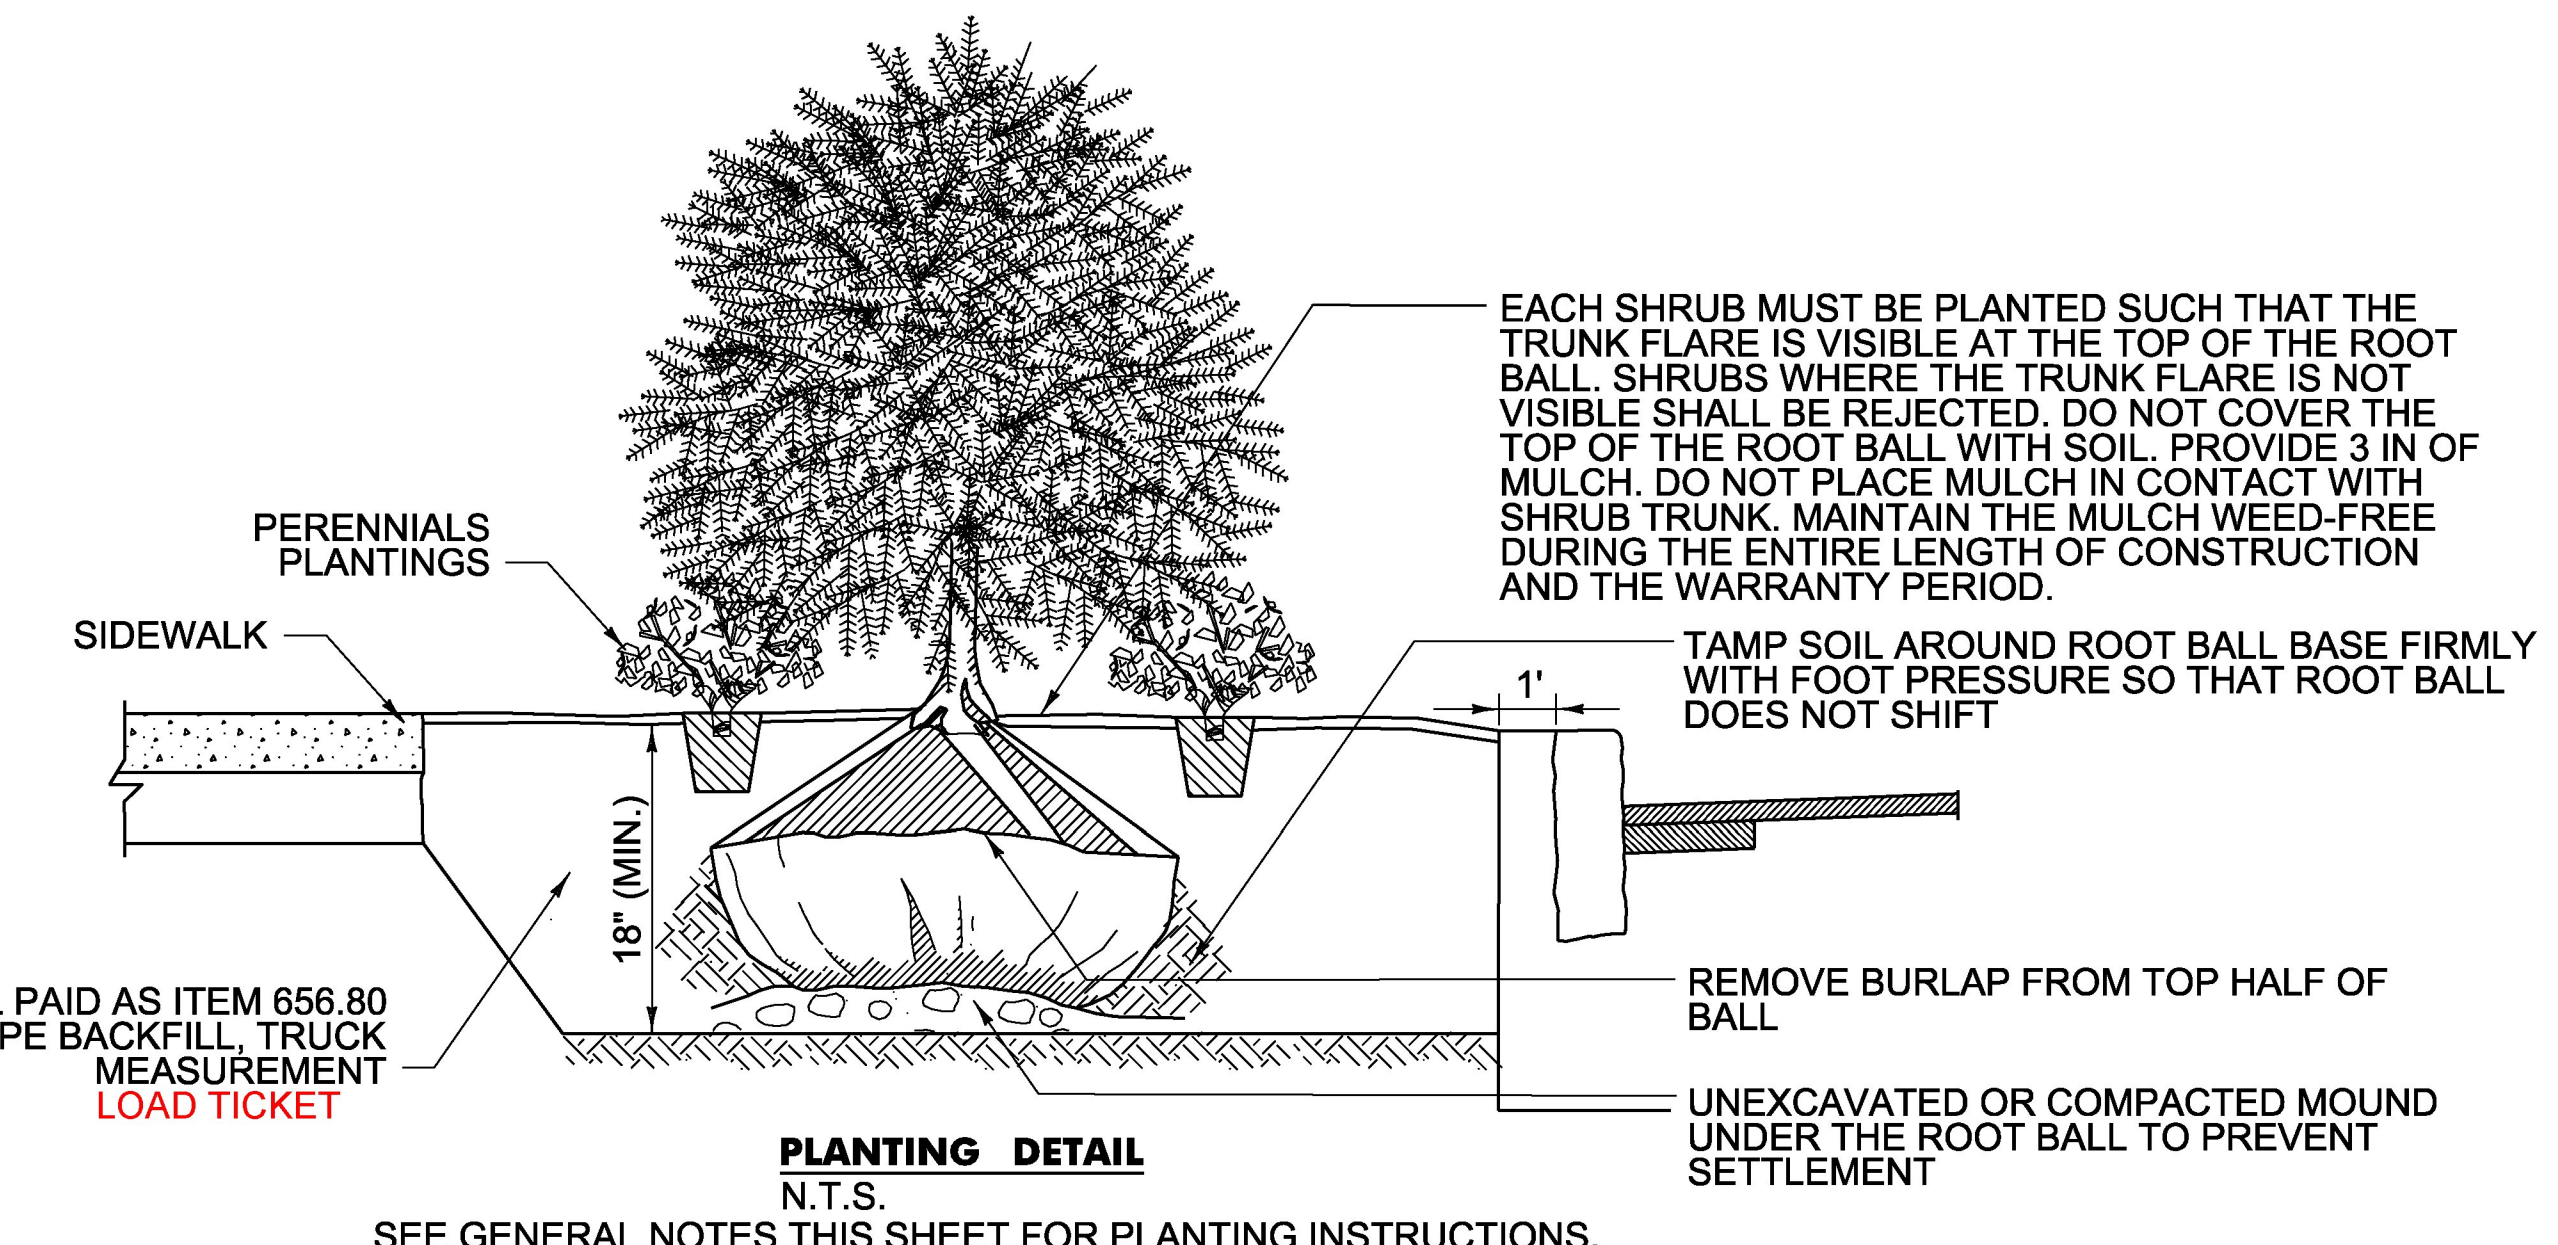

SEE NOTE 3

INCREASE BASE TO 12"

SEE NOTE 3

SCORING IS INCIDENTAL TO ITEM 618.10 PORTLAND CEMENT CONCRETE SIDEWALK, 5 INCH

STAMPED COLORED CONCRETE (TYP.)

PLANTING SCHEDULE

QTY	SYMBOL	SPECIES	COMMON NAME	SIZE
47	HL	HEMEROCALLIS 'STELLA D' ORO'	STELLA D'ORO DAYLILY	1 GAL POTS
12	MD	MICROBIOTA DECUSSATA	SIBERIAN CARPET	18-24" POTS
55	NF	NEPETA 'WALKERS LOW'	WALKERS LOW CATMINT	1 GAL POTS
24	RF	RUDBECKIA 'GOLDSTRUM'	GOLDSTRUM BLACK EYE SUSAN	1 GAL POTS
9	SA	SEDUM 'AUTUMN JOY'	AUTUMN JOY SEDUM	1 GAL POTS

GENERAL NOTES:

1. PLANTING DETAILS PROVIDED ARE FROM THE INTERNATIONAL SOCIETY OF ARBORCULTURE. DETAILS ON THIS SHEET ARE PROVIDED FOR GENERAL INFORMATION ONLY. EACH TYPE OF TREE OR SHRUB SHALL BE INSTALLED PER VTRANS STANDARD SPECIFICATIONS FOR CONSTRUCTION.
2. SOILS AT THE OUTER LIMIT OF PLANTING AREAS MUST NOT BE SO COMPACTED AS TO RESTRICT ROOT GROWTH. SOILS MAY BE TESTED, AT THE DIRECTION OF THE RESIDENT ENGINEER, FOR TEXTURE, DRAINAGE CAPABILITY, PH AND NUTRIENT VALUES PRIOR TO DETERMINING ANY ADDITIONAL SOIL IMPROVEMENTS.
3. AREAS SHOWN ON THIS PLAN THAT CALL FOR TURF ESTABLISHMENT SHALL BE TOP SOILED, SEEDED, FERTILIZED AND MULCHED IN ACCORDANCE WITH SECTION 651. THIS WORK SHALL NOT BE PAID FOR SEPARATELY BUT BE PAID INCIDENTAL TO OTHER LANDSCAPING ITEMS.
4. SPACING TO BE IN ACCORDANCE WITH SUPPLIERS RECOMMENDATIONS.



PROJECT NAME:	BRISTOL
PROJECT NUMBER:	HES 021-1 (28)
FILE NAME:	z10b078bdr_llp.dgn
PROJECT LEADER:	T. LUTHER
DESIGNED BY:	T. LUTHER
LANDSCAPING PLAN	
PLOT DATE:	4/29/2014
DRAWN BY:	P. ARMATA
CHECKED BY:	G. EDWARDS
SHEET	29 OF 29