



Precast Square Structure

48" Square (48SQ)

119 Gal. / Vertical ft.

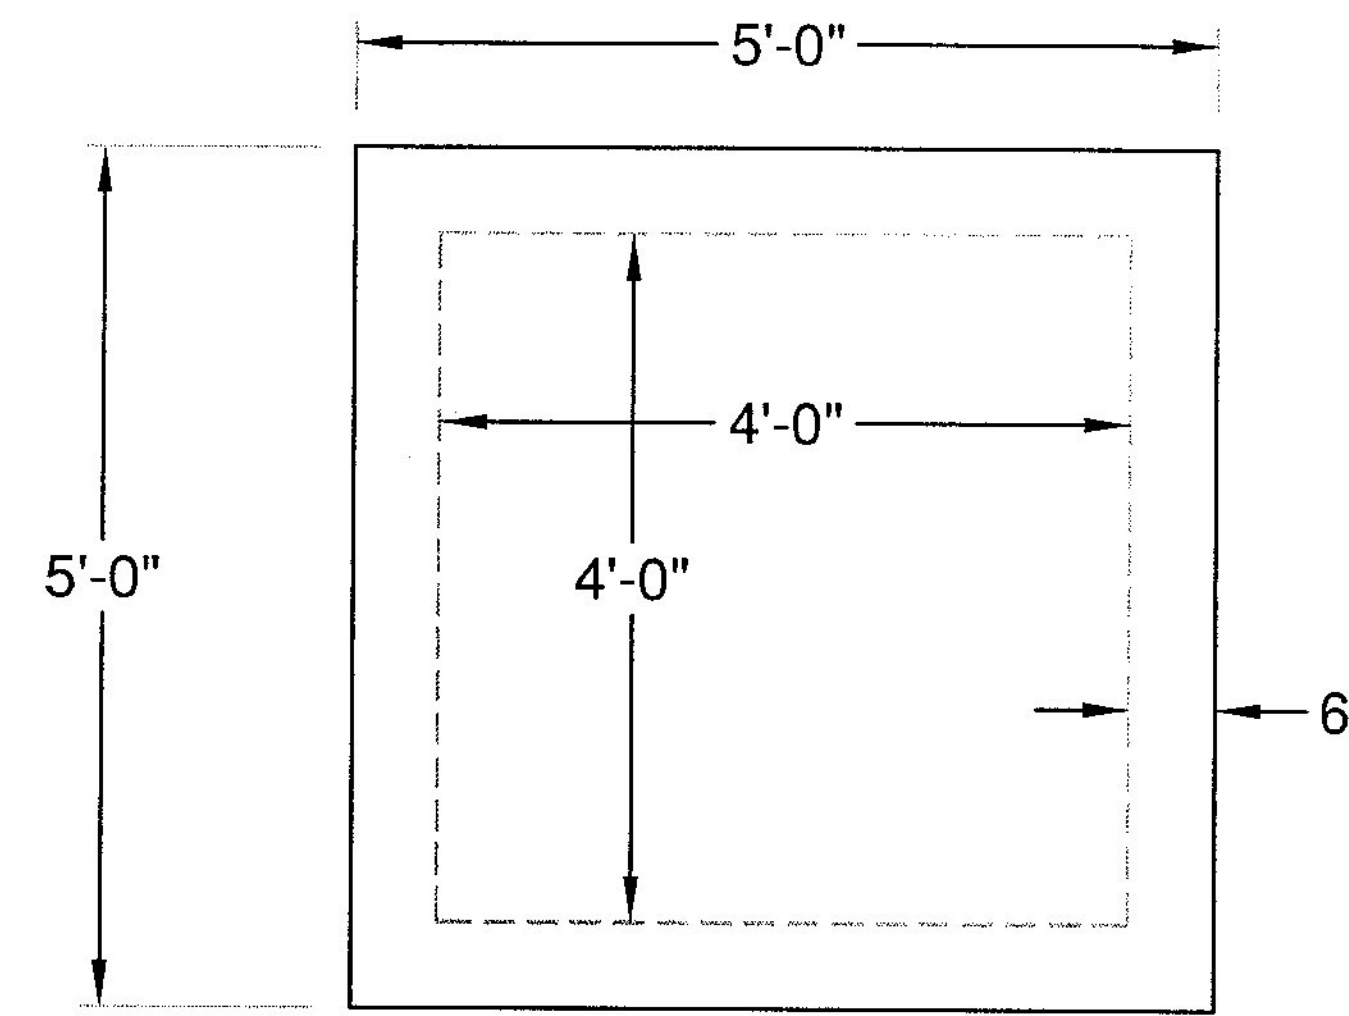

Plan

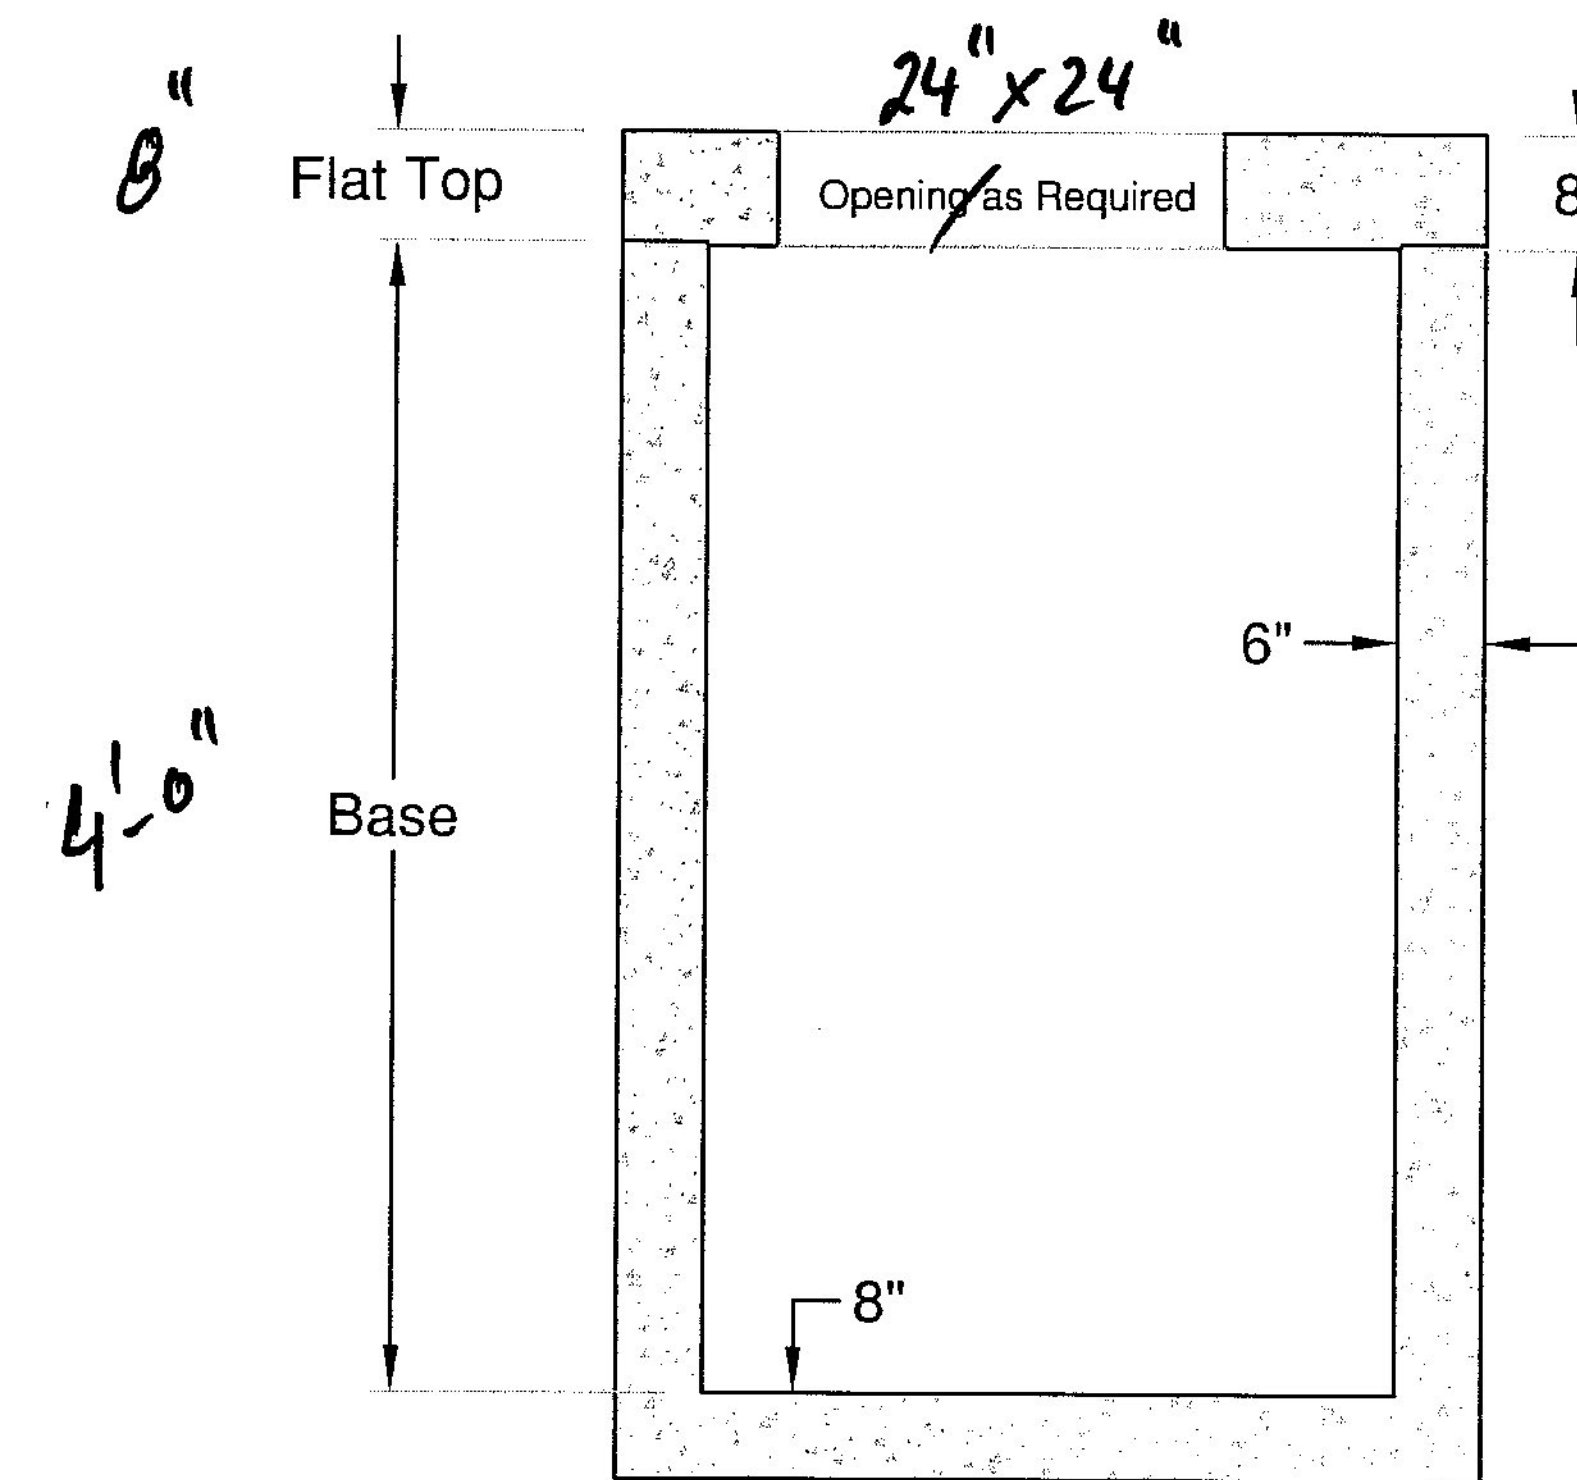

Section

SPECIFICATIONS:

- Concrete Minimum Strength 5000psi @ 28 days
- Steel Reinforcement grade 60
- Joints sealed with Butyl sealant
- Monolithic Construction
- H-20 Design Available
- Pipe Penetrations Supplied per Specifications
- Weights Subject to Variation



PRECAST CONCRETE PRODUCTS
 78 PRECAST ROAD MILTON, VT 05468 • 802.893.2401
 TOLL FREE 1.888.299.2401 FAX 802.893.1542