


CONFIDENTIAL WORKSHEET

BENNETT BOLT WORKS

HOOK BOLT - RIGHT ANGLE BEND

ITEM ID
150C5400BANS

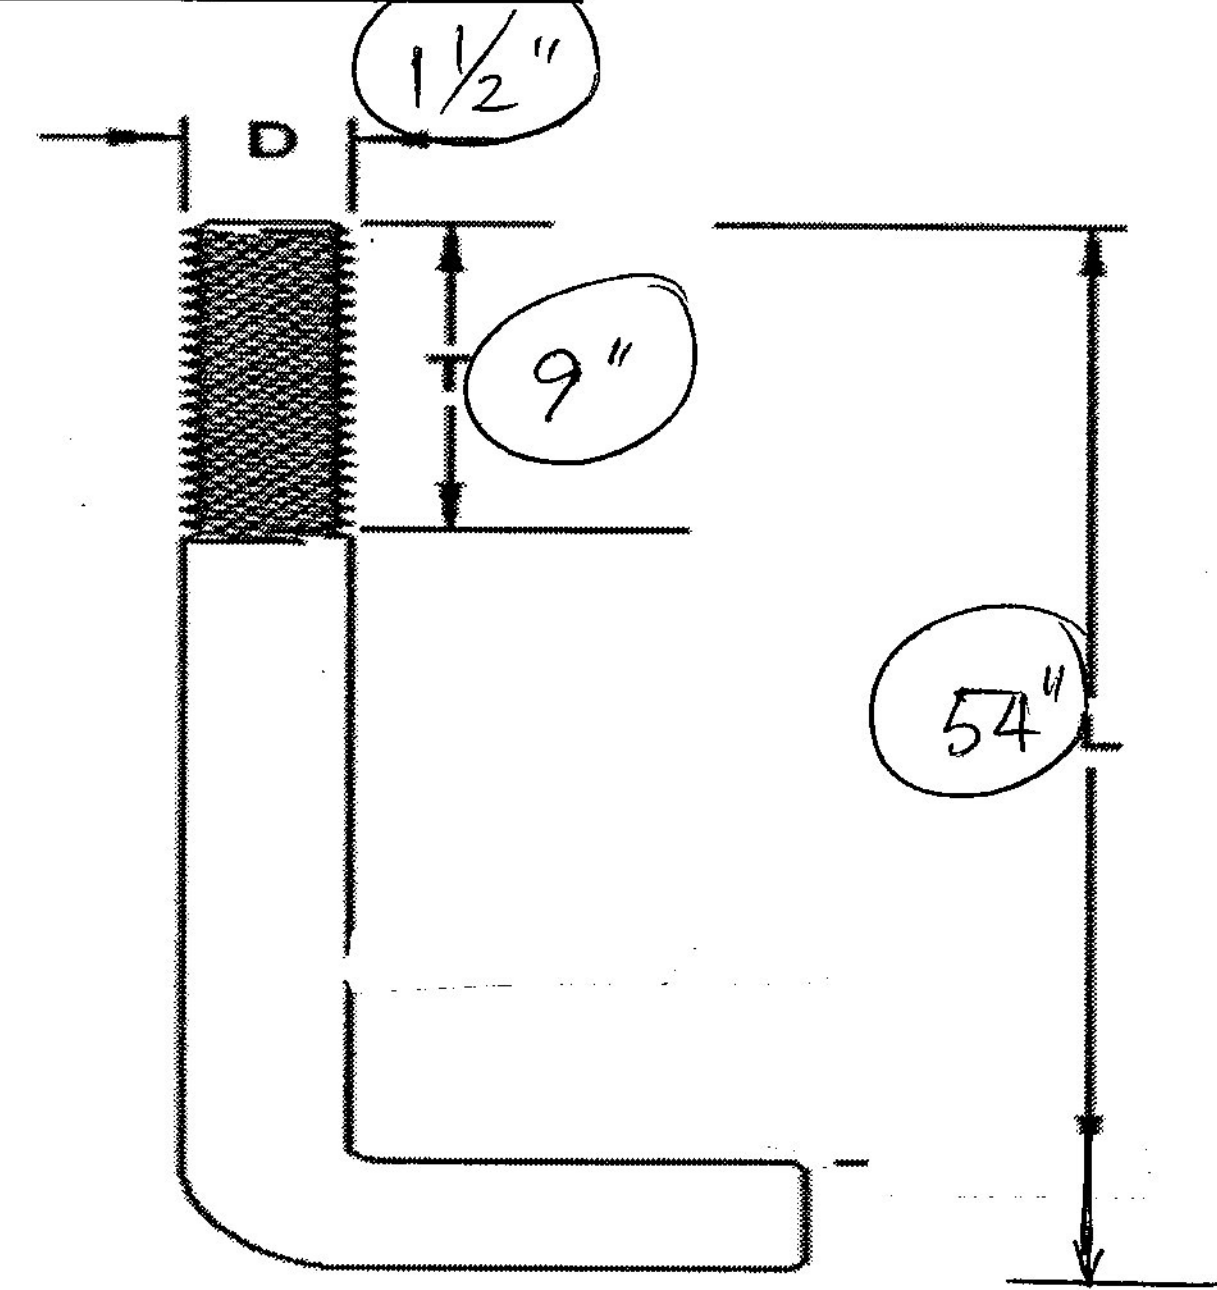

Dimensions
D x L x C x T
6"

| | |
|---------------------------|---------------------|
| Order Number | Customer |
| | HIGHWAY TECH |
| Grade | EACH |
| 304 Stainless IMPORTED | 16 |
| Finish | Thread Type |
| plain | cut |
| Dia (D) | Length (L) |
| 1 1/2 | 54 |
| Inside Bend Length (C) | Thread Length (T) |
| 6 | 9 |
| | |

APPROVED

x
Signed approved

min 55,000 psi yield
80,000 psi tensile