


NOTE:
 NF = NEAR FACE
 FF = FAR FACE
 EF = EACH FACE
 ▲ = CUT TO FIT IN FIELD
 3" CLEAR, UNLESS OTHERWISE SPECIFIED ON THE PLANS.
 2'-2" BAR LAP UNLESS OTHERWISE SPECIFIED ON THE PLANS.

ABUTMENT #2 (PCUI)

SCALE: 1/2" = 1'-0"

ELEV ALONG CL BEARING

	ABUTMENT 2
ELEV. E	329.29'
ELEV. F	329.37'
ELEV. G	332.23'
ELEV. H	332.32'

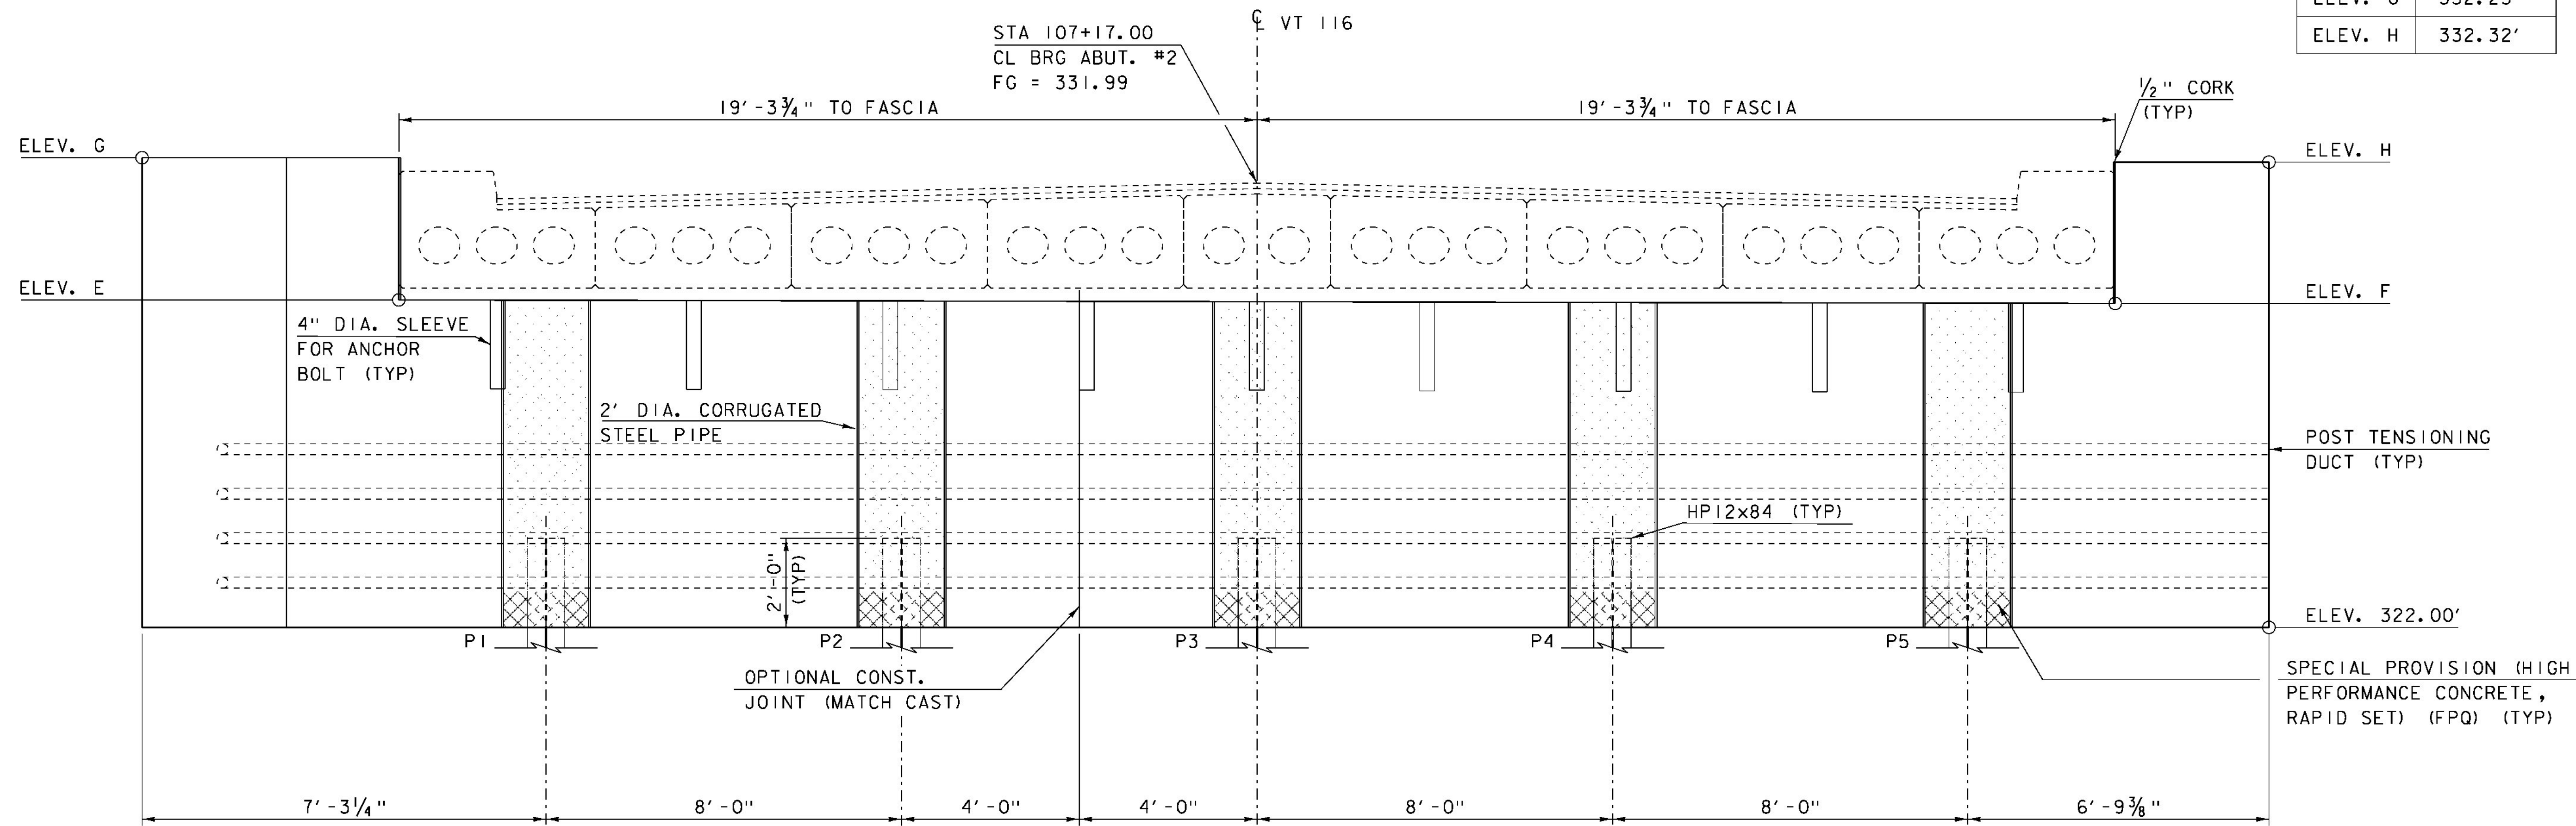

ABUTMENT #2 ELEVATION (PCUI)

SCALE: 1/2" = 1'-0"

NOTES:
 1) POST-TENSIONING AND ASSOCIATED ITEMS ONLY REQUIRED IF PRECAST ABUTMENT IS CONSTRUCTED IN MORE THAN ONE PIECE.

PROJECT NAME: BRISTOL	PLOT DATE: 24-NOV-2014
PROJECT NUMBER: BRF 021-I(29)	DRAWN BY: R. PELLETT
FILE NAME: si0b094sub.dgn	CHECKED BY: EVANS-MONGEON
PROJECT LEADER: C. CARLSON	SHEET 31 OF 54
DESIGNED BY: C. MOONEY	
ABUTMENT #2 DETAILS	