



104+00


STA 104+00.00
BEGIN APPROACH
MATCH EXISTING

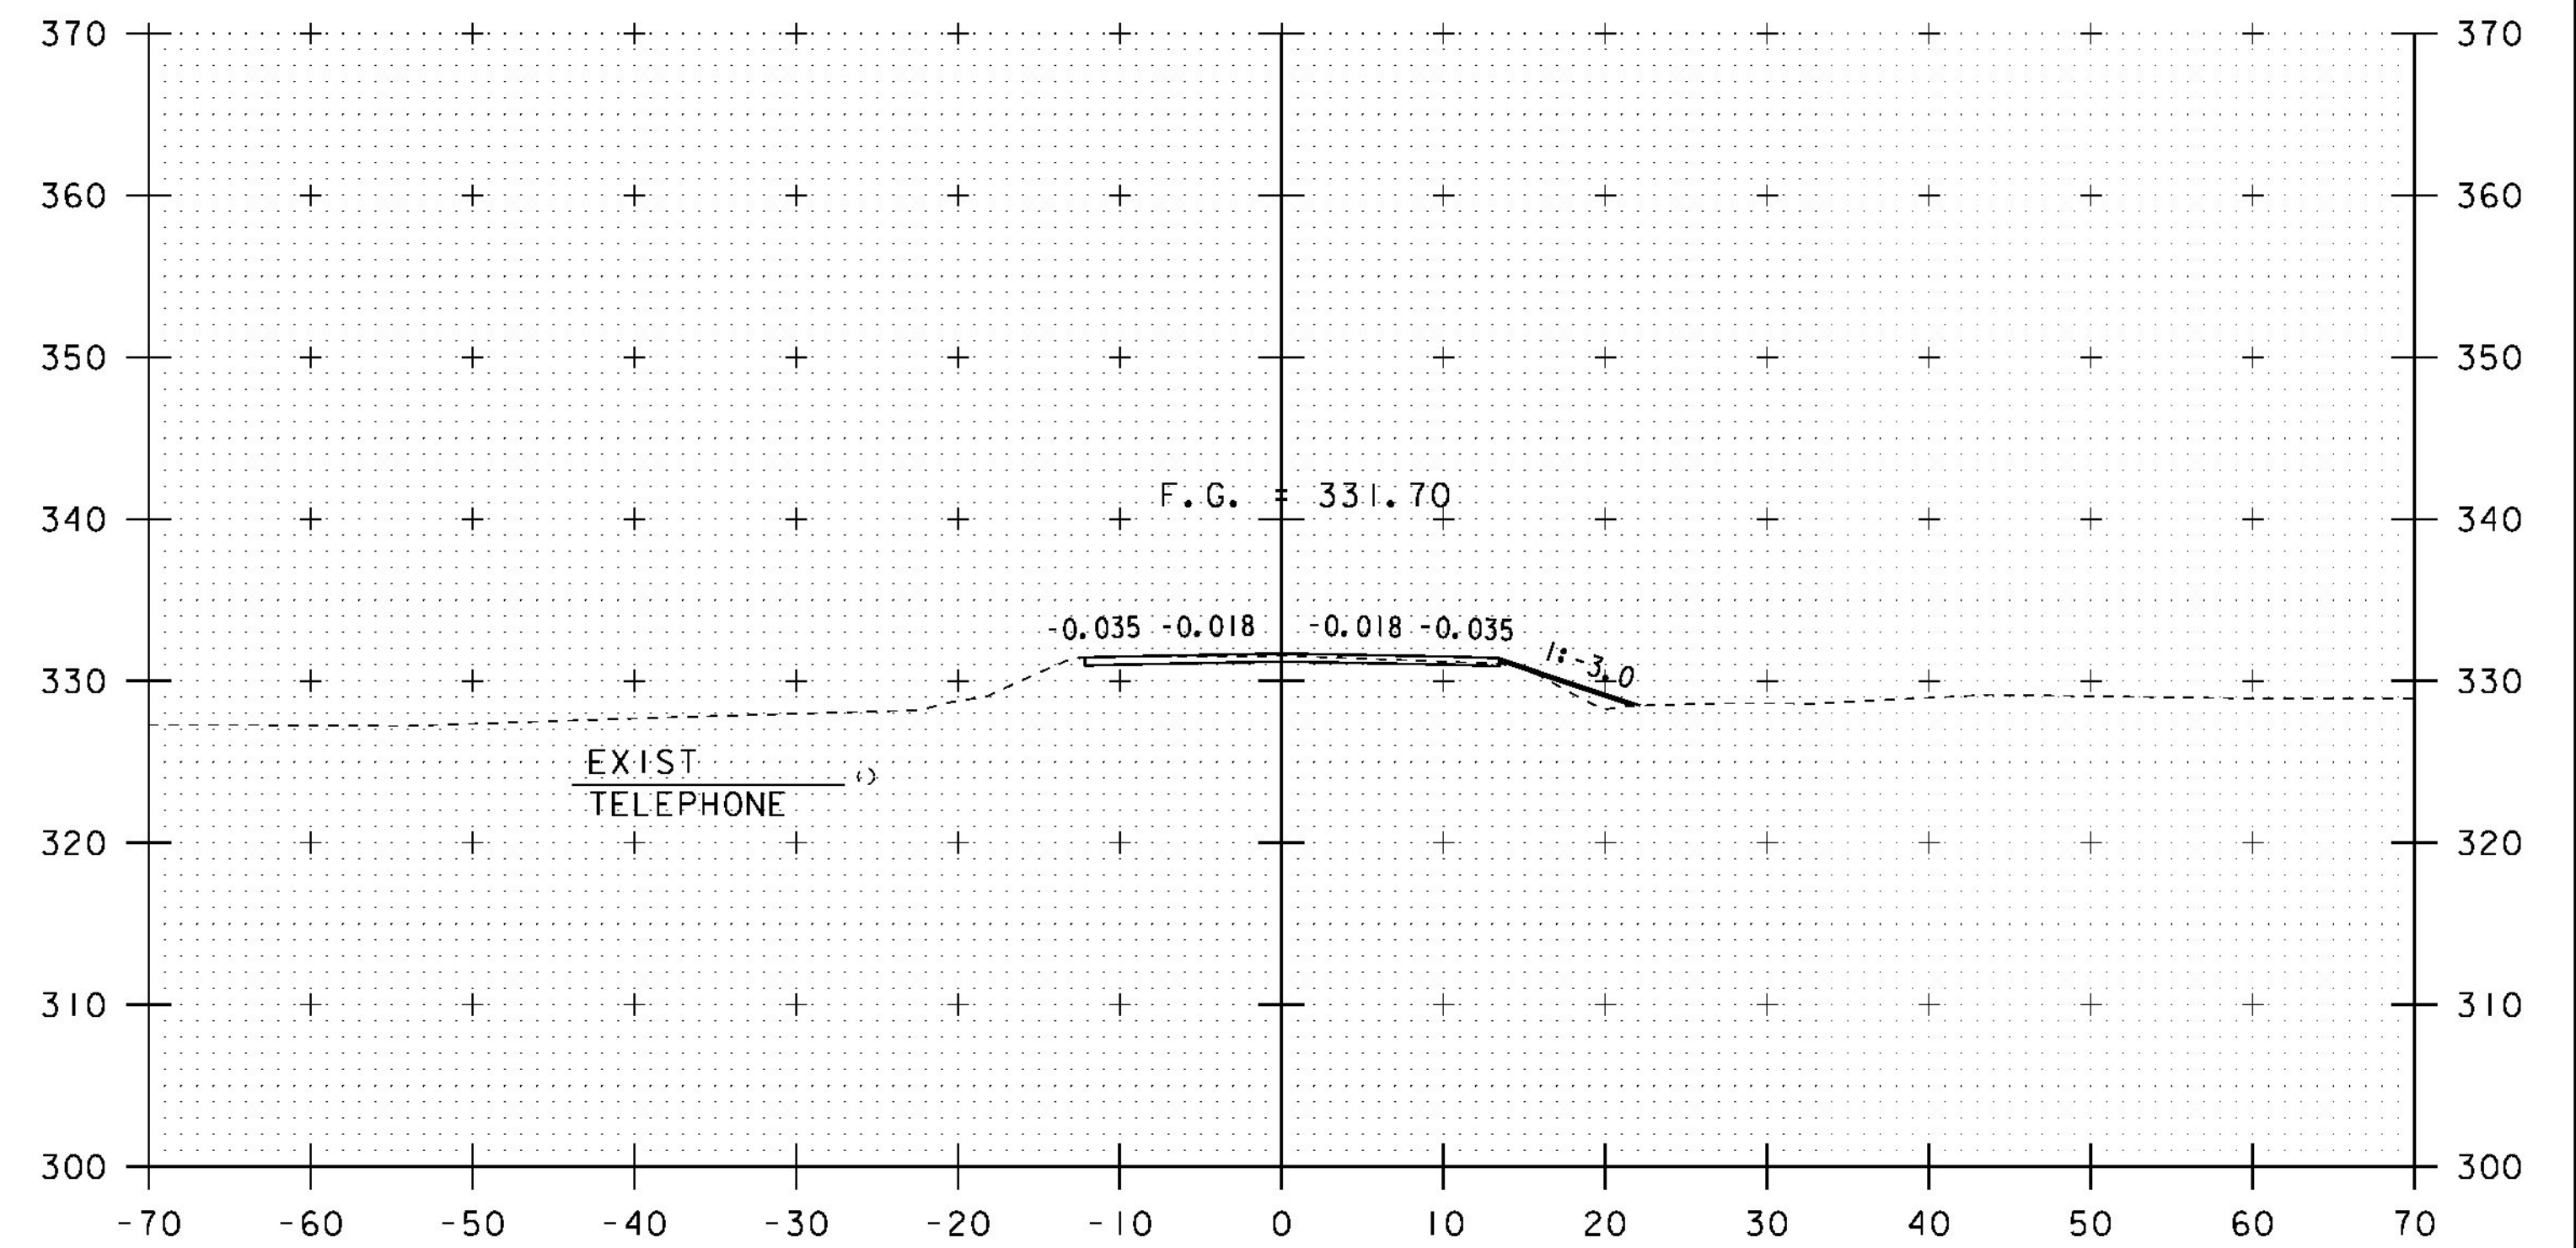


104+50

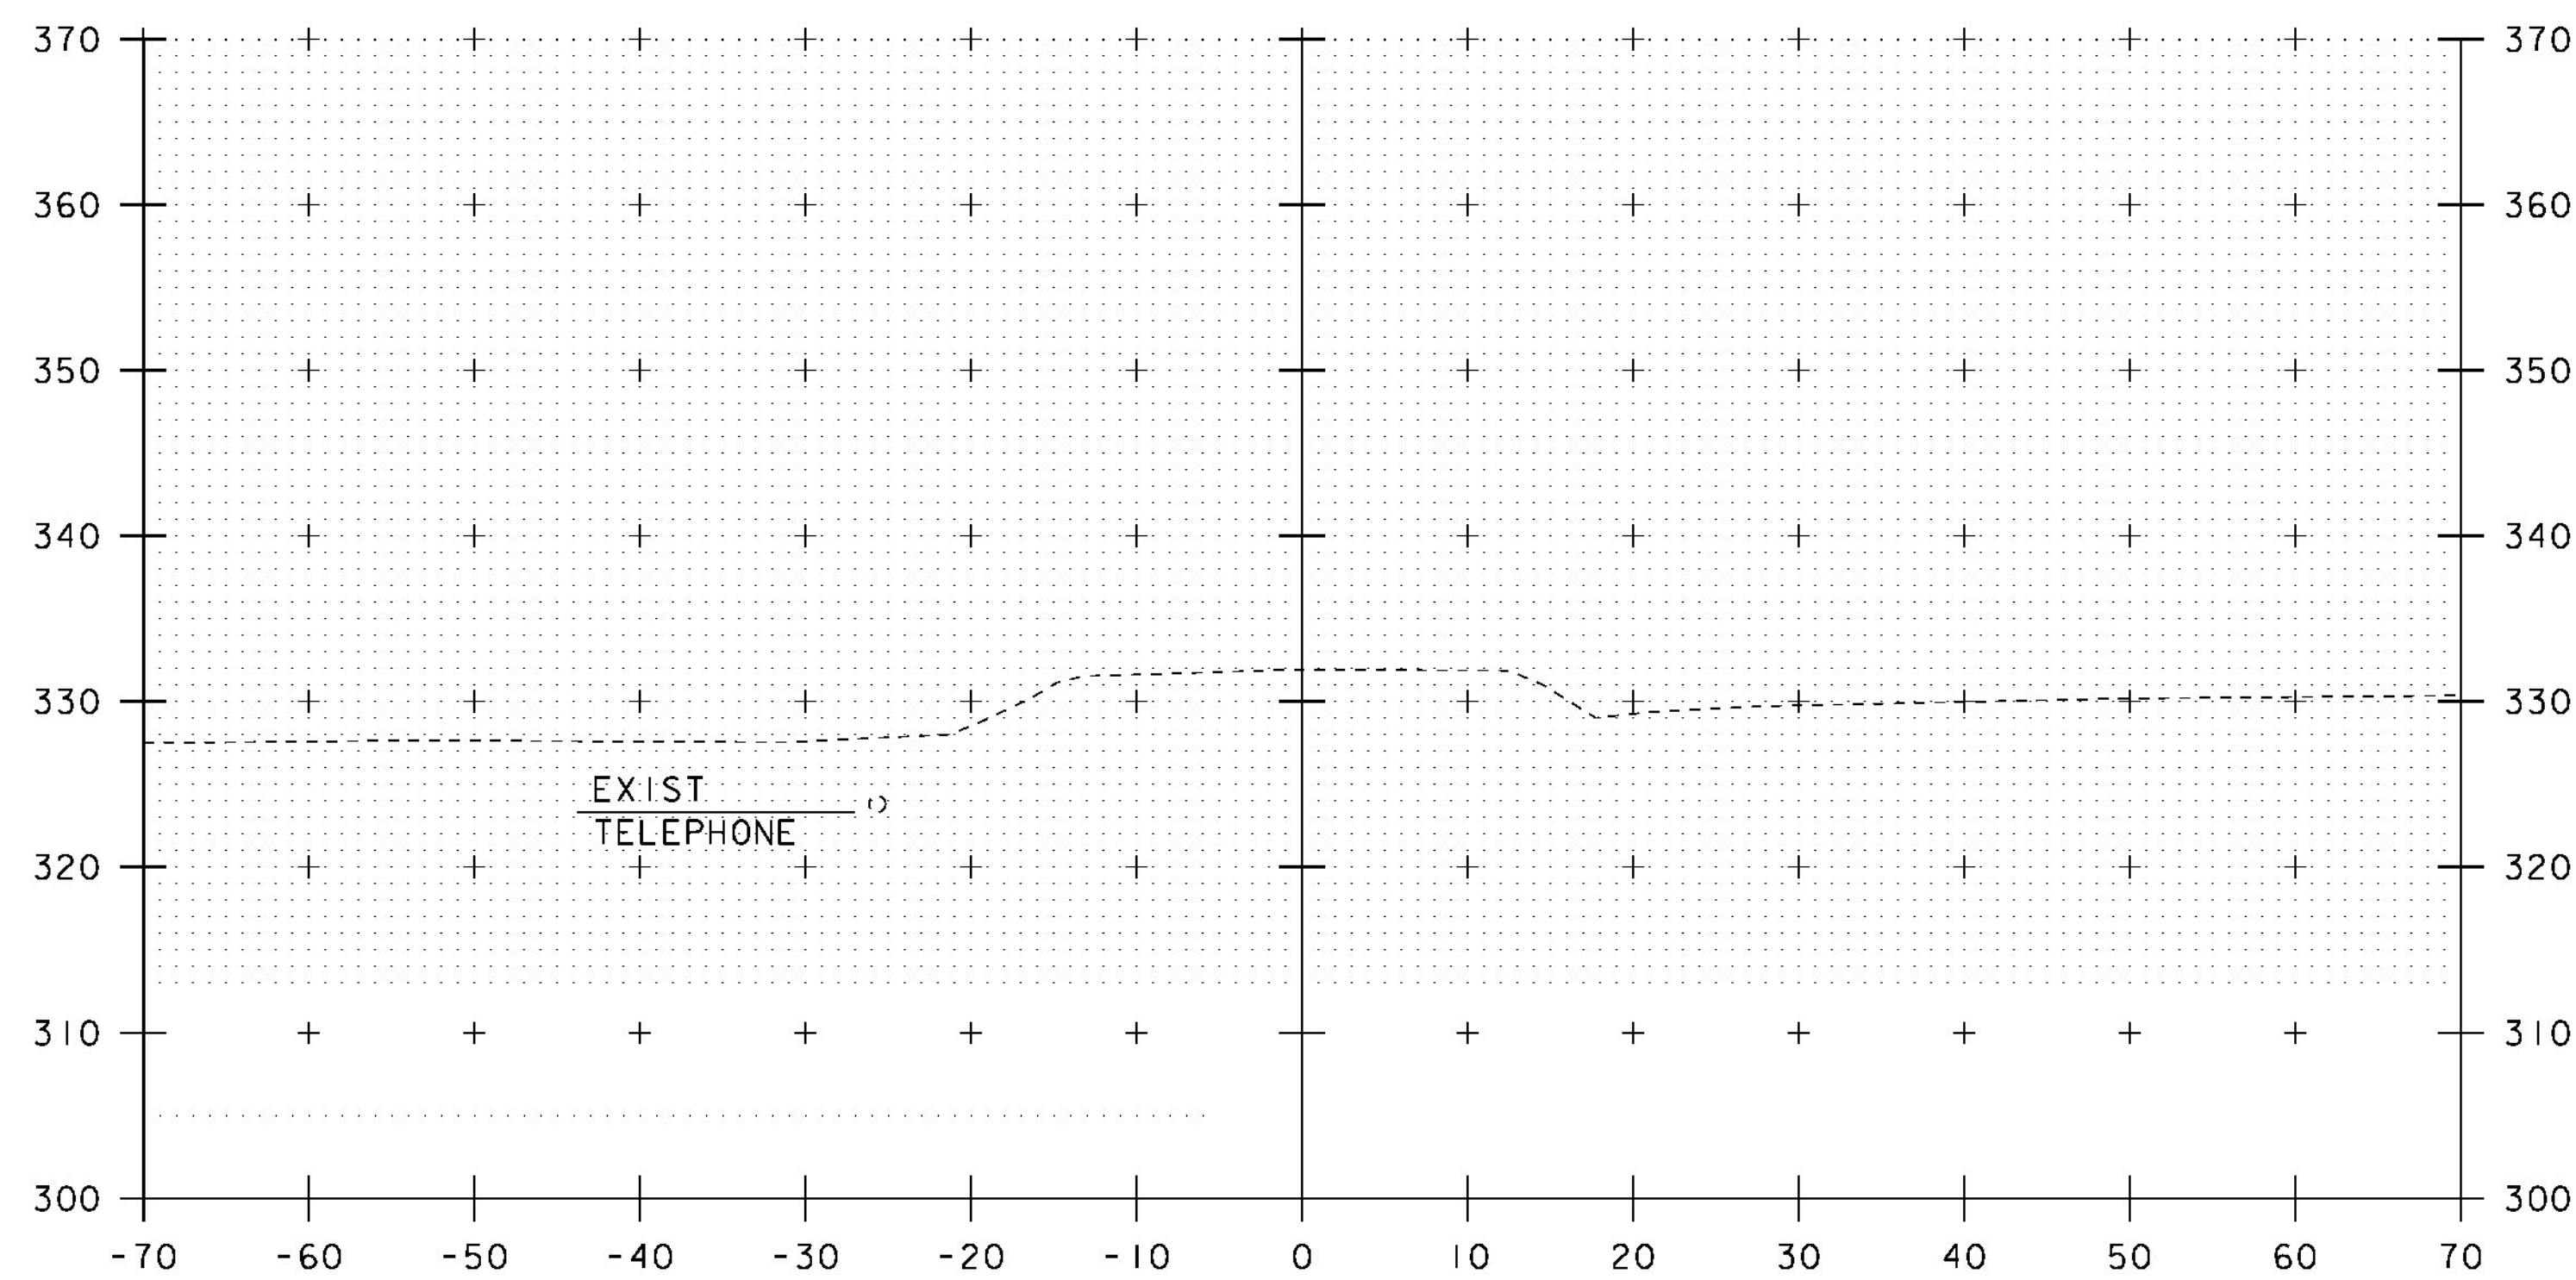

103+75

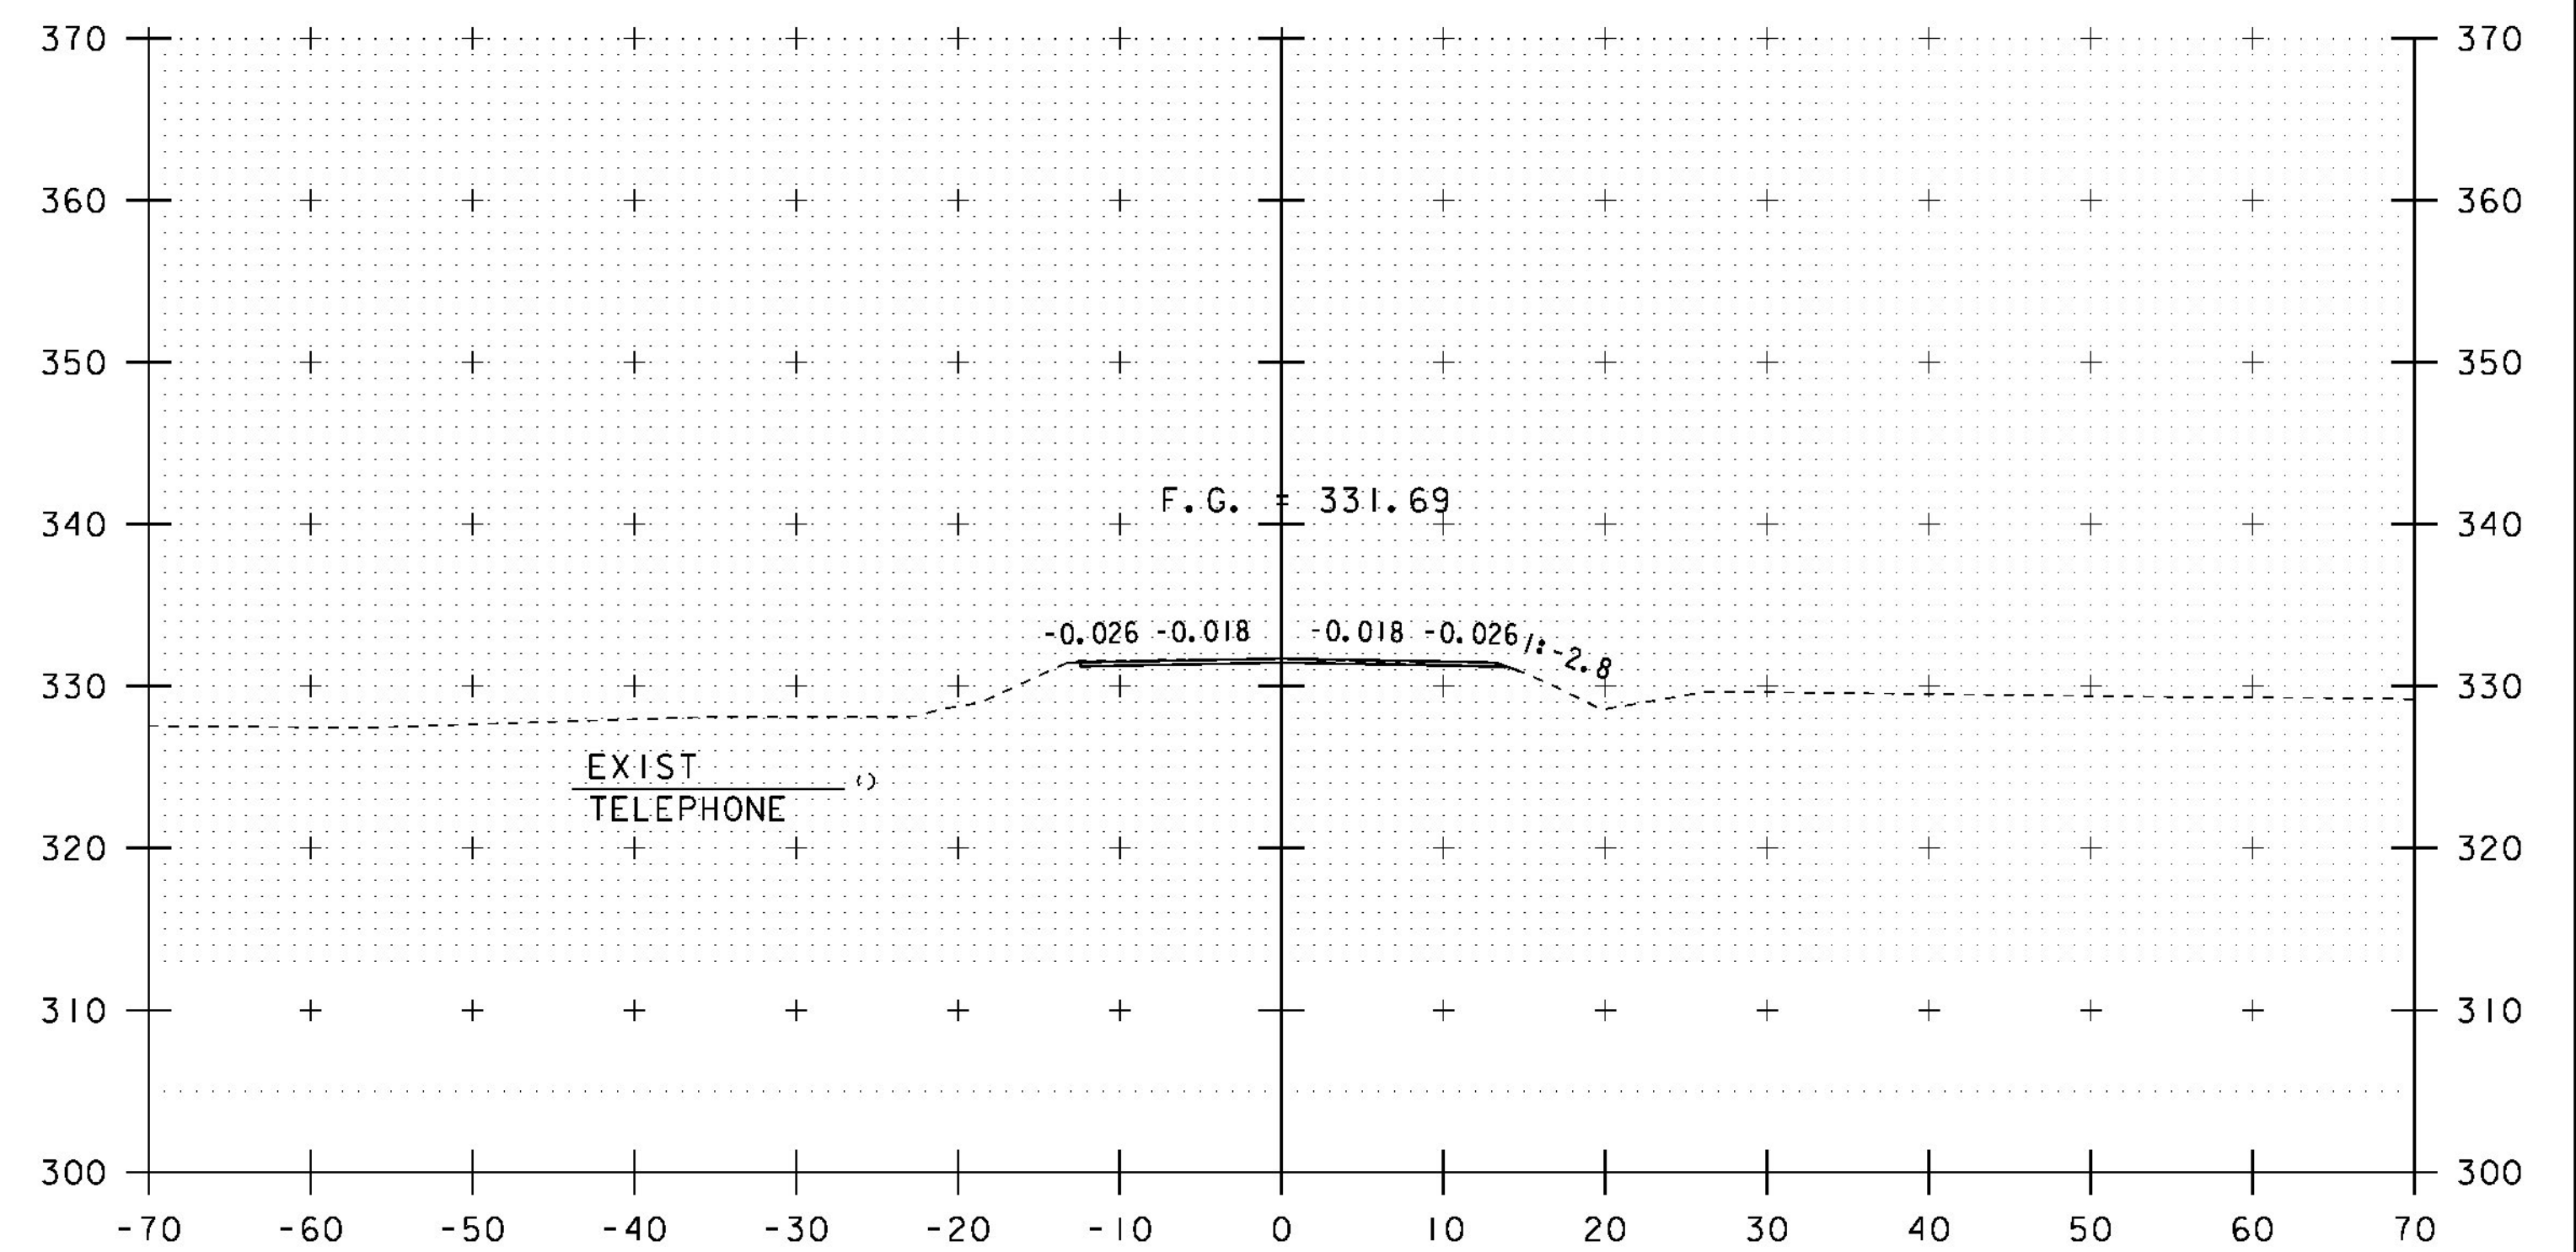

104+25

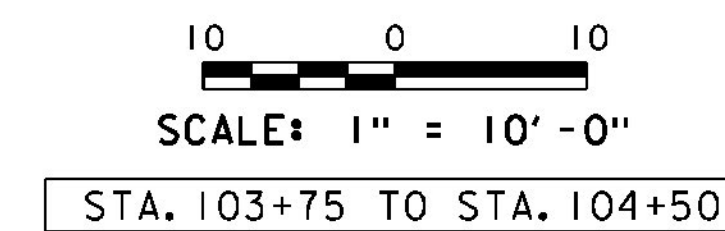

PROJECT NAME: BRISTOL	PLOT DATE: 04-NOV-2014
PROJECT NUMBER: BRF 021-1(29)	DRAWN BY: C. ROY
FILE NAME: si0b094xsl.dgn	CHECKED BY: EVANS-MONGEON
PROJECT LEADER: C. CARLSON	SHEET 35 OF 54
DESIGNED BY: G. ROY	
VT 116 CROSS SECTIONS (1)	