




105+00

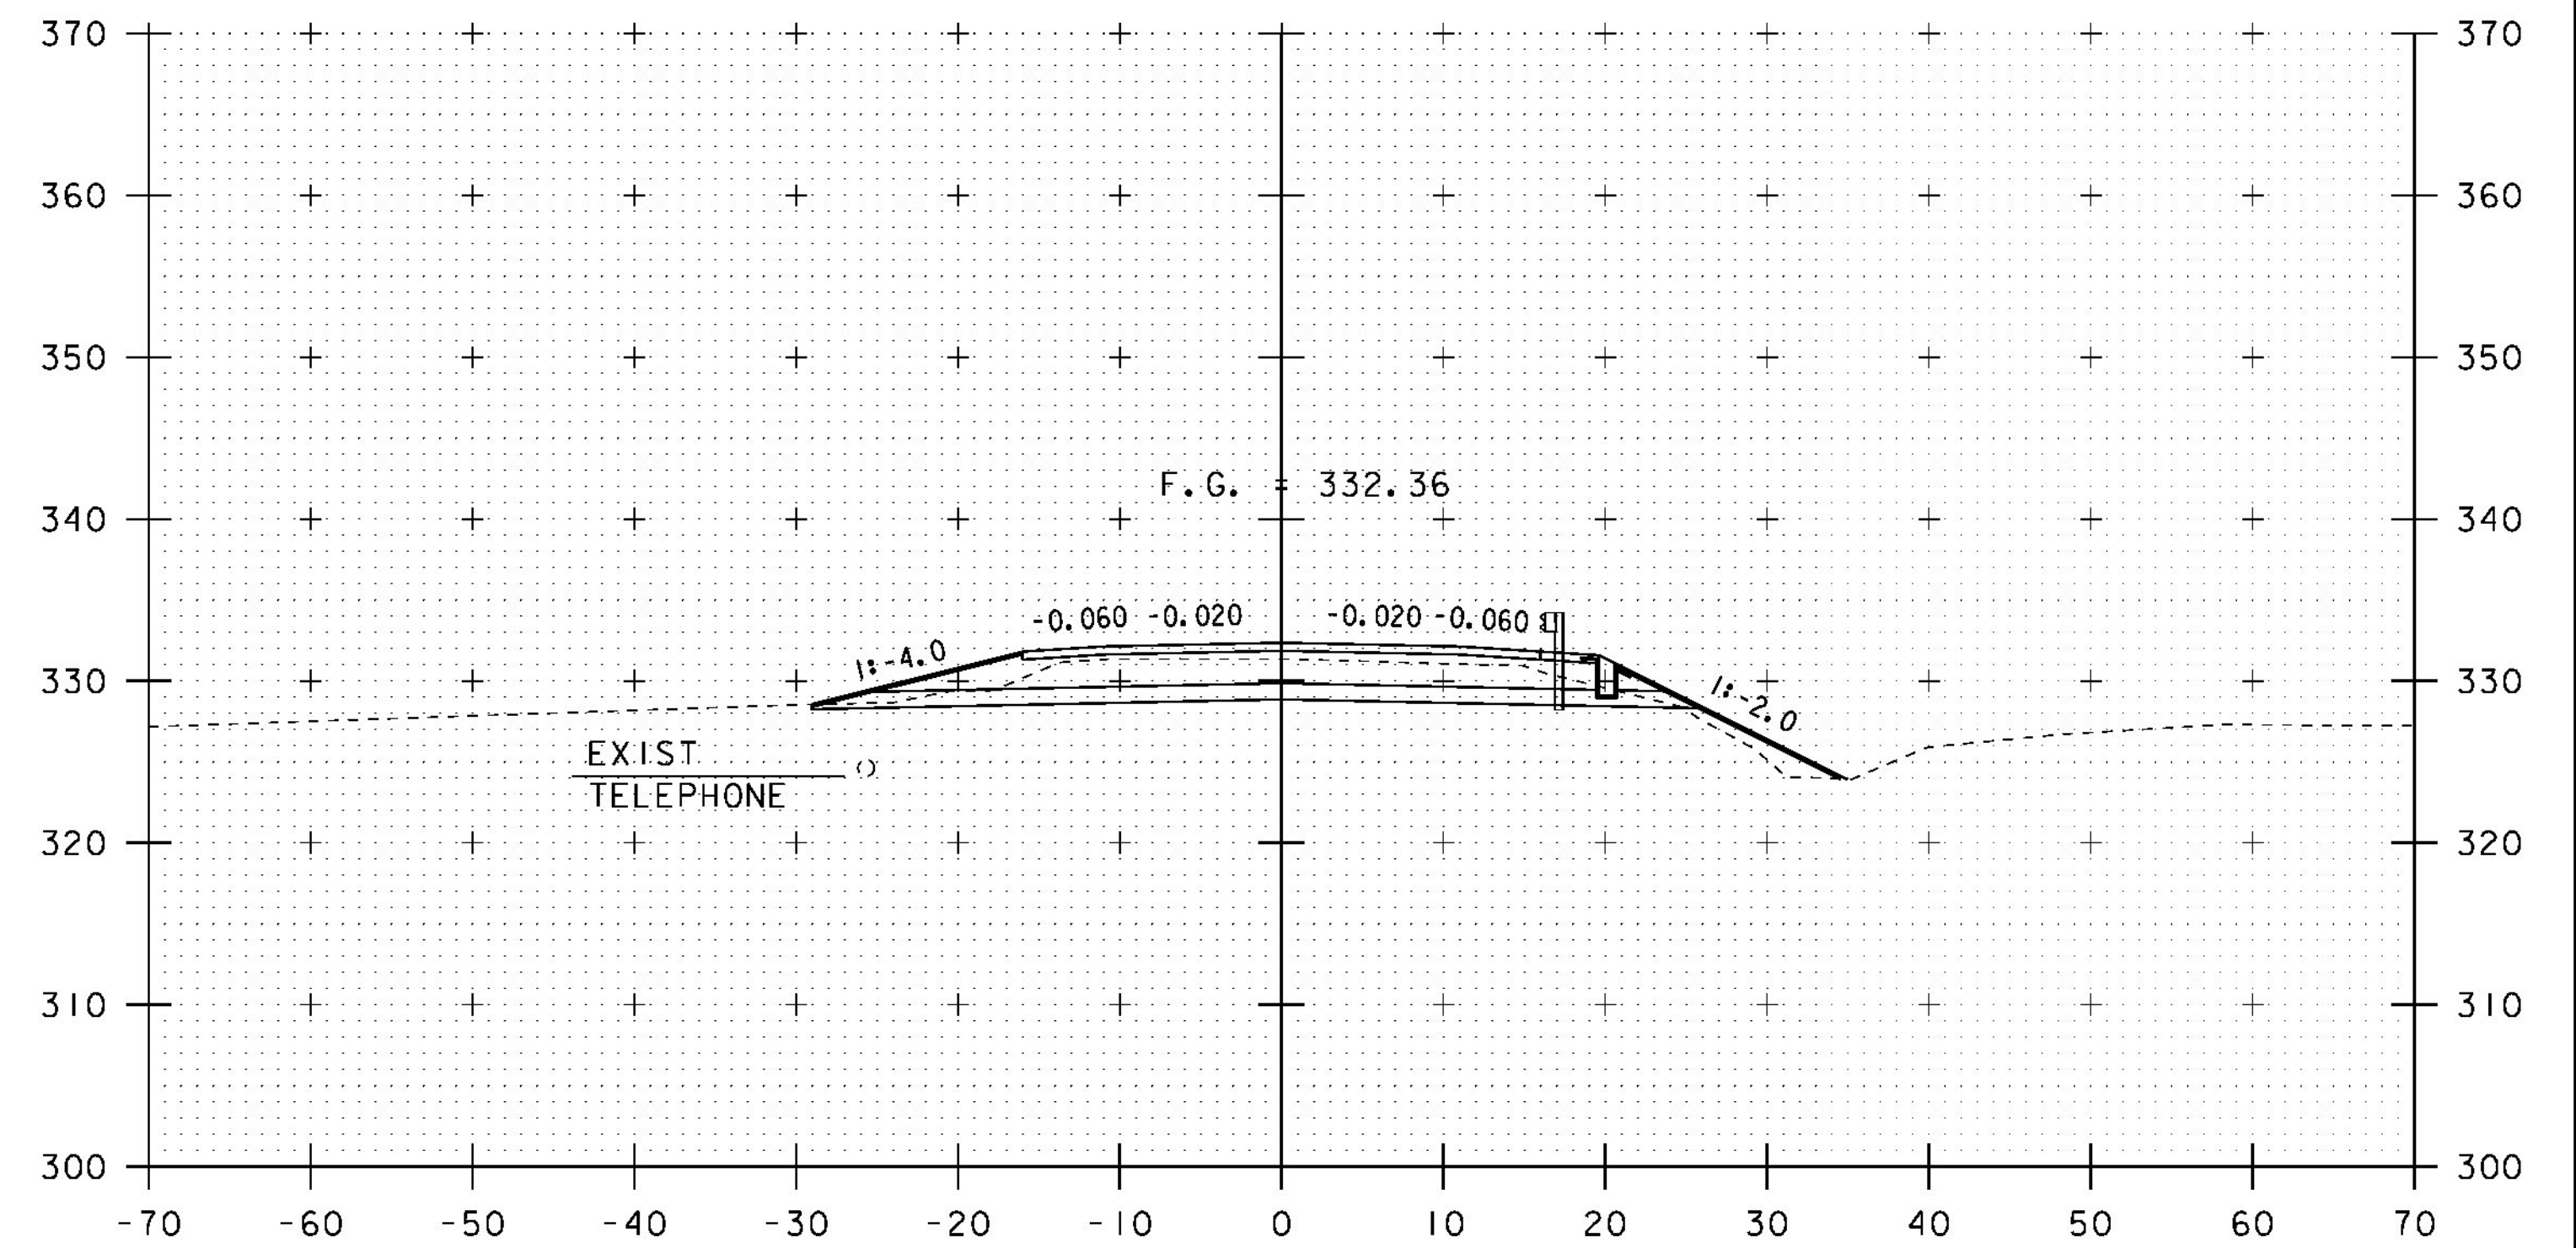

105+50

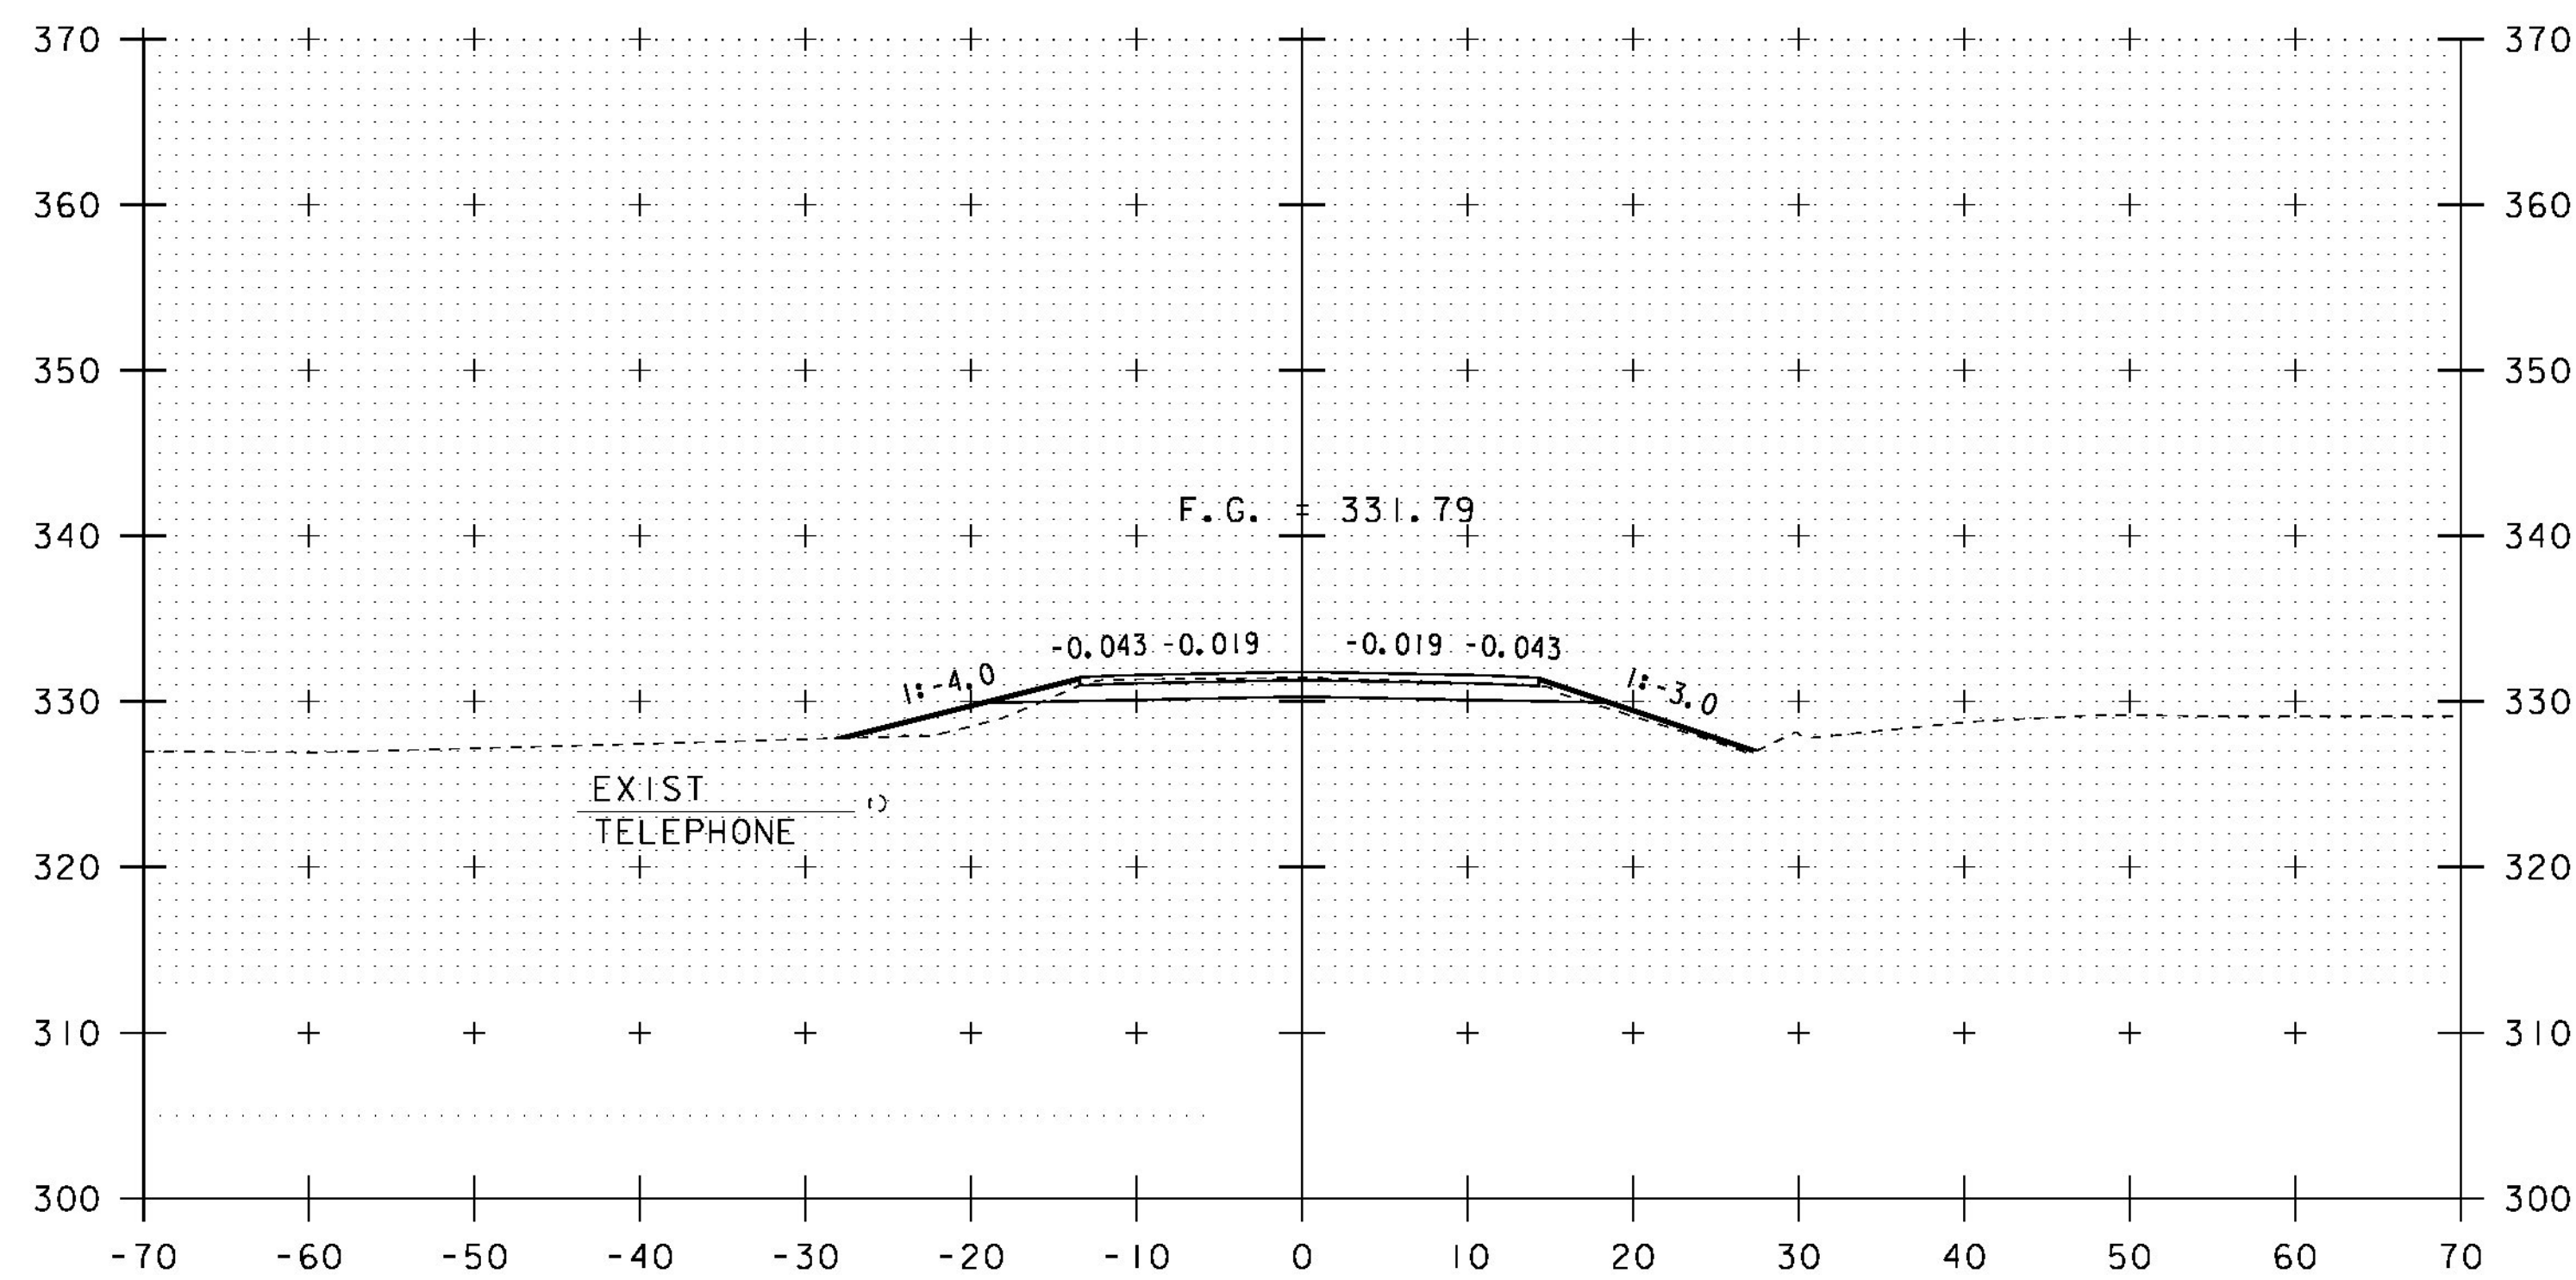

104+75

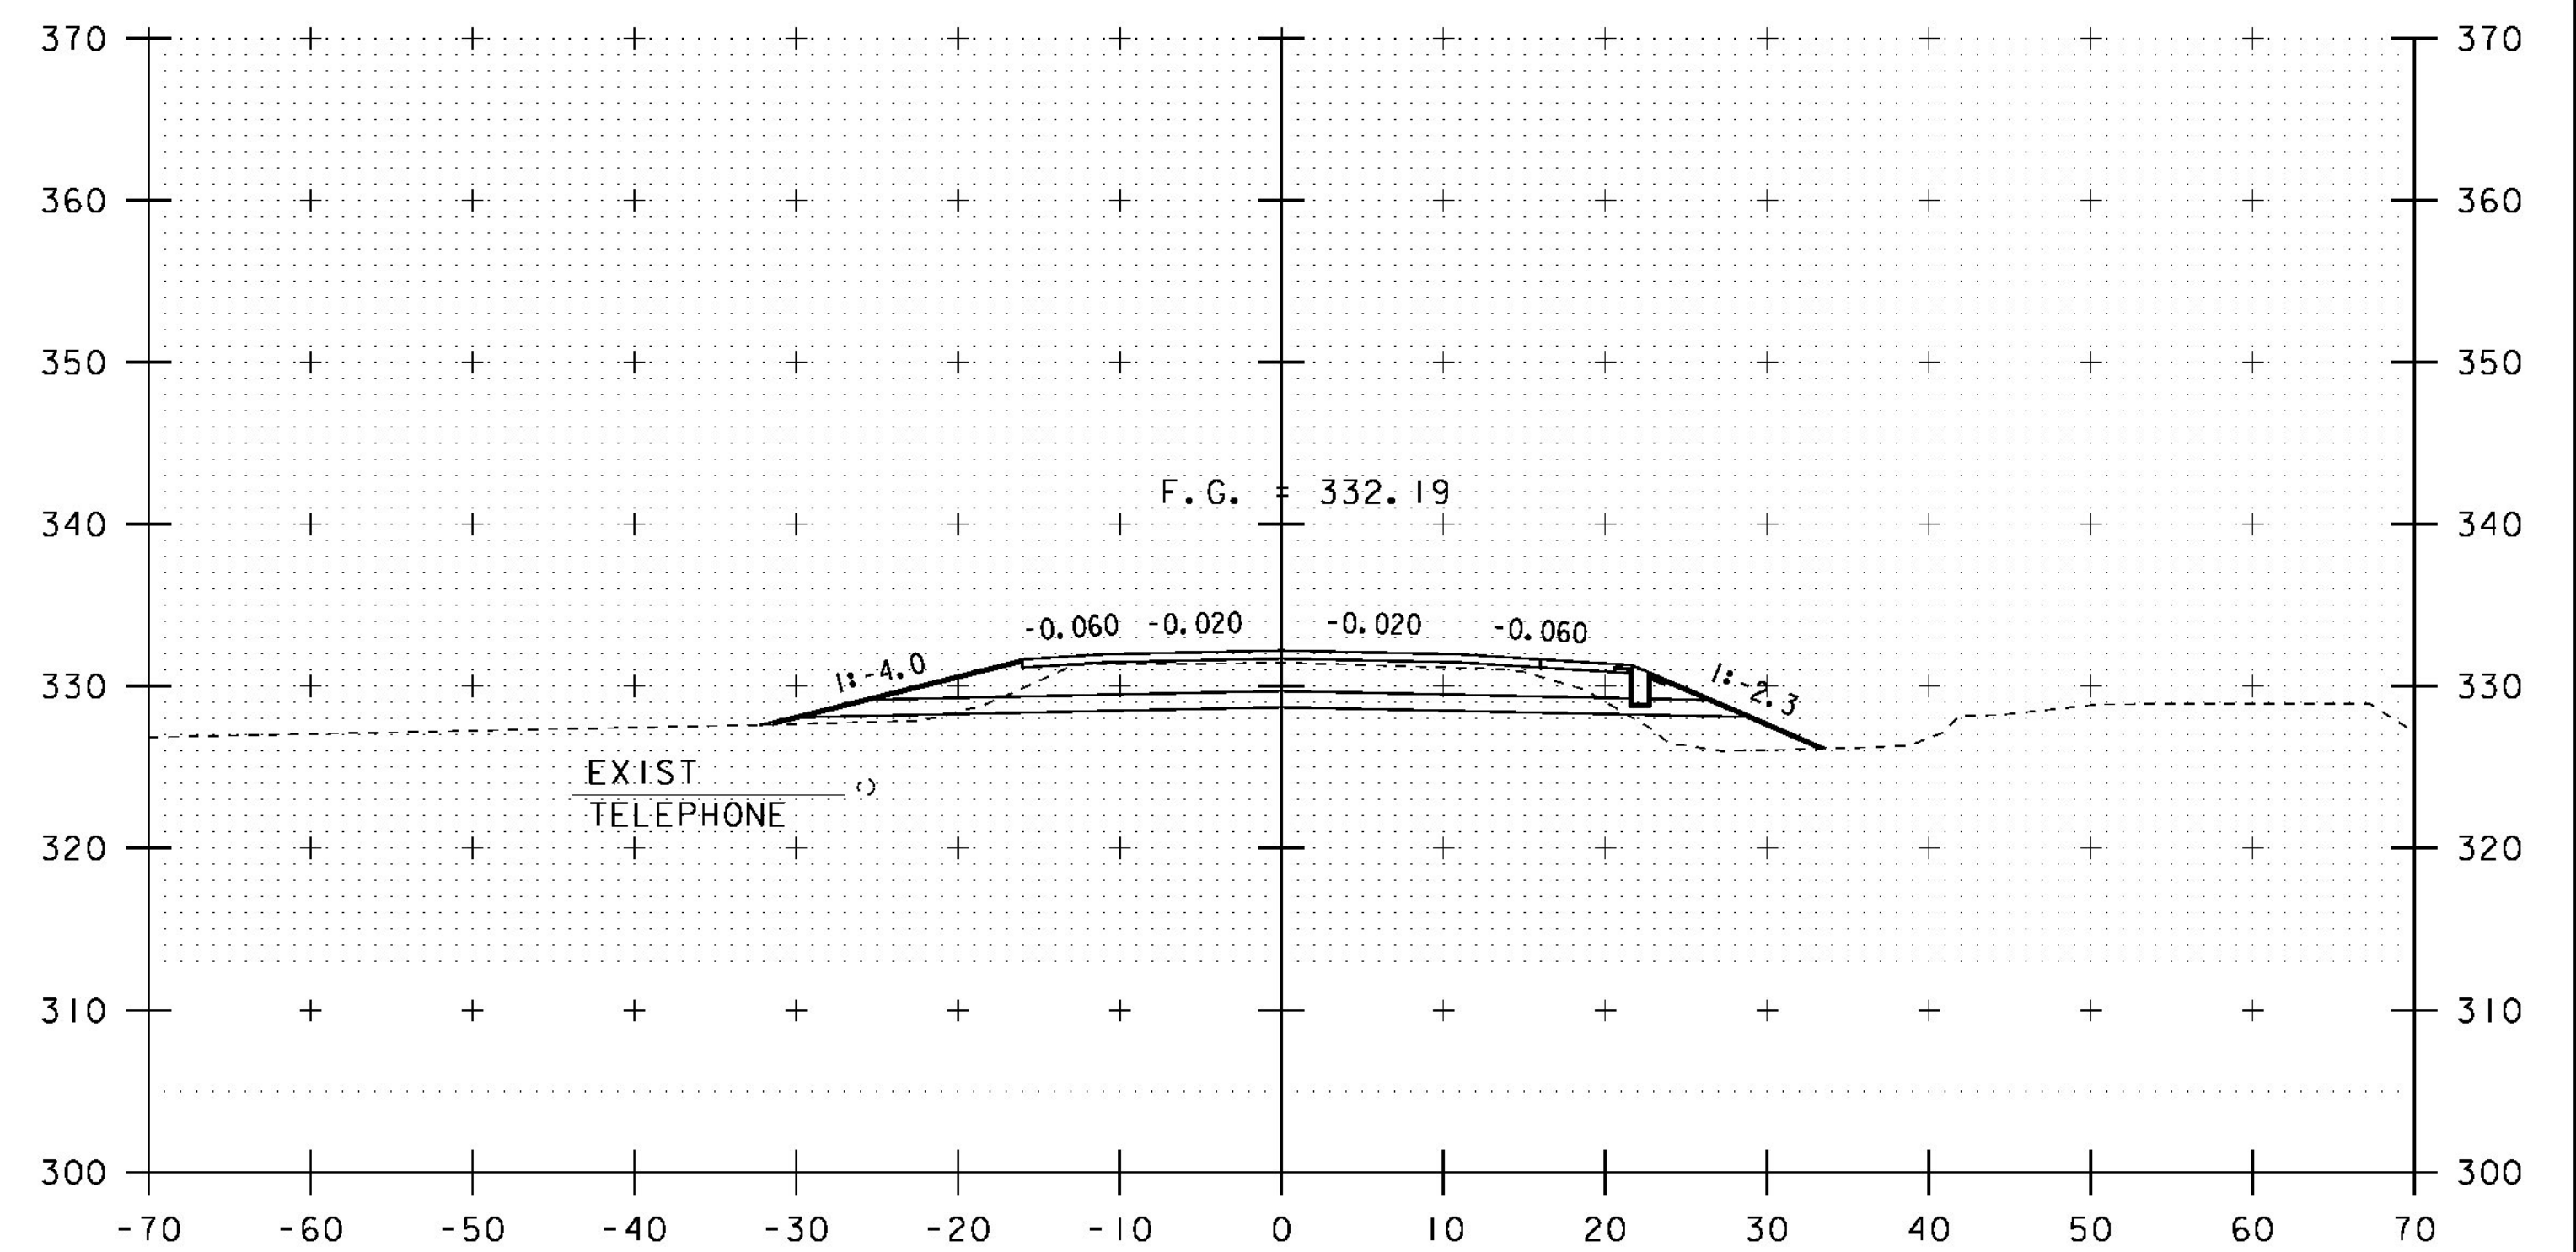

105+25

SPECIAL PROVISION (STONE DIAPHRAGM)
STA 105+25.0 RT - STA 106+28.3 RT

STA 105+25.00
END APPROACH
BEGIN PROJECT

10 0 10
SCALE: 1" = 10' - 0"

STA. 104+75 TO STA. 105+50

PROJECT NAME: BRISTOL	PLOT DATE: 04-NOV-2014
PROJECT NUMBER: BRF 021-1(29)	DRAWN BY: G. ROY
FILE NAME: si0b094xsl.dgn	CHECKED BY: EVANS-MONGEON
PROJECT LEADER: C. CARLSON	SHEET 36 OF 54
DESIGNED BY: G. ROY	
VT 116 CROSS SECTIONS (2)	