




SPECIAL PROVISION (STONE DIAPHRAGM)
 STA 105+94.9 LT - STA 106+42.7 LT
 106+00
 CONSTRUCT GRAVEL DRIVE
 STA 105+83.0 LT

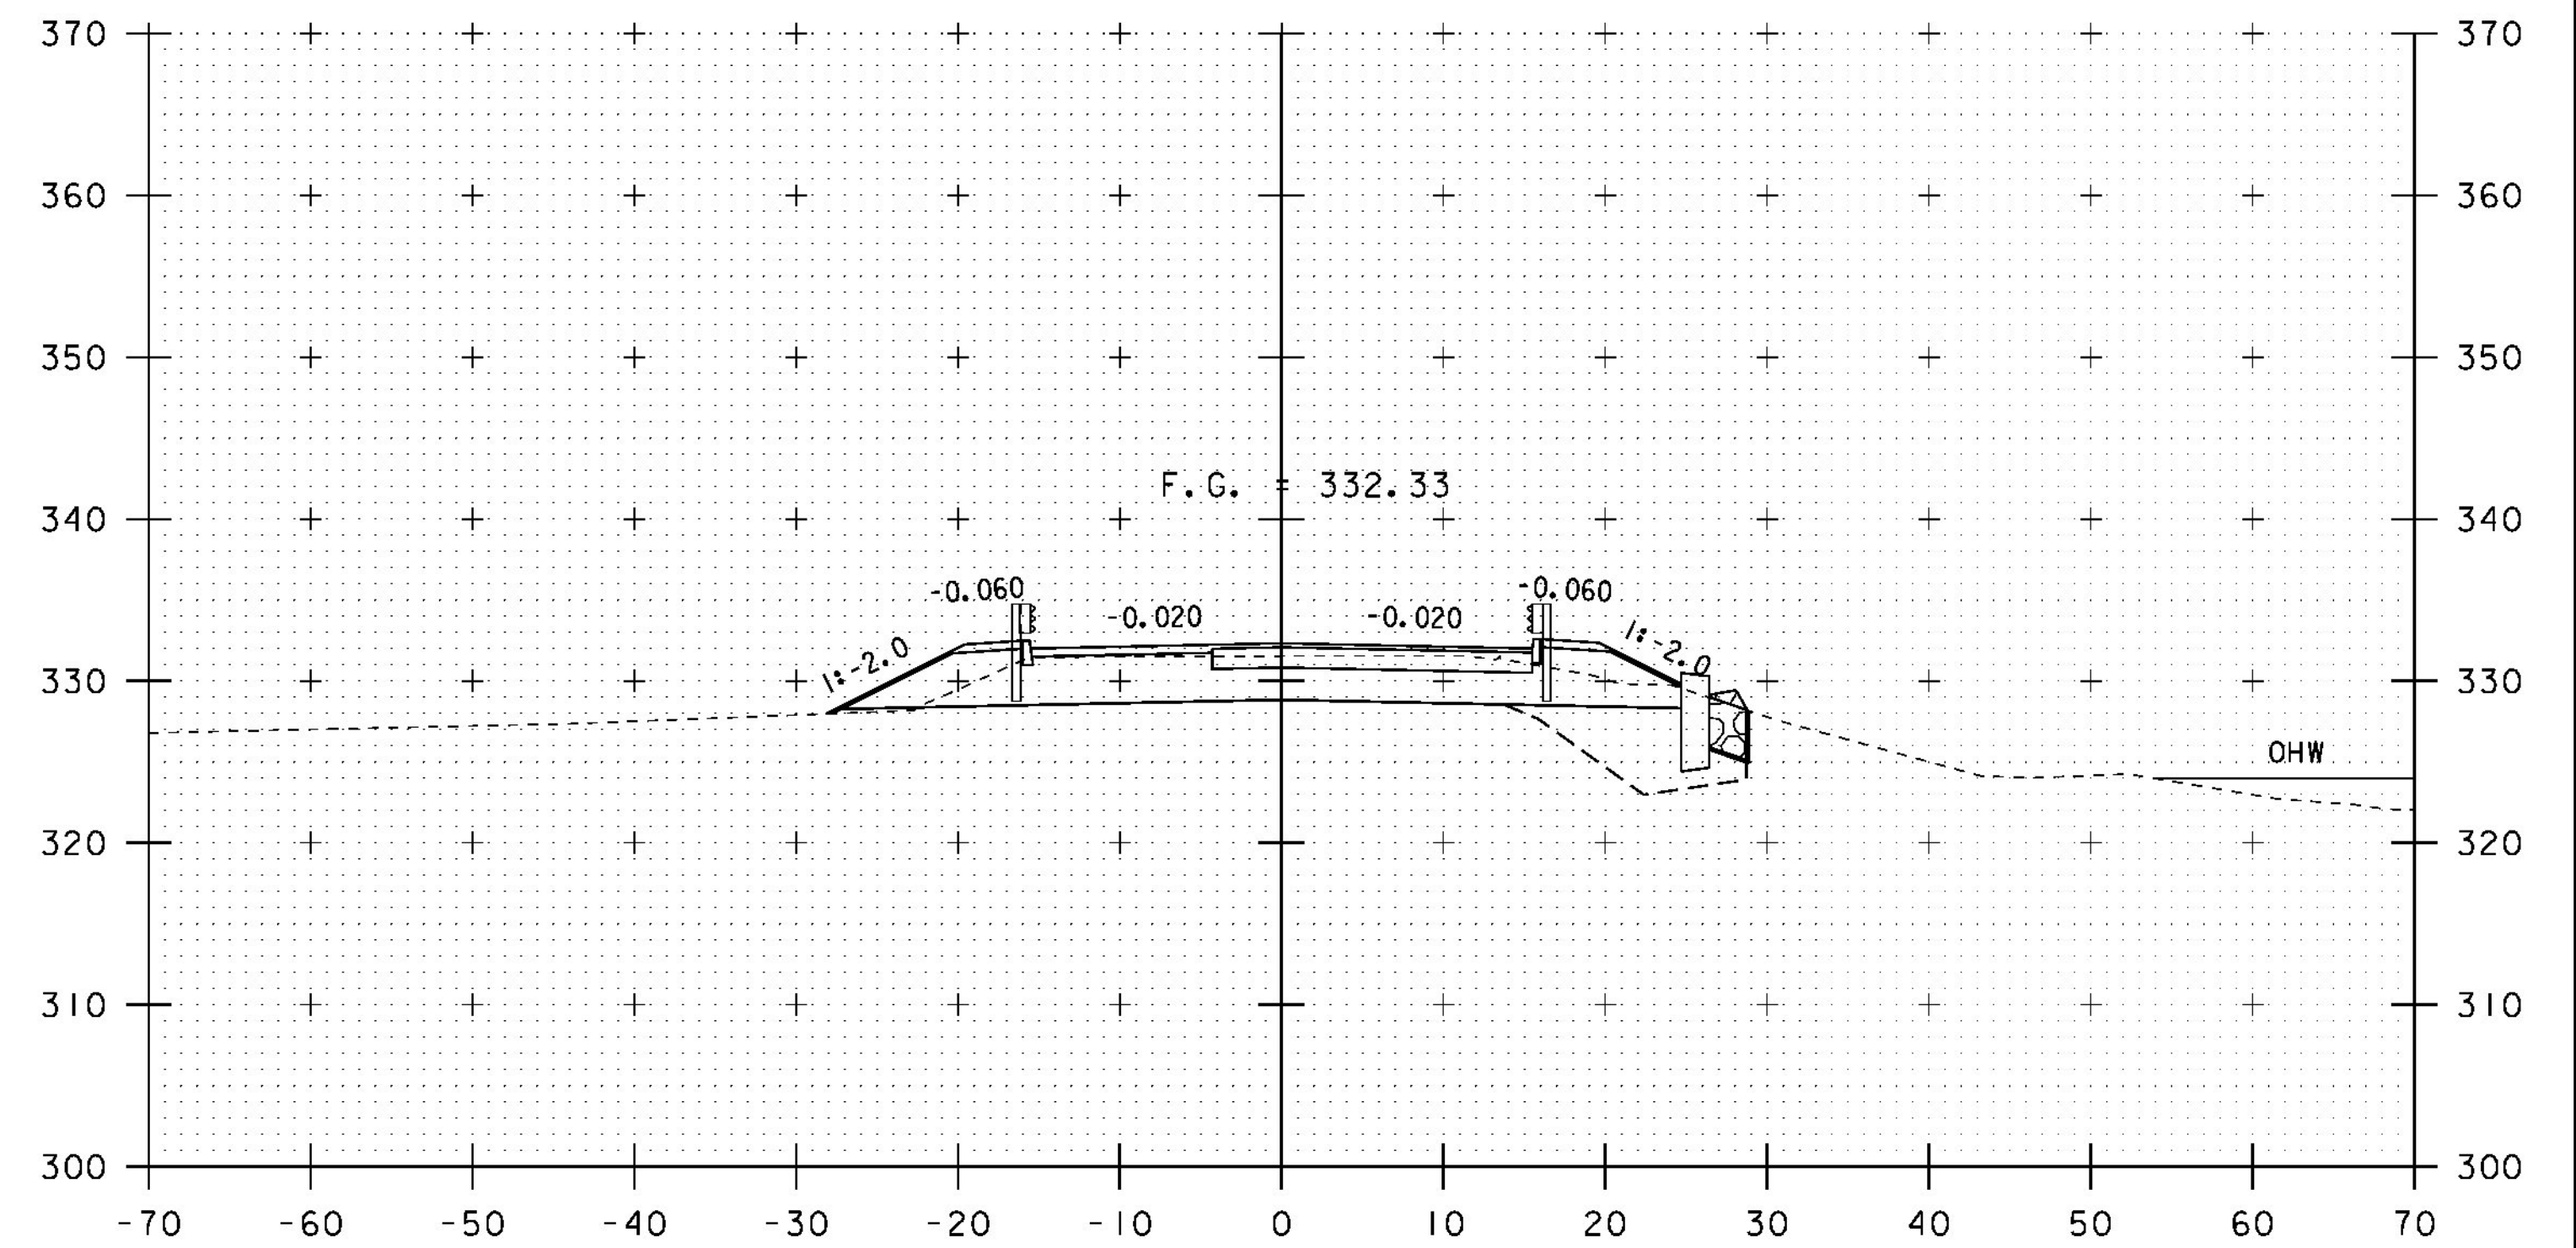


106+50

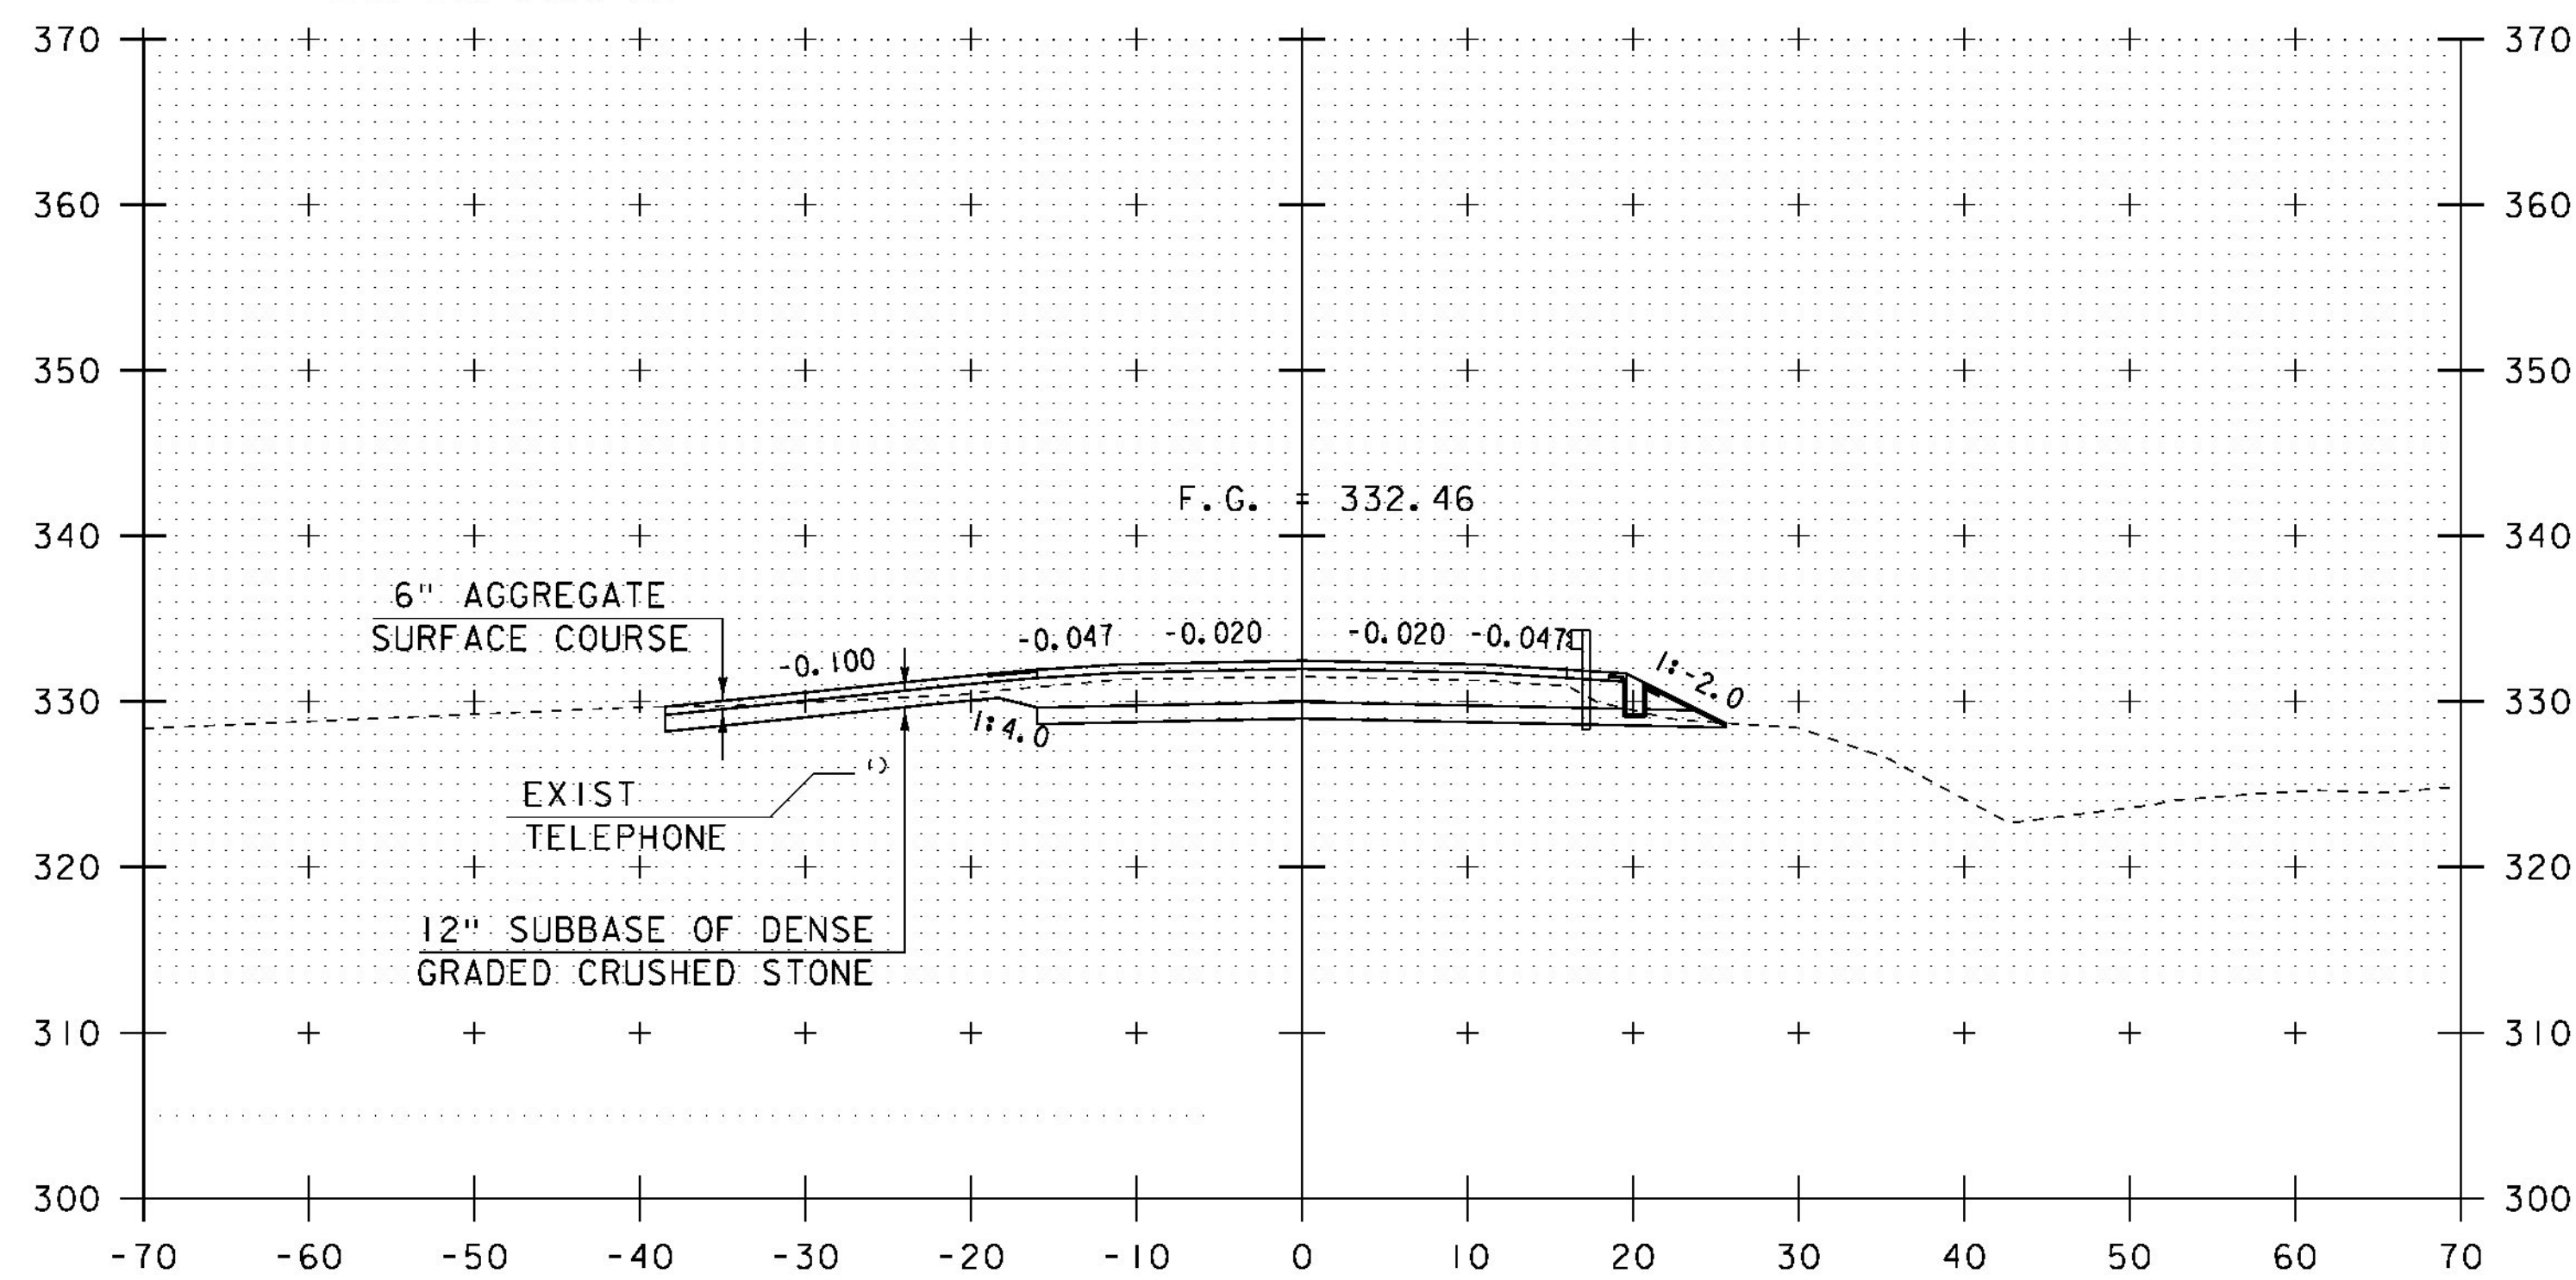

105+75

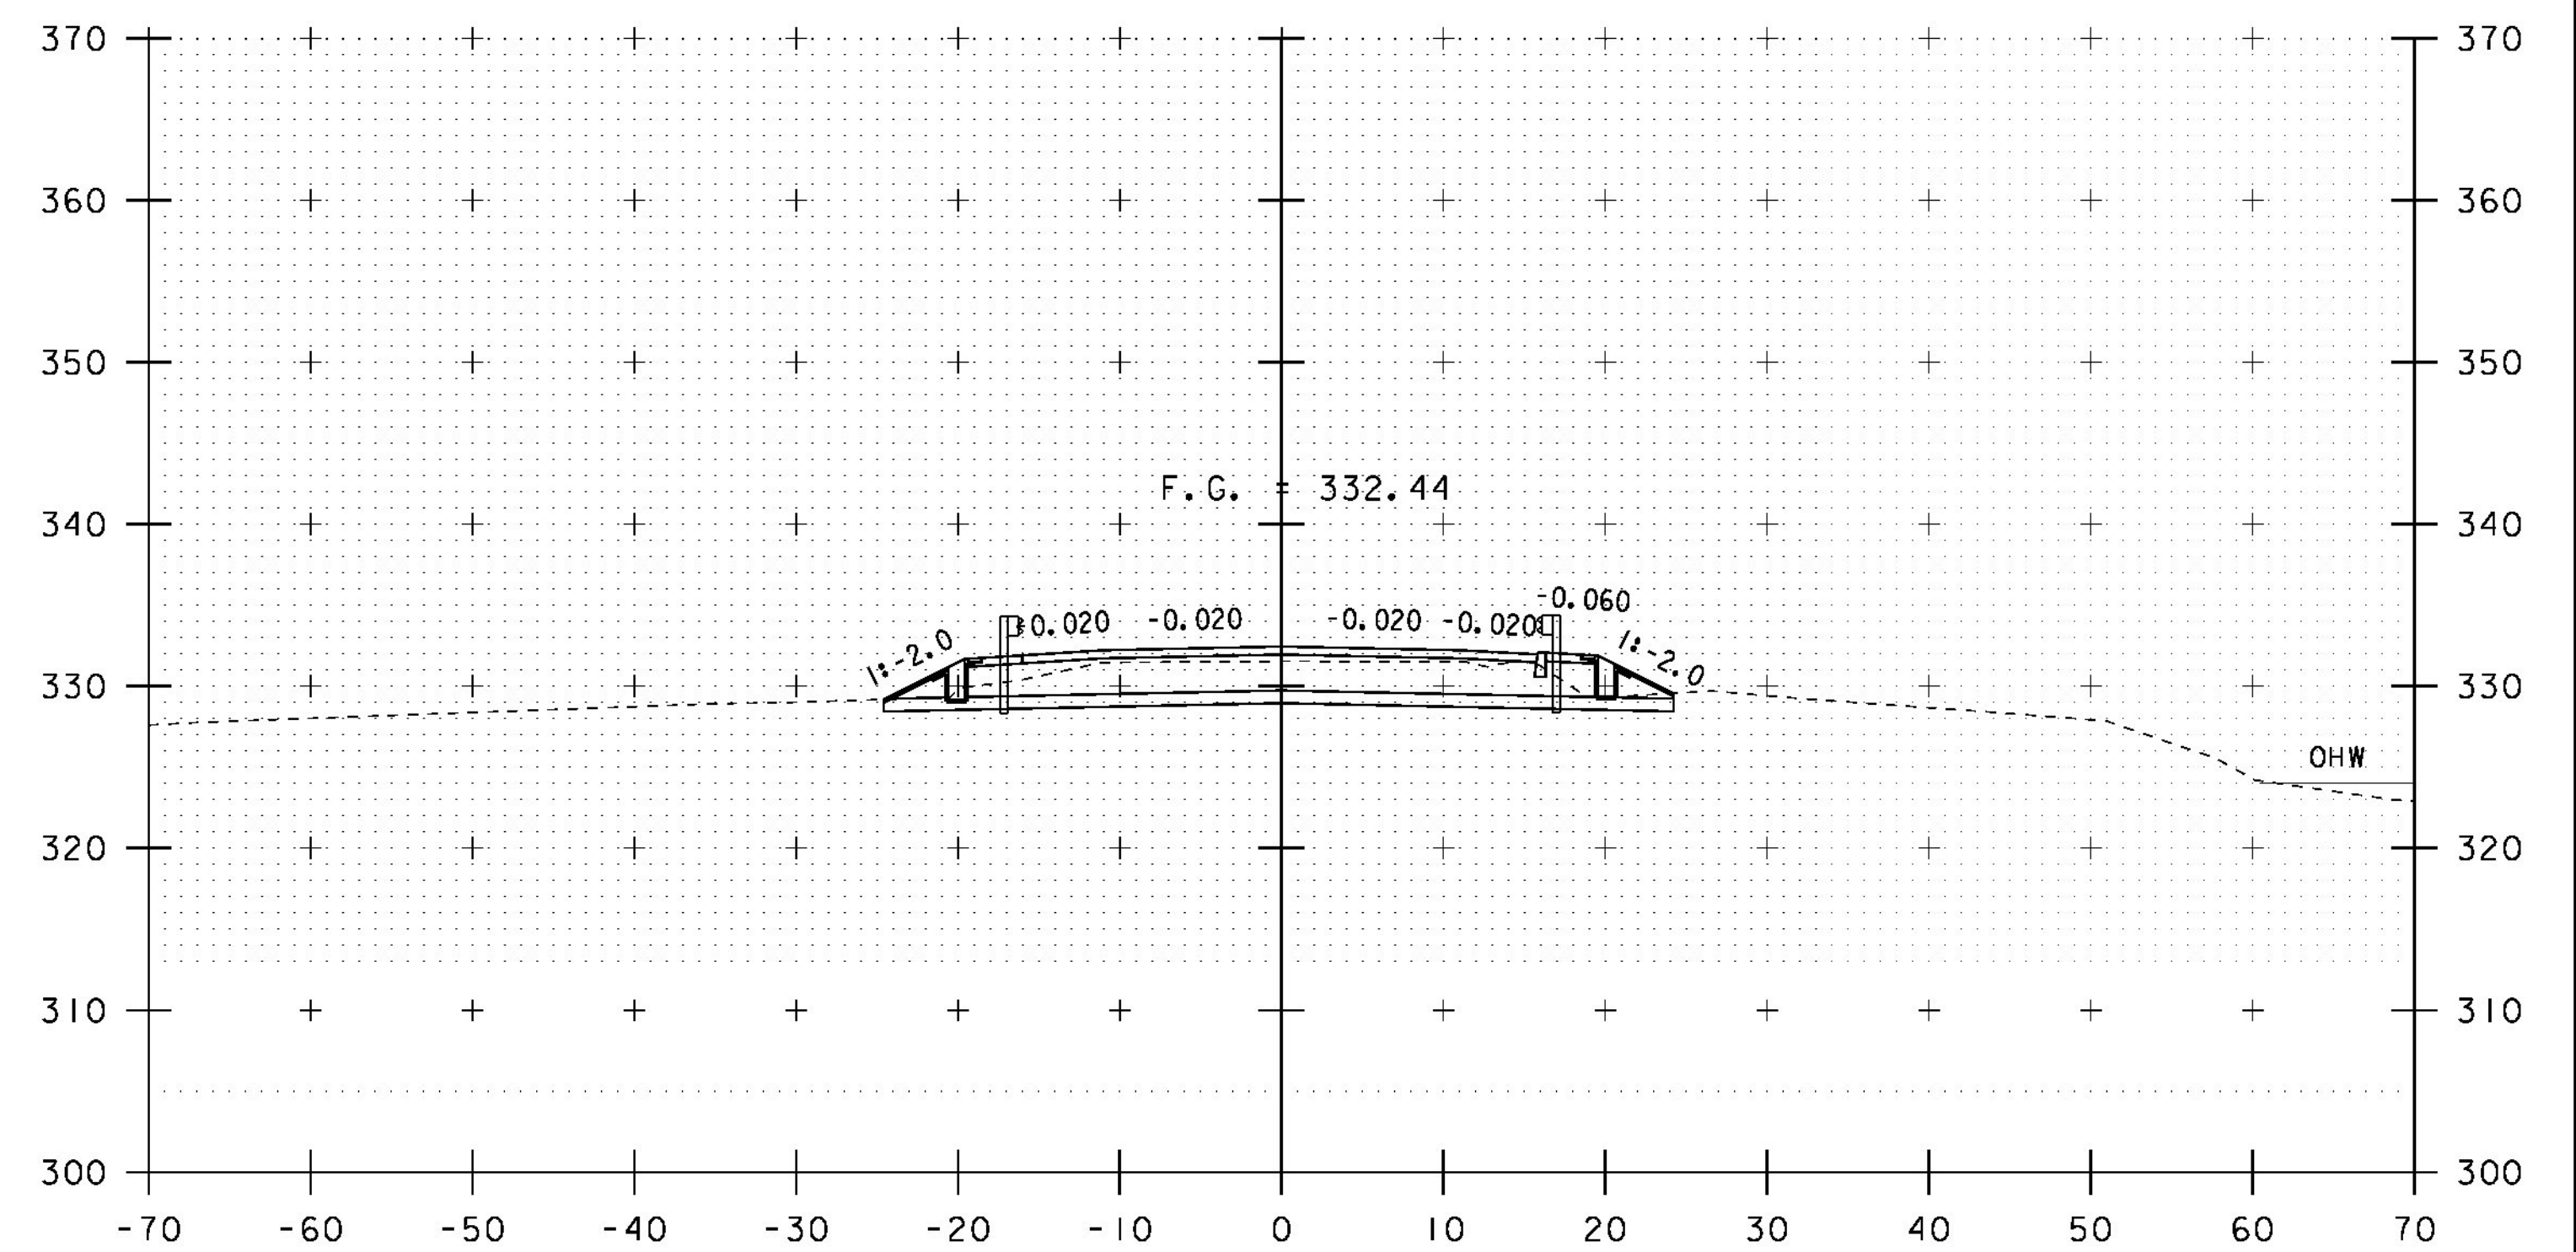

106+25

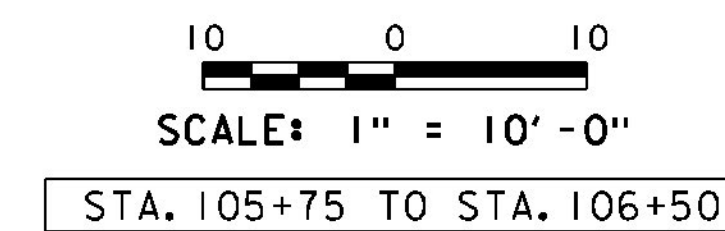

STA. 105+75 TO STA. 106+50

PROJECT NAME: BRISTOL	PLOT DATE: 04-NOV-2014
PROJECT NUMBER: BRF 021-1(29)	DRAWN BY: G. ROY
FILE NAME: si0b094xsl.dgn	CHECKED BY: EVANS-MONGEON
PROJECT LEADER: C. CARLSON	SHEET 37 OF 54
DESIGNED BY: G. ROY	
VT 116 CROSS SECTIONS (3)	