



108+00

STA 108+00.00
END PROJECT
BEGIN APPROACH

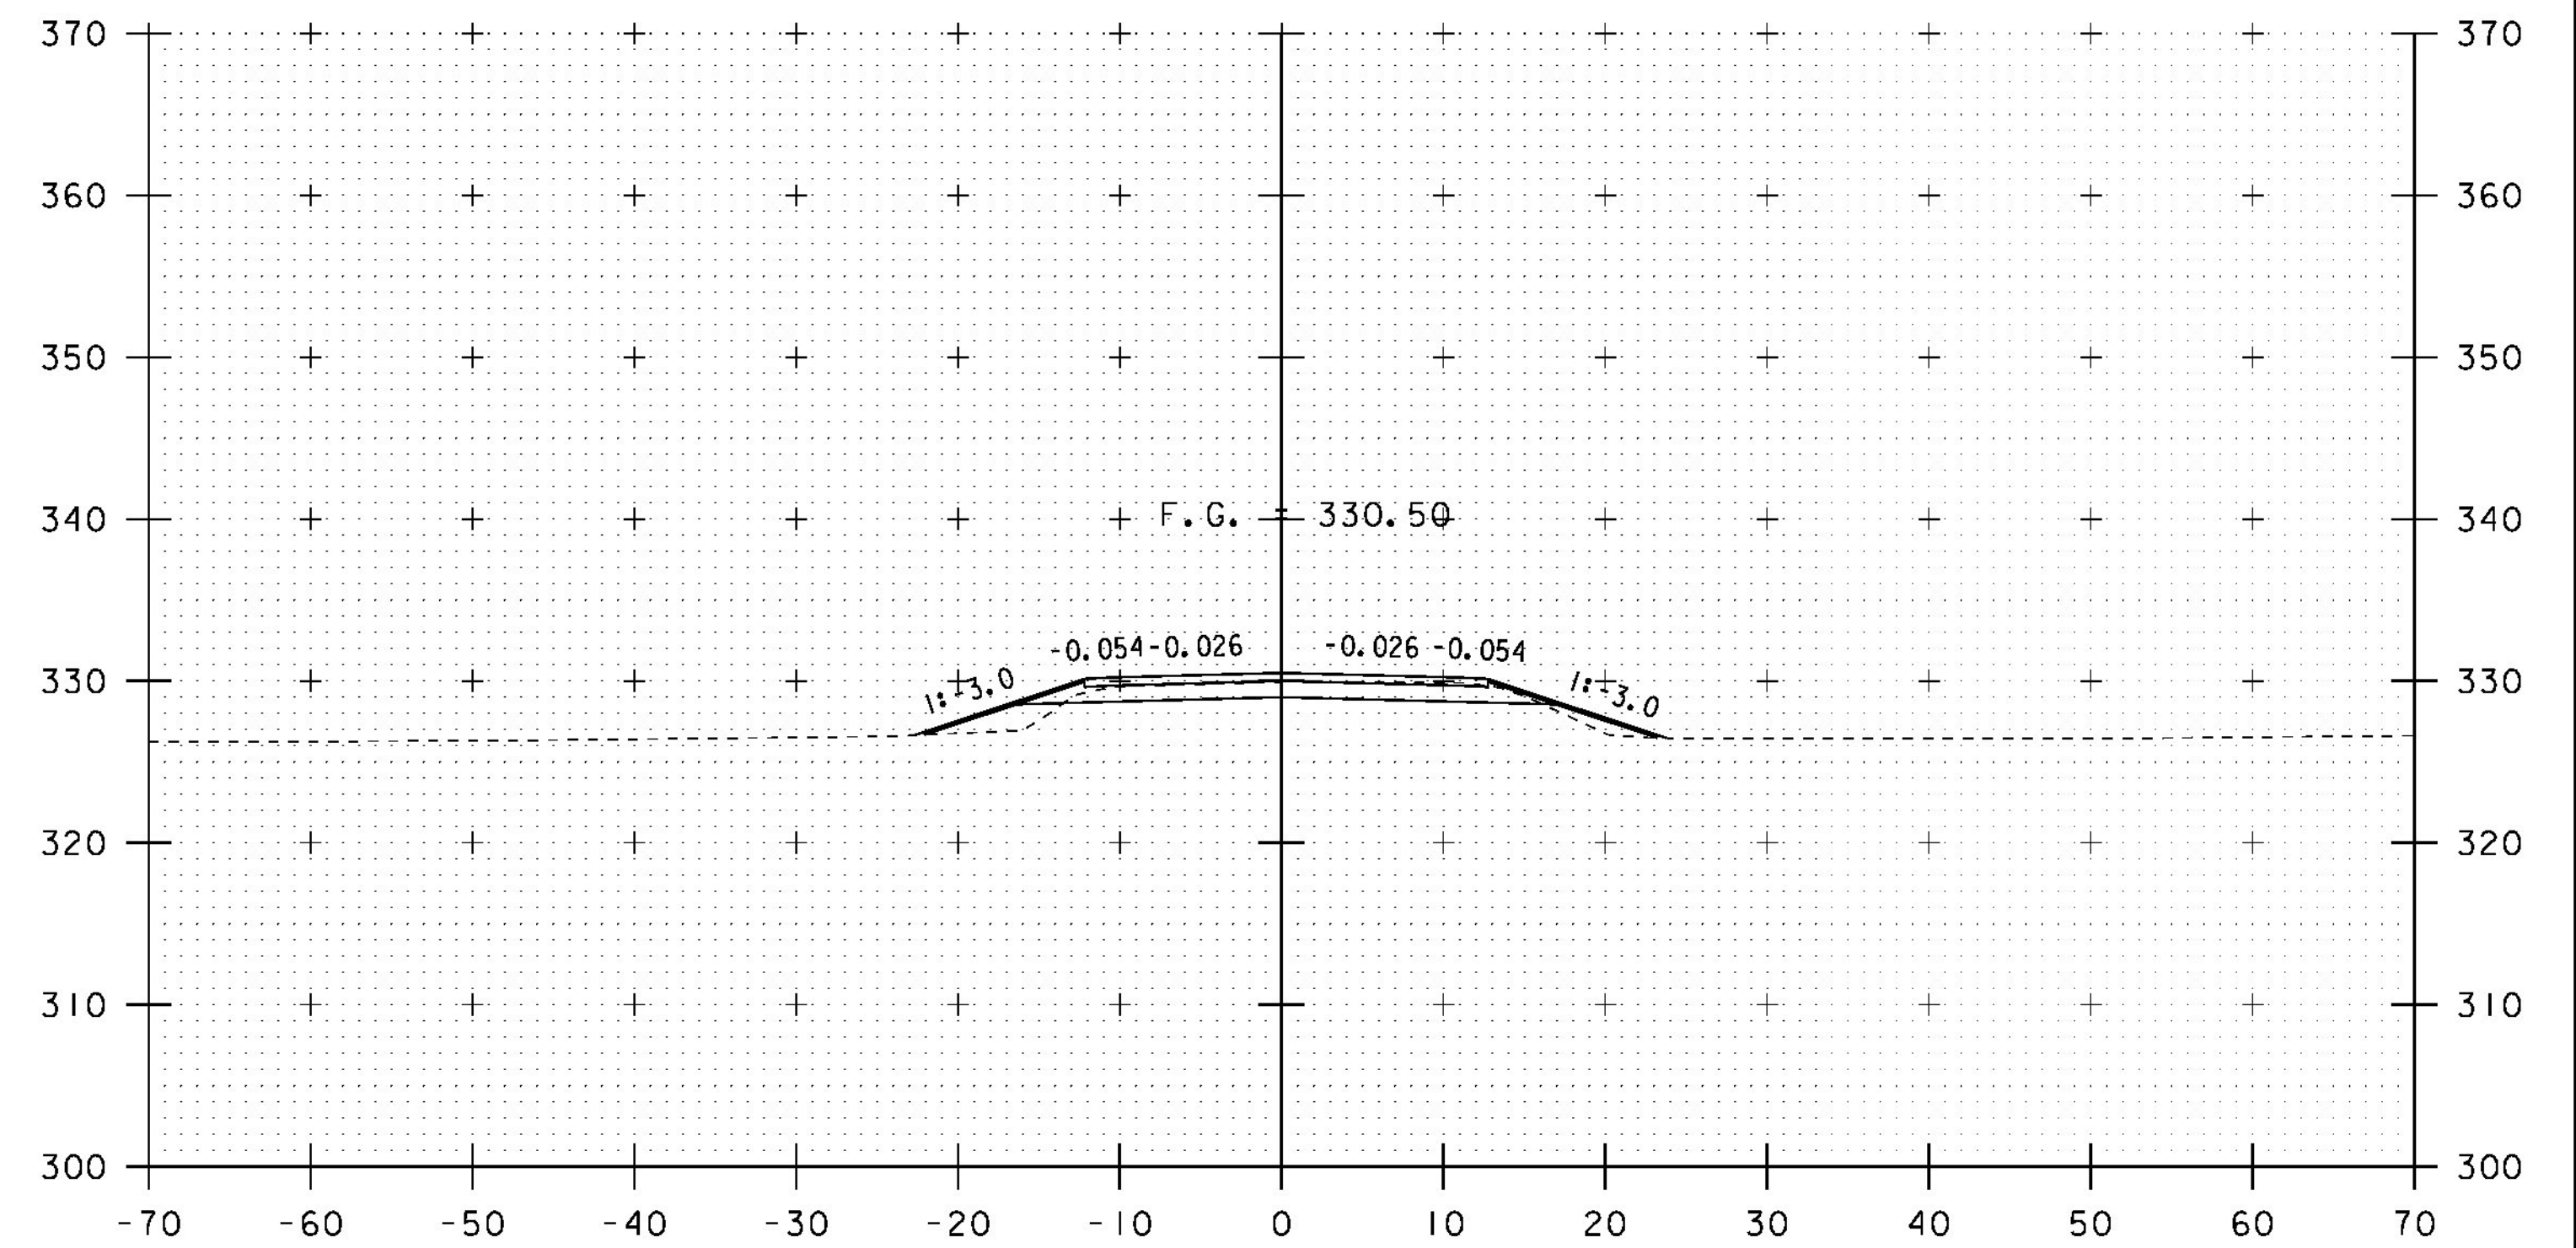


108+50

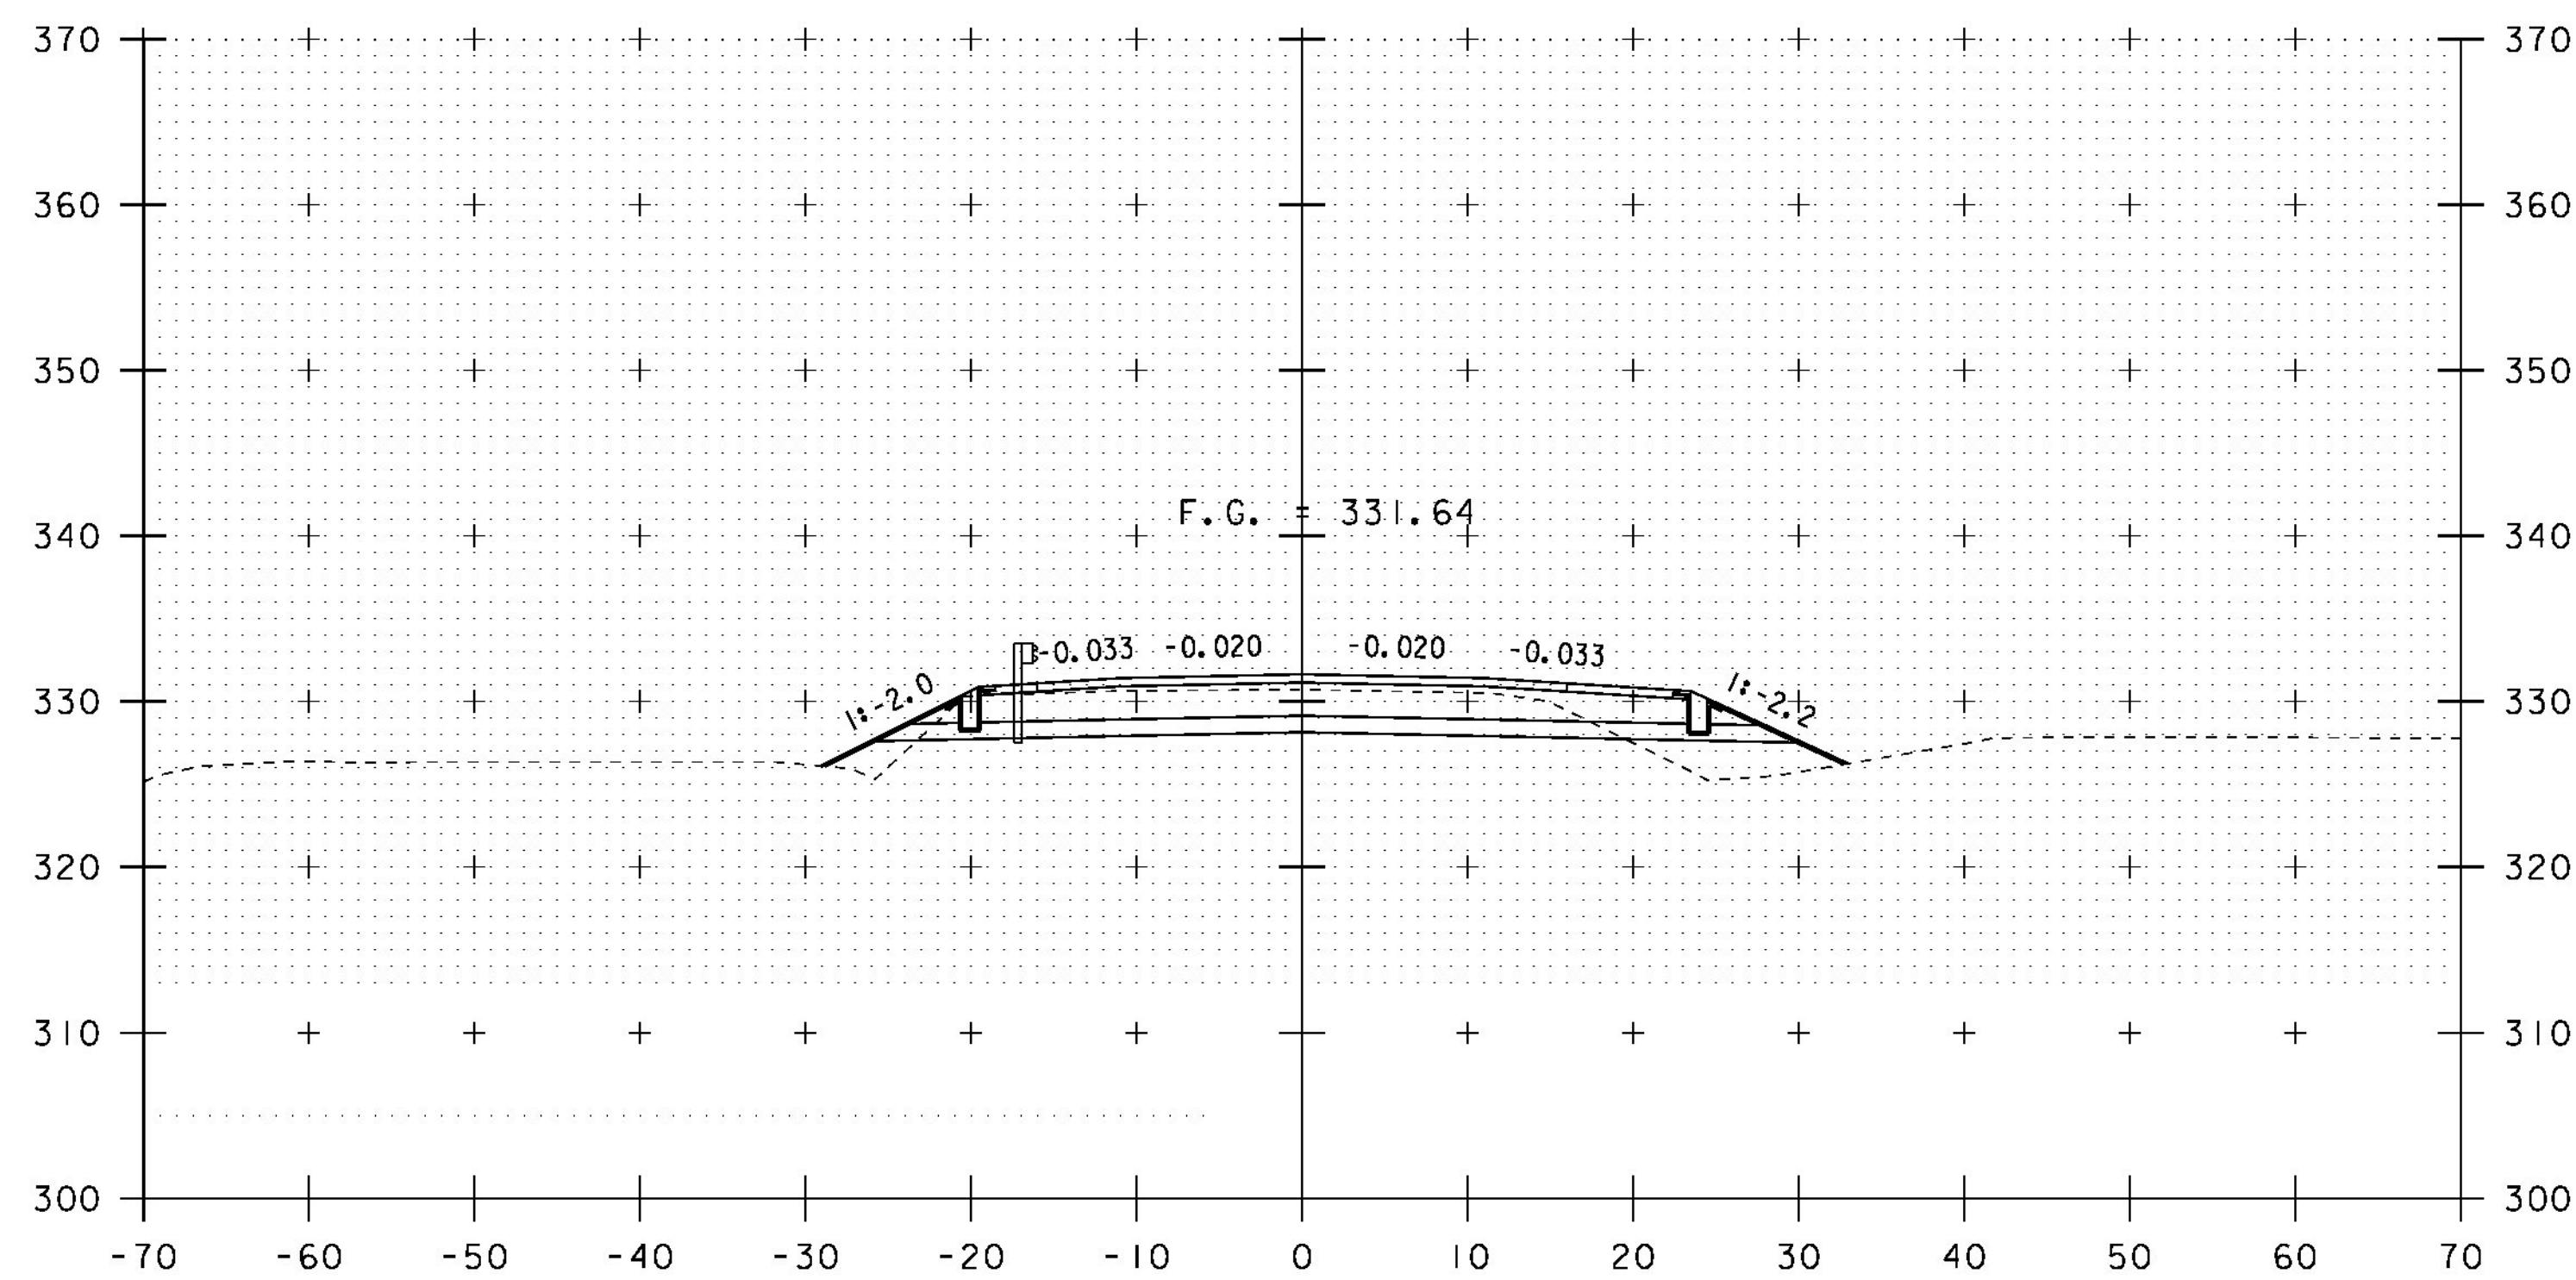

107+75

SPECIAL PROVISION (STONE DIAPHRAGM)
STA 107+57.7 LT - STA 108+40.0 LT

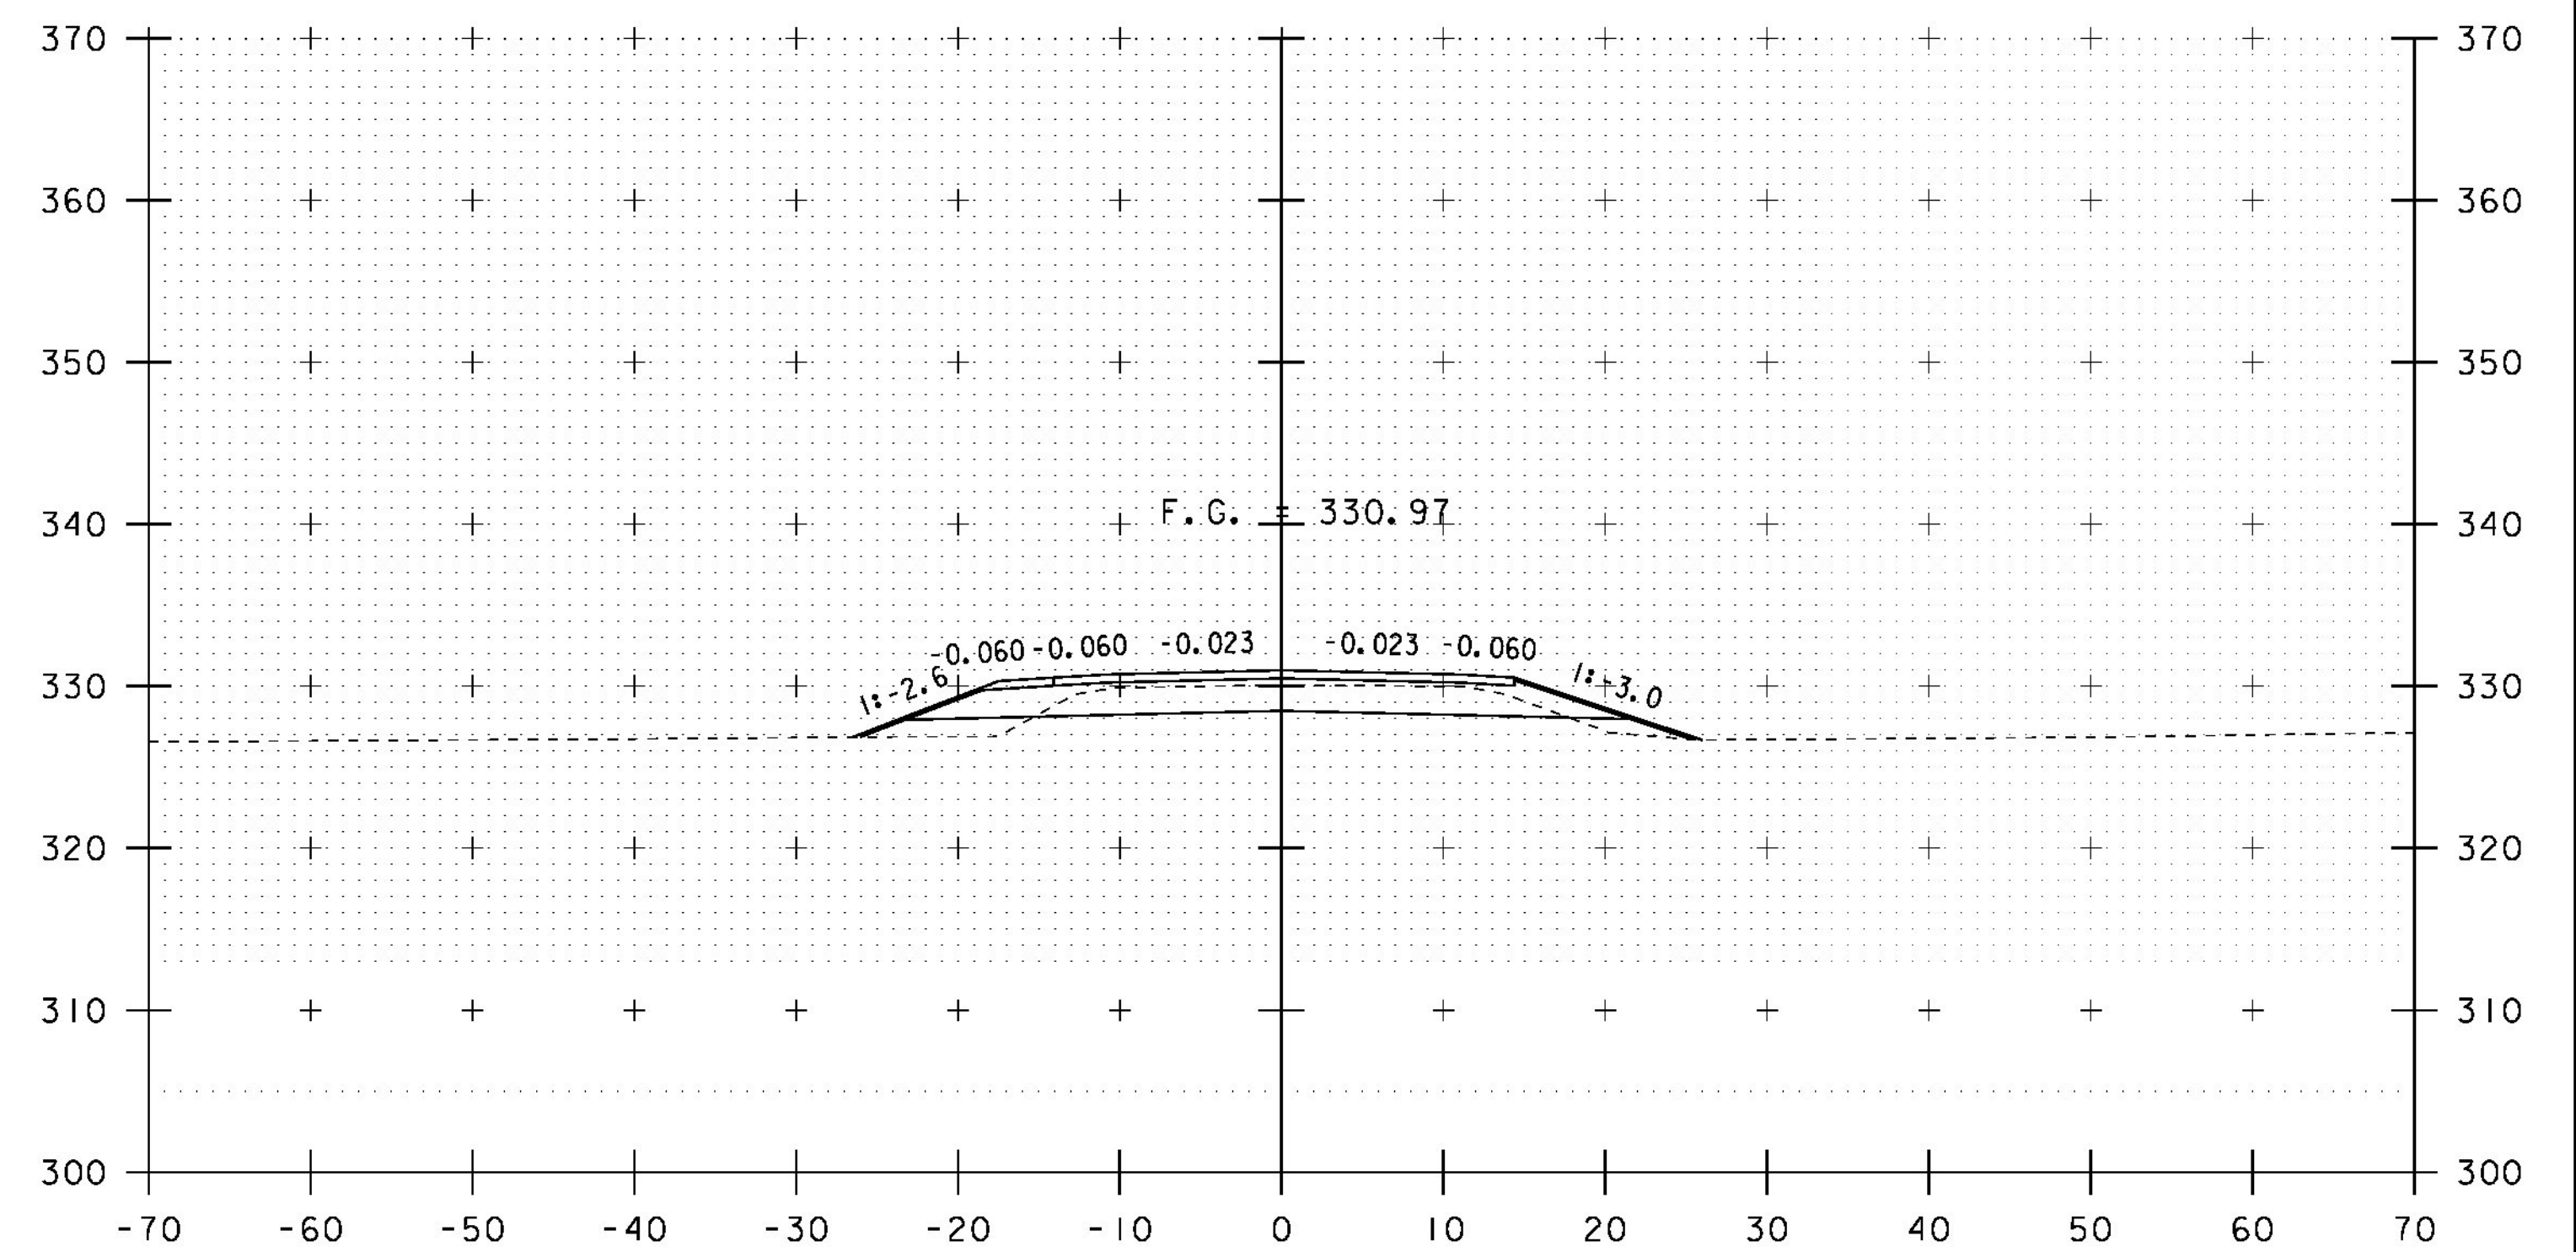

108+25

10 0 10
SCALE: 1" = 10'-0"

STA. 107+75 TO STA. 108+50

PROJECT NAME: BRISTOL	PLOT DATE: 04-NOV-2014
PROJECT NUMBER: BRF 021-1(29)	DRAWN BY: G. ROY
FILE NAME: si0b094xsl.dgn	CHECKED BY: EVANS-MONGEON
PROJECT LEADER: C. CARLSON	SHEET 39 OF 54
DESIGNED BY: G. ROY	
VT 116 CROSS SECTIONS (5)	