




109+00

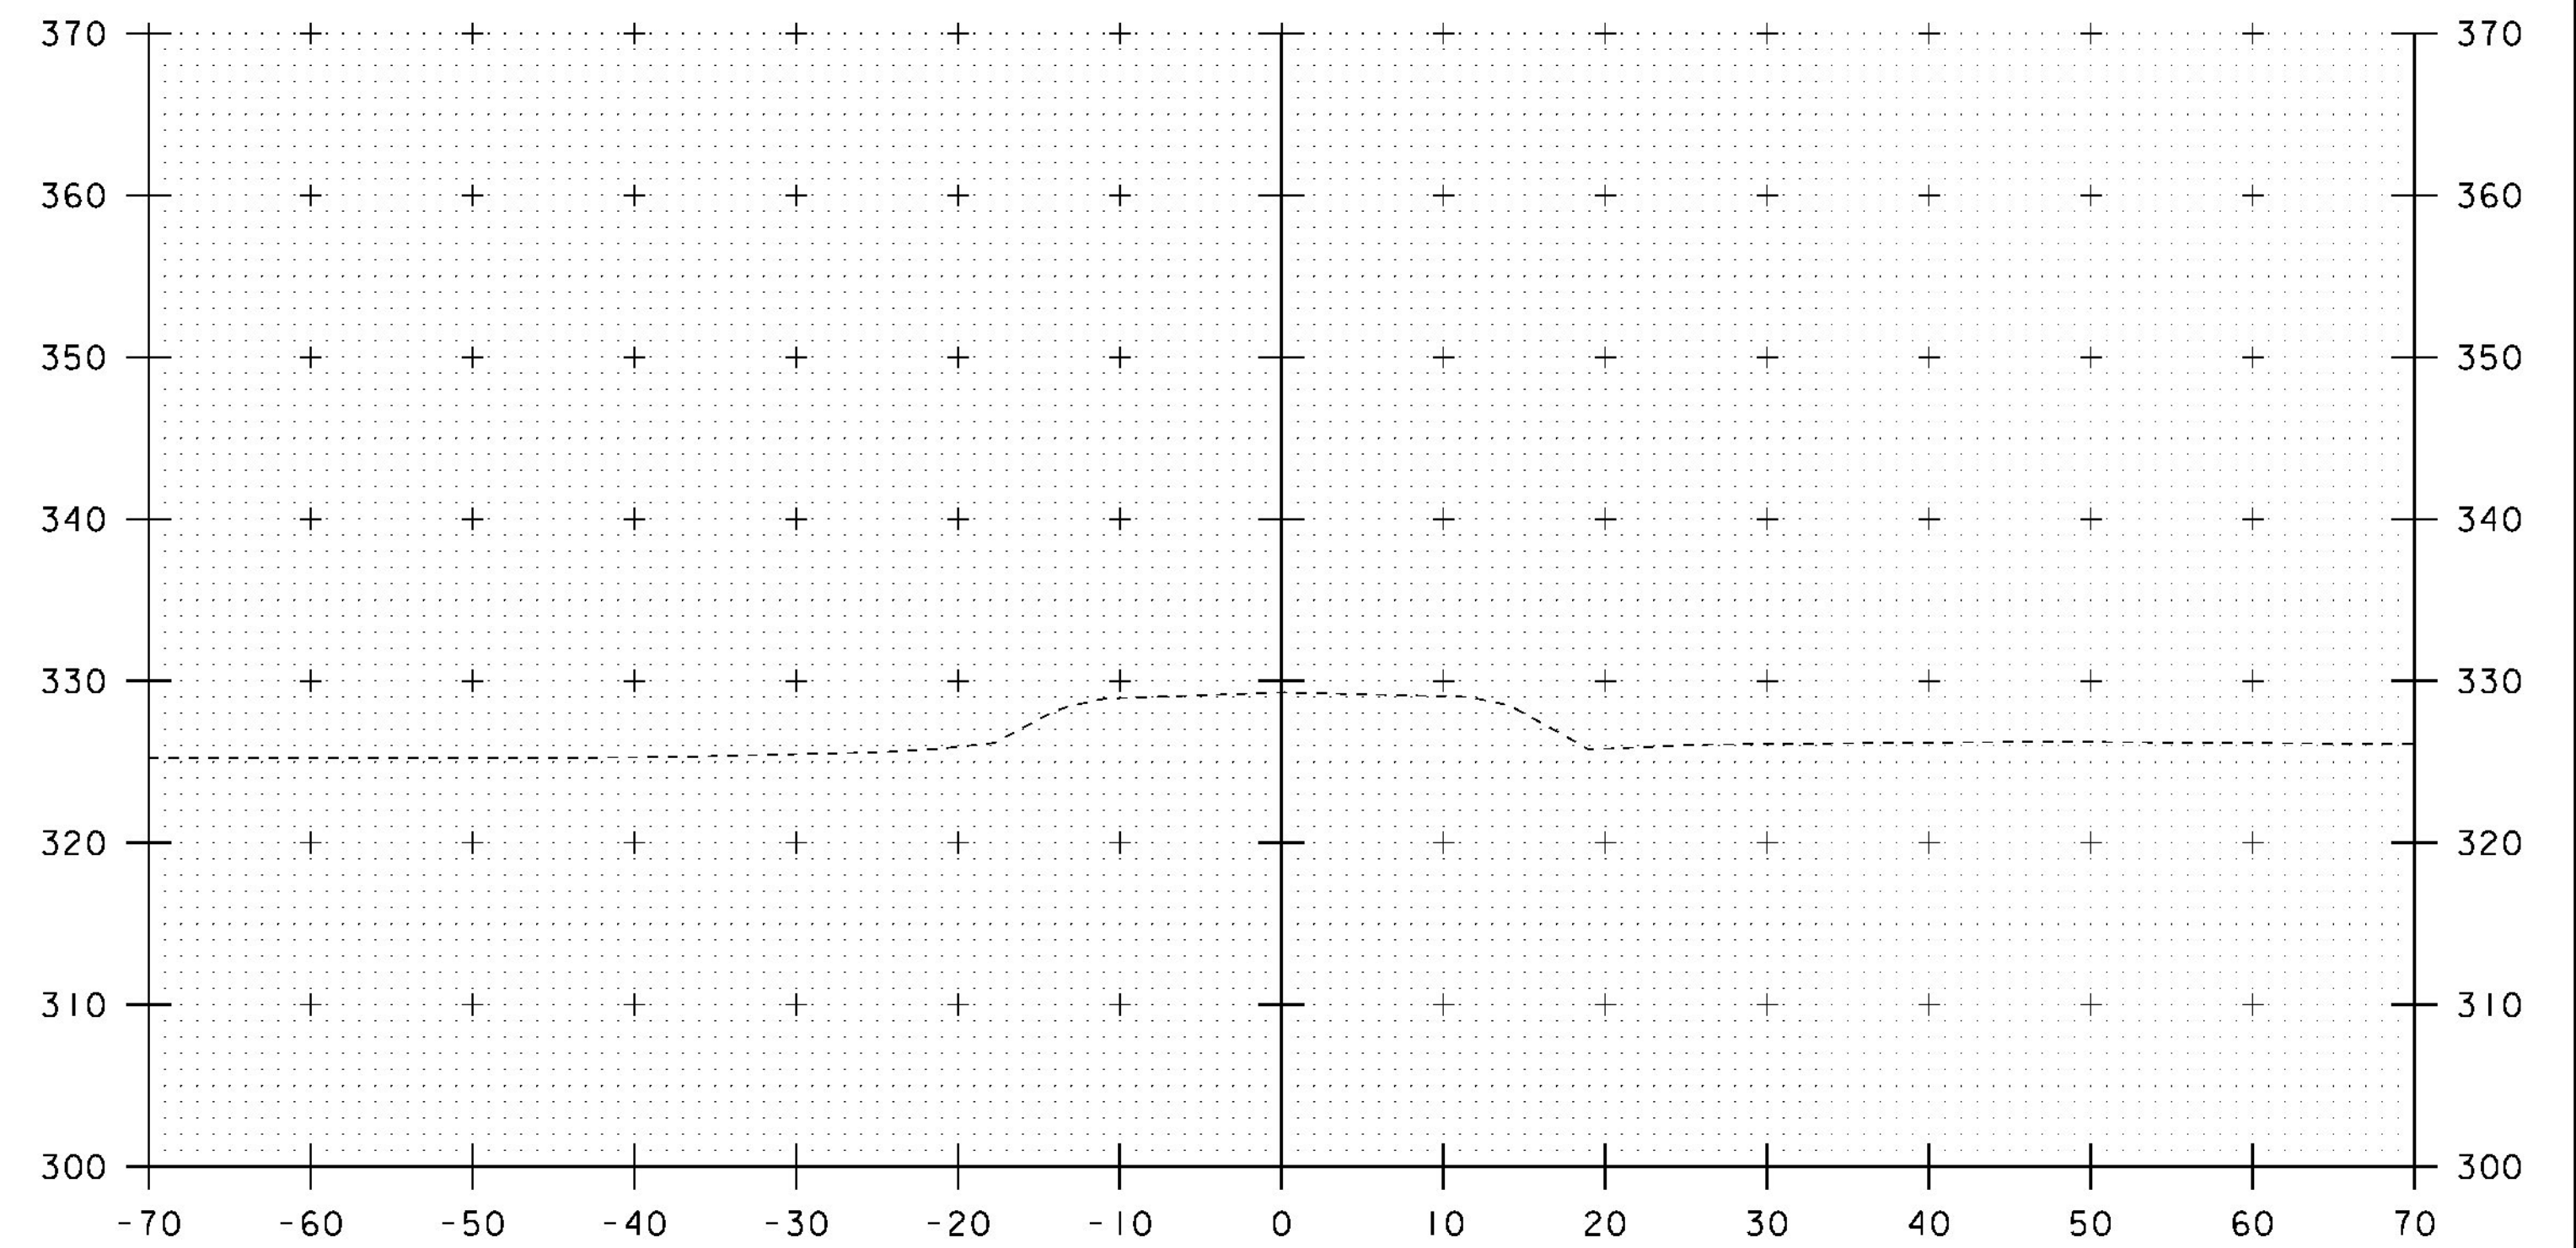

109+50

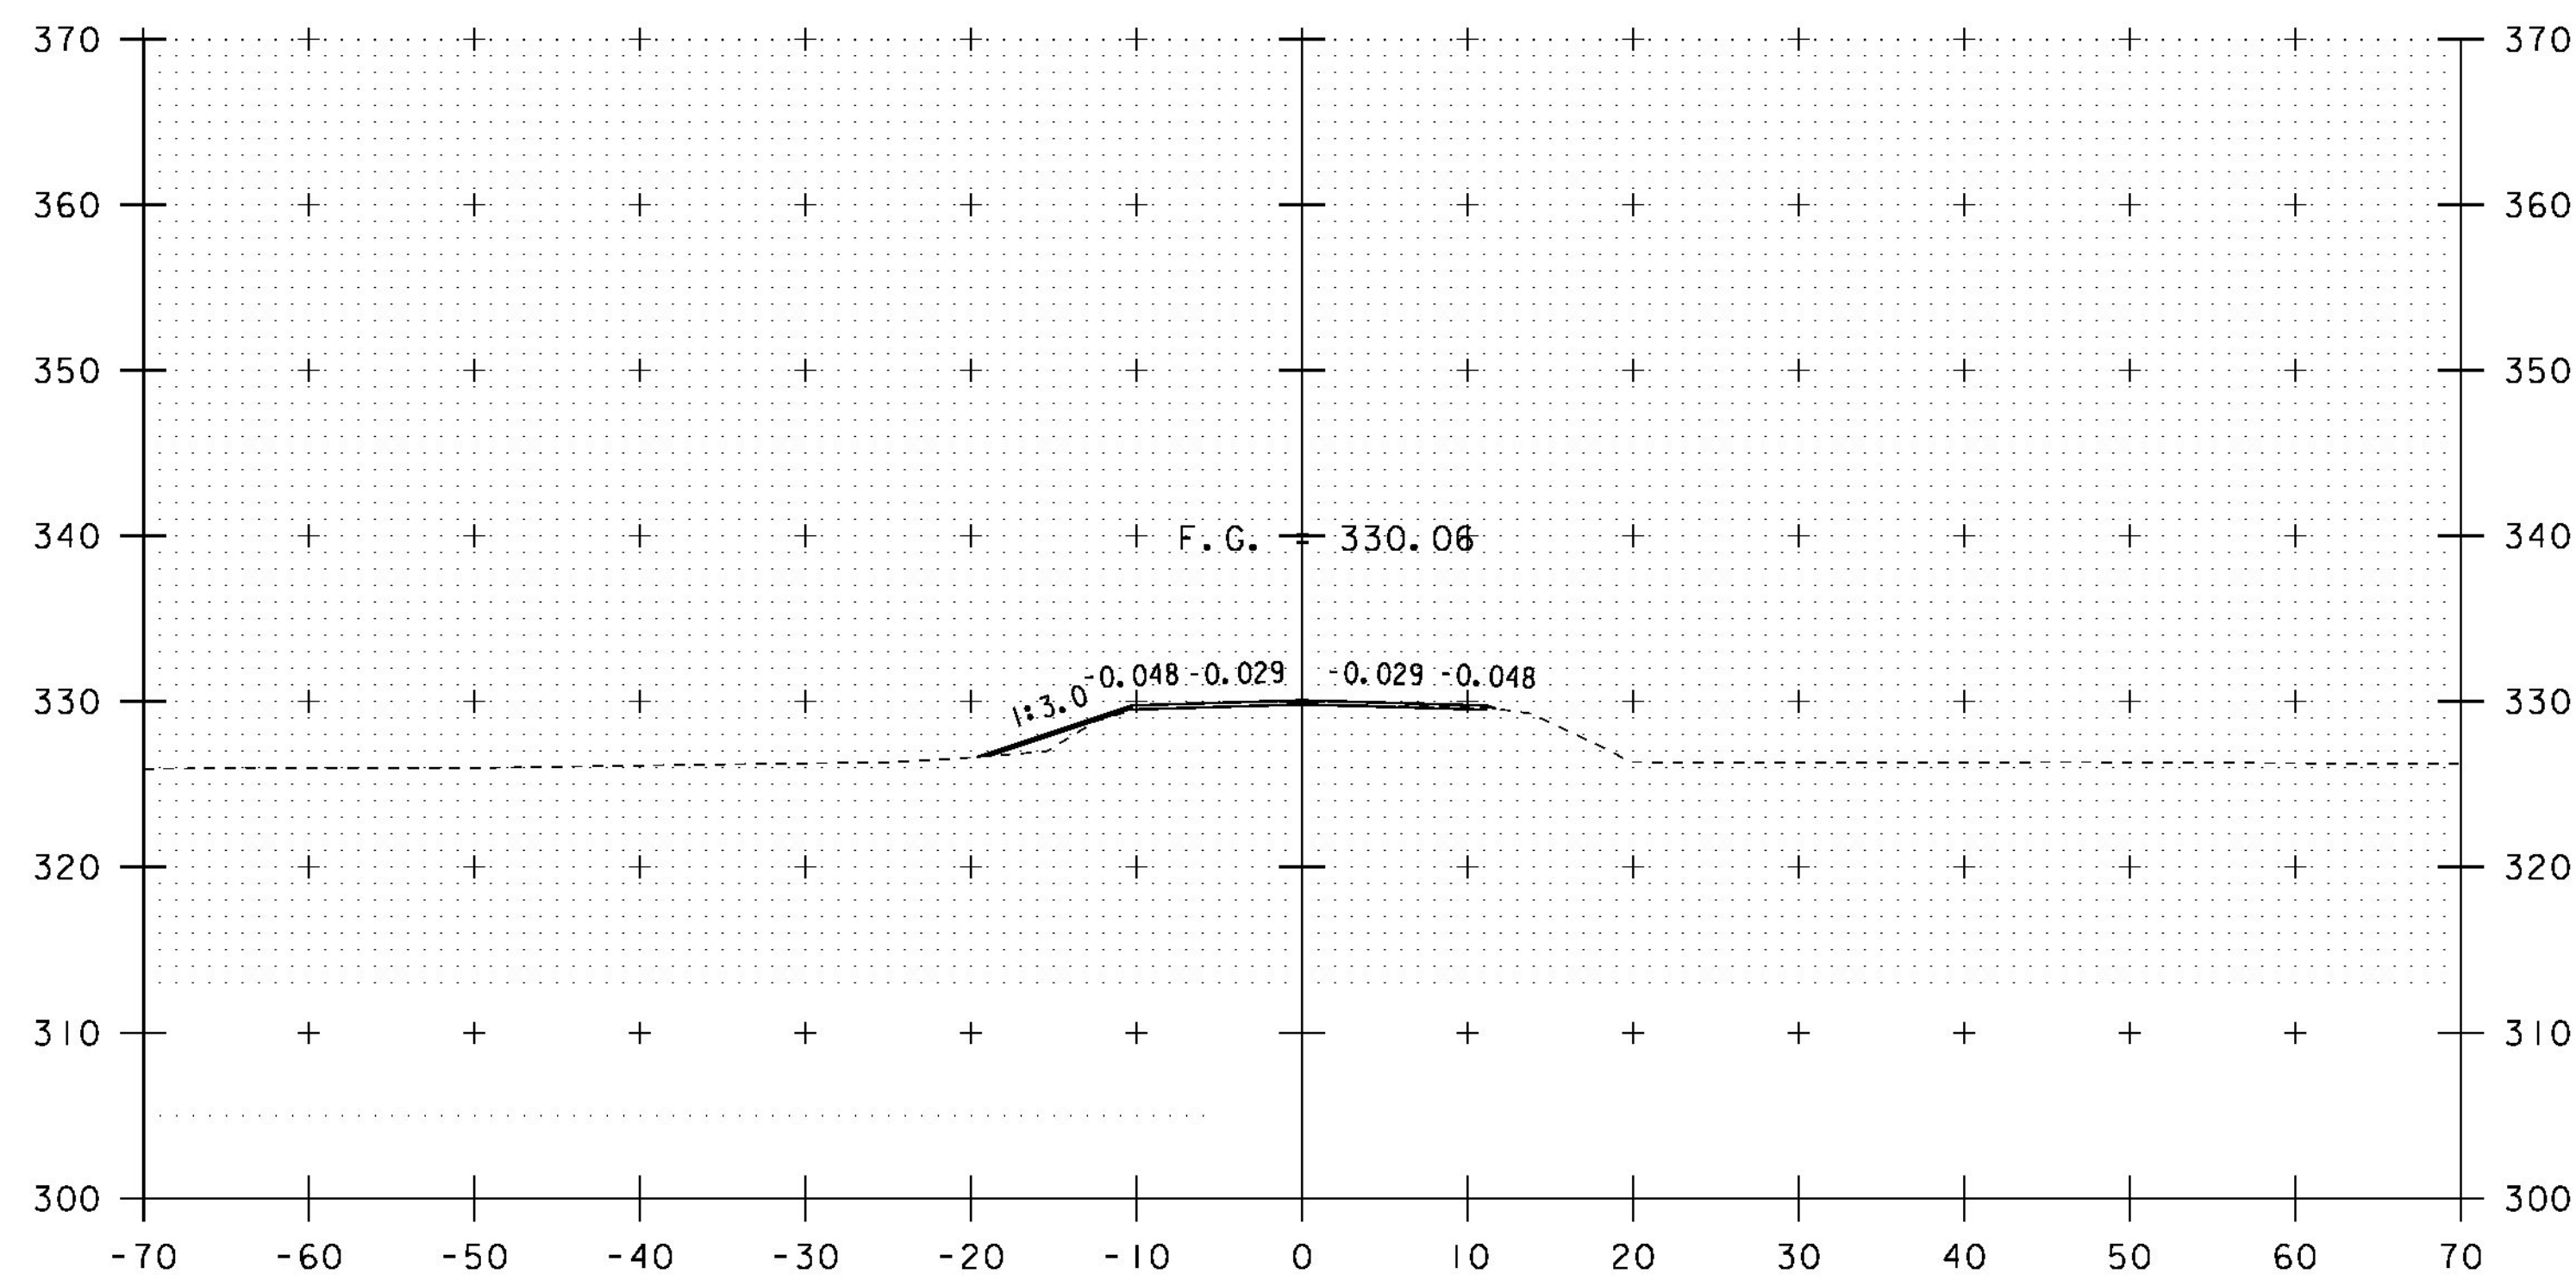


108+75

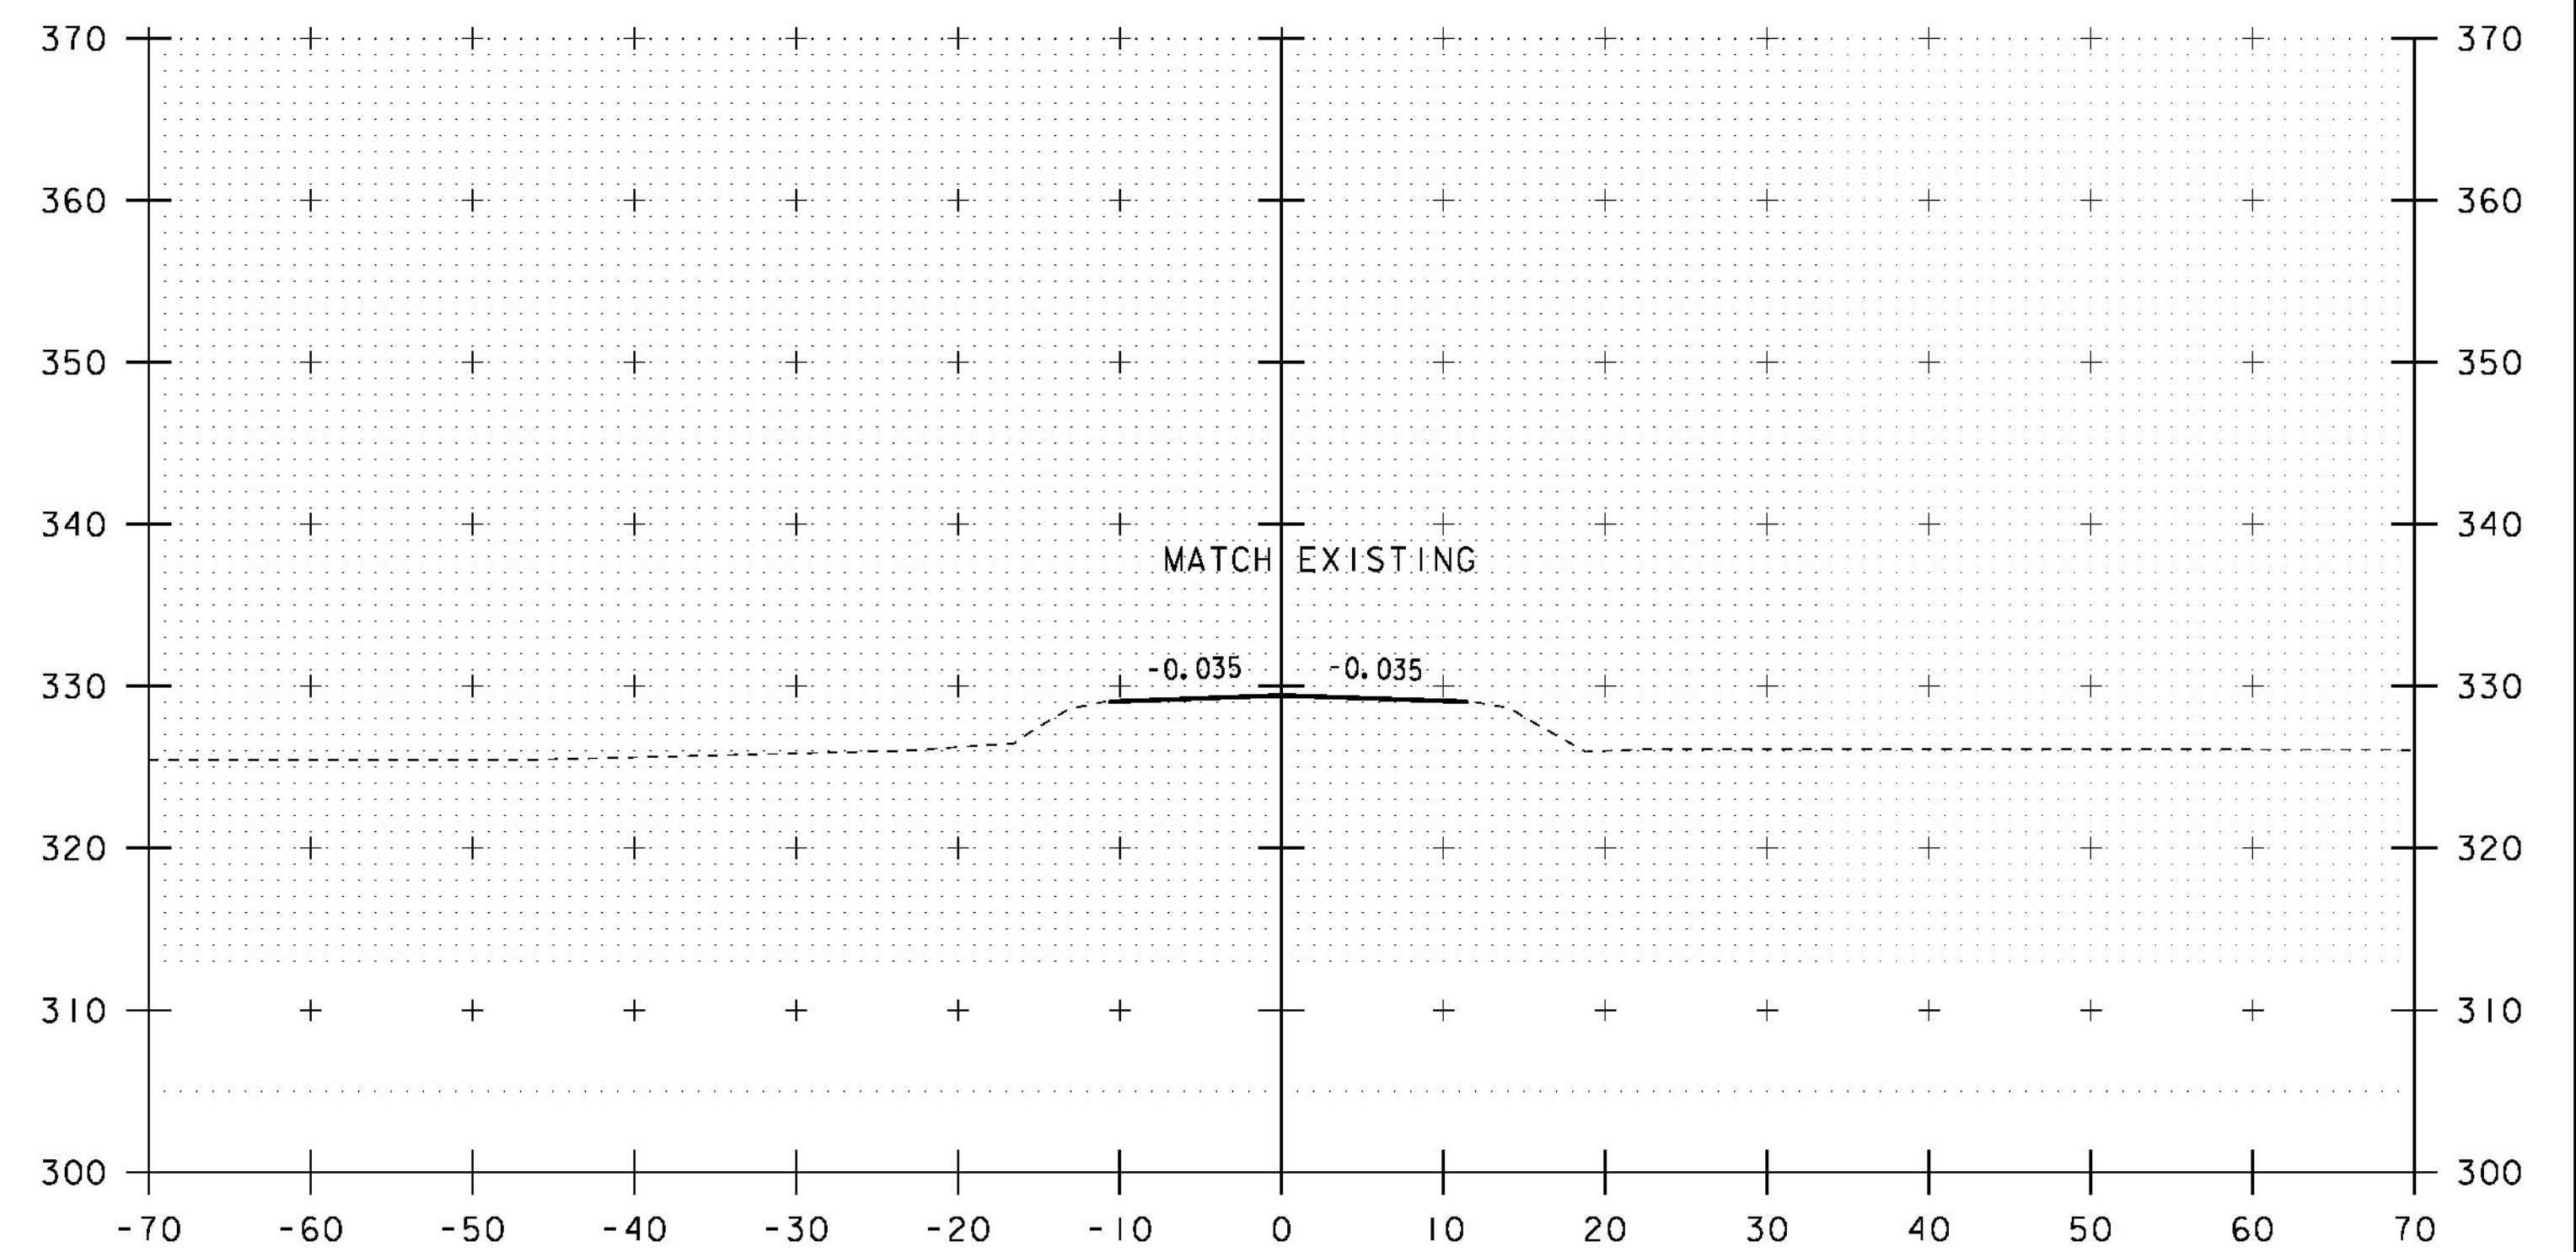

109+25

STA 109+25.00
END APPROACH
MATCH EXISTING

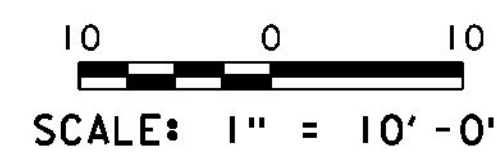

STA. 108+75 TO STA. 109+50

PROJECT NAME: BRISTOL	PLOT DATE: 04-NOV-2014
PROJECT NUMBER: BRF 021-1(29)	DRAWN BY: G. ROY
FILE NAME: s10b094xsl.dgn	CHECKED BY: EVANS-MONGEON
PROJECT LEADER: C. CARLSON	SHEET 40 OF 54
DESIGNED BY: G. ROY	
VT 116 CROSS SECTIONS (6)	