


VT 116 BANKING DIAGRAM

HORIZONTAL SCALE: 1" = 20'-0"
 VERTICAL SCALE: 1" = 0.02' /"

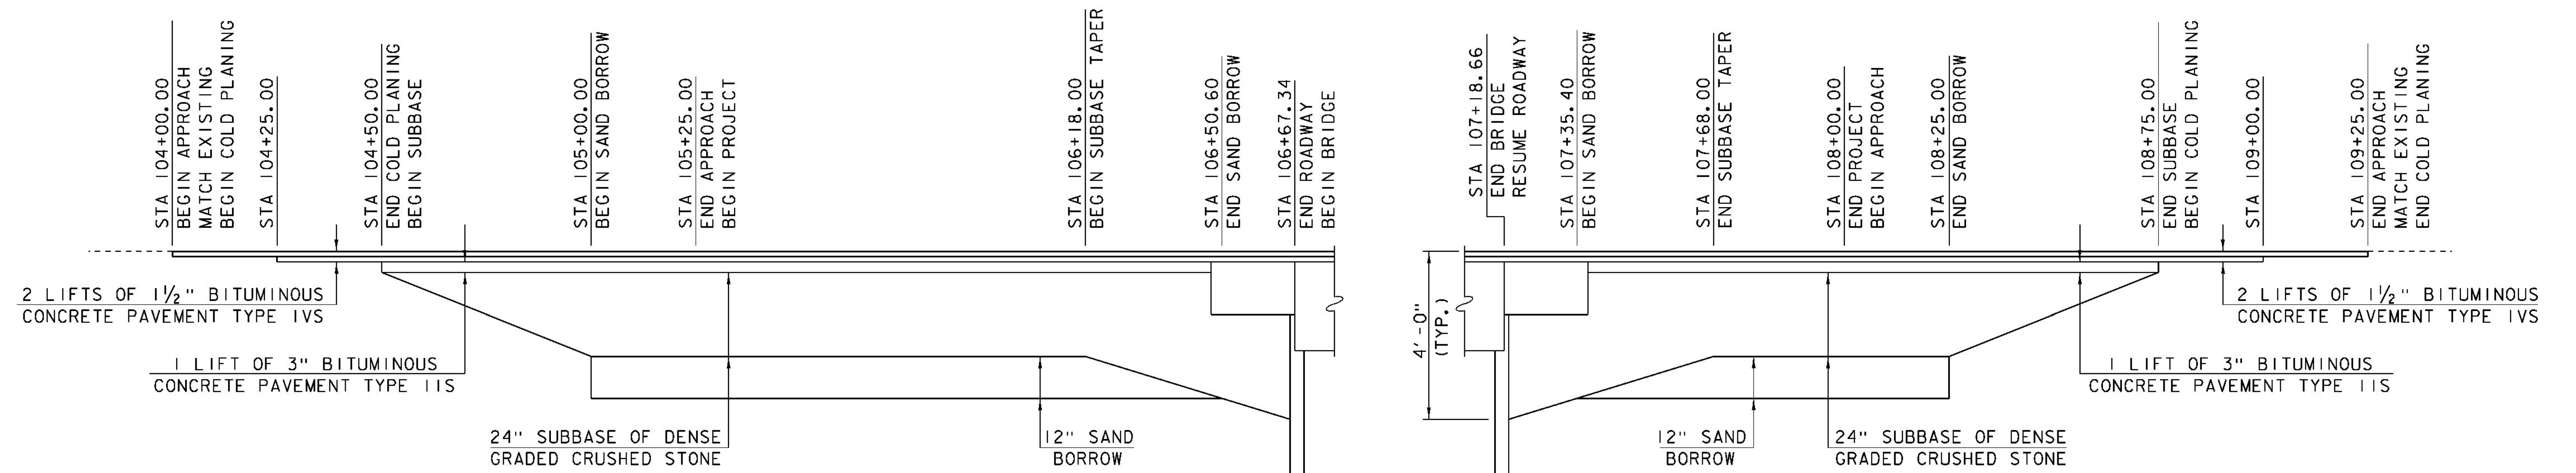

NOTES:

1. SEE SECTIONS TO DETERMINE CUT OR FILL.
2. SEE PROJECT TYPICAL SECTIONS FOR ABUTMENT EARTHWORK DETAILS.

VT 116 MATERIAL TRANSITION DETAIL

HORIZONTAL SCALE: 1" = 20'-0"
 VERTICAL SCALE: 1" = 2'-0"

PROJECT NAME:	BRISTOL
PROJECT NUMBER:	BRF 021-1(29)
FILE NAME:	si0b094bdm+d.dgn
PROJECT LEADER:	C. CARLSON
DESIGNED BY:	G. ROY
BANKING DIAGRAM AND MATERIAL TRANSITION DETAIL SHEET	41 OF 54
PLOT DATE:	04-NOV-2014
DRAWN BY:	G. ROY
CHECKED BY:	EVANS-MONGEON