


107+75, ASKEW 20° RT

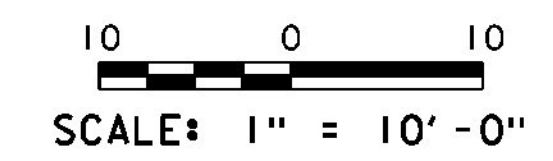

PROJECT NAME:	BRISTOL
PROJECT NUMBER:	BRF 021-1(29)
FILE NAME: si0b094xsl.dgn	PLOT DATE: 04-NOV-2014
PROJECT LEADER: C. CARLSON	DRAWN BY: G. ROY
DESIGNED BY: G. ROY	CHECKED BY: EVANS-MONGEON
PIPE PROFILE	SHEET 42 OF 54