


Plan View

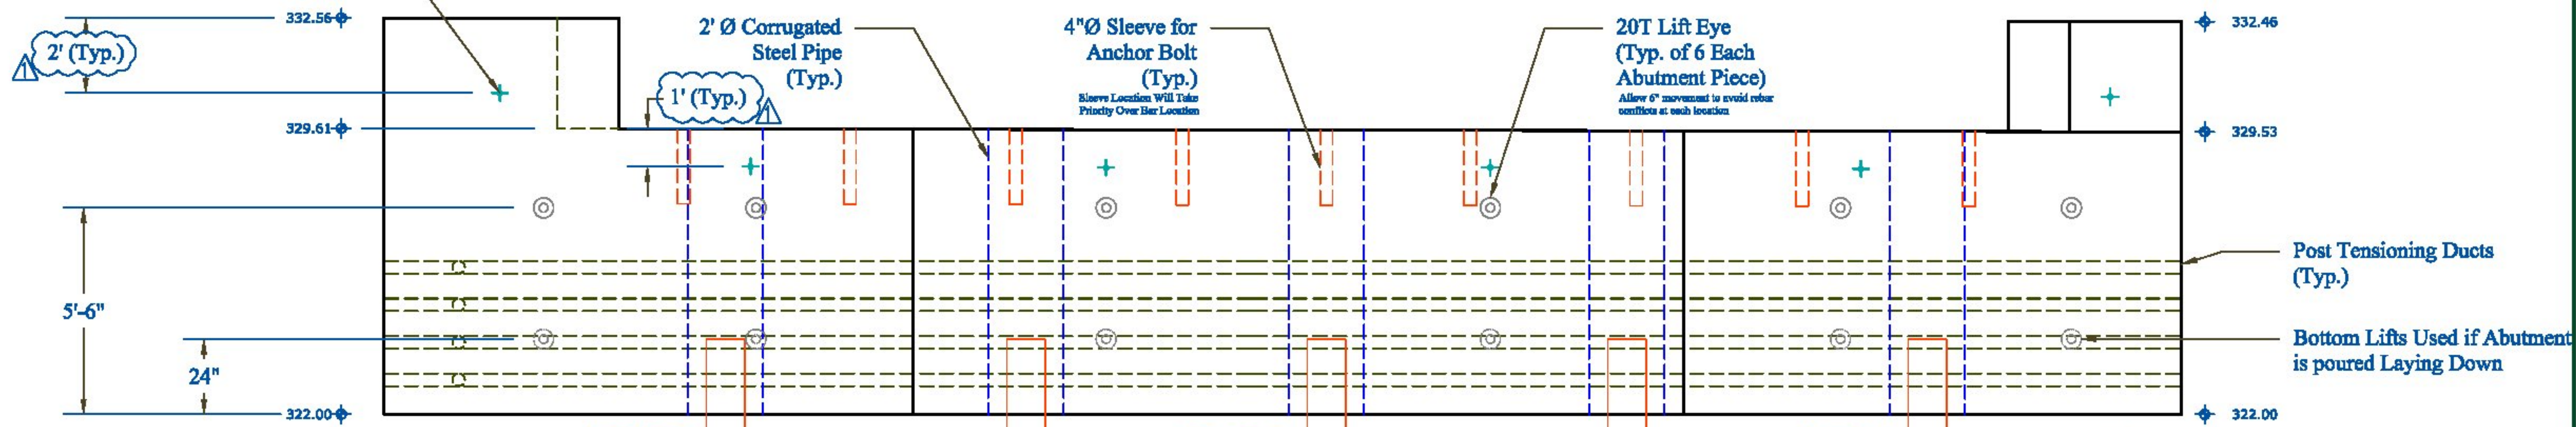

Elevation View

AB1N: 53,450 lbs
 AB1M: 69,700 lbs
 AB1S: 53,750 lbs

CONTRACTORS VISPE:	Vermont Agency of Transportation RECEIVED CK'D BY MEM OK'D BY CWC Apr. 17, 2015 RESUBMIT APPROVED ✓ BY C. Carlson DATE 04-17-2015	Rev. 1	Date 04/16/15	By IBA	Description Changes per State Review	PRECAST CONCRETE ABUTMENT SHOP DRAWINGS (SDI JOB #15264) SUPERVISOR: M. WHEELER DETAILER: I. ADAMS CHECKER: E. Barendse ENGINEER: VTAOT		PROJECT NAME: Bristol BRP 021-1(29) PROJECT #: 021-1(29) LOCATION: Bristol, VT		INSTALLER: S.D. Ireland Concrete 193 Industrial Ave Williston, VT 05495	FABRICATOR: 193 INDUSTRIAL AVE. WILLISTON, VT 05495 Ph: (802) 658-0201		03/17/2015	ABUTMENT_1	2_OF_16
		AB1N: 53,450 lbs AB1M: 69,700 lbs AB1S: 53,750 lbs													