



Tensioning Blockout Plan

See Post Tensioning Note 1 & 6 on Pg. 1

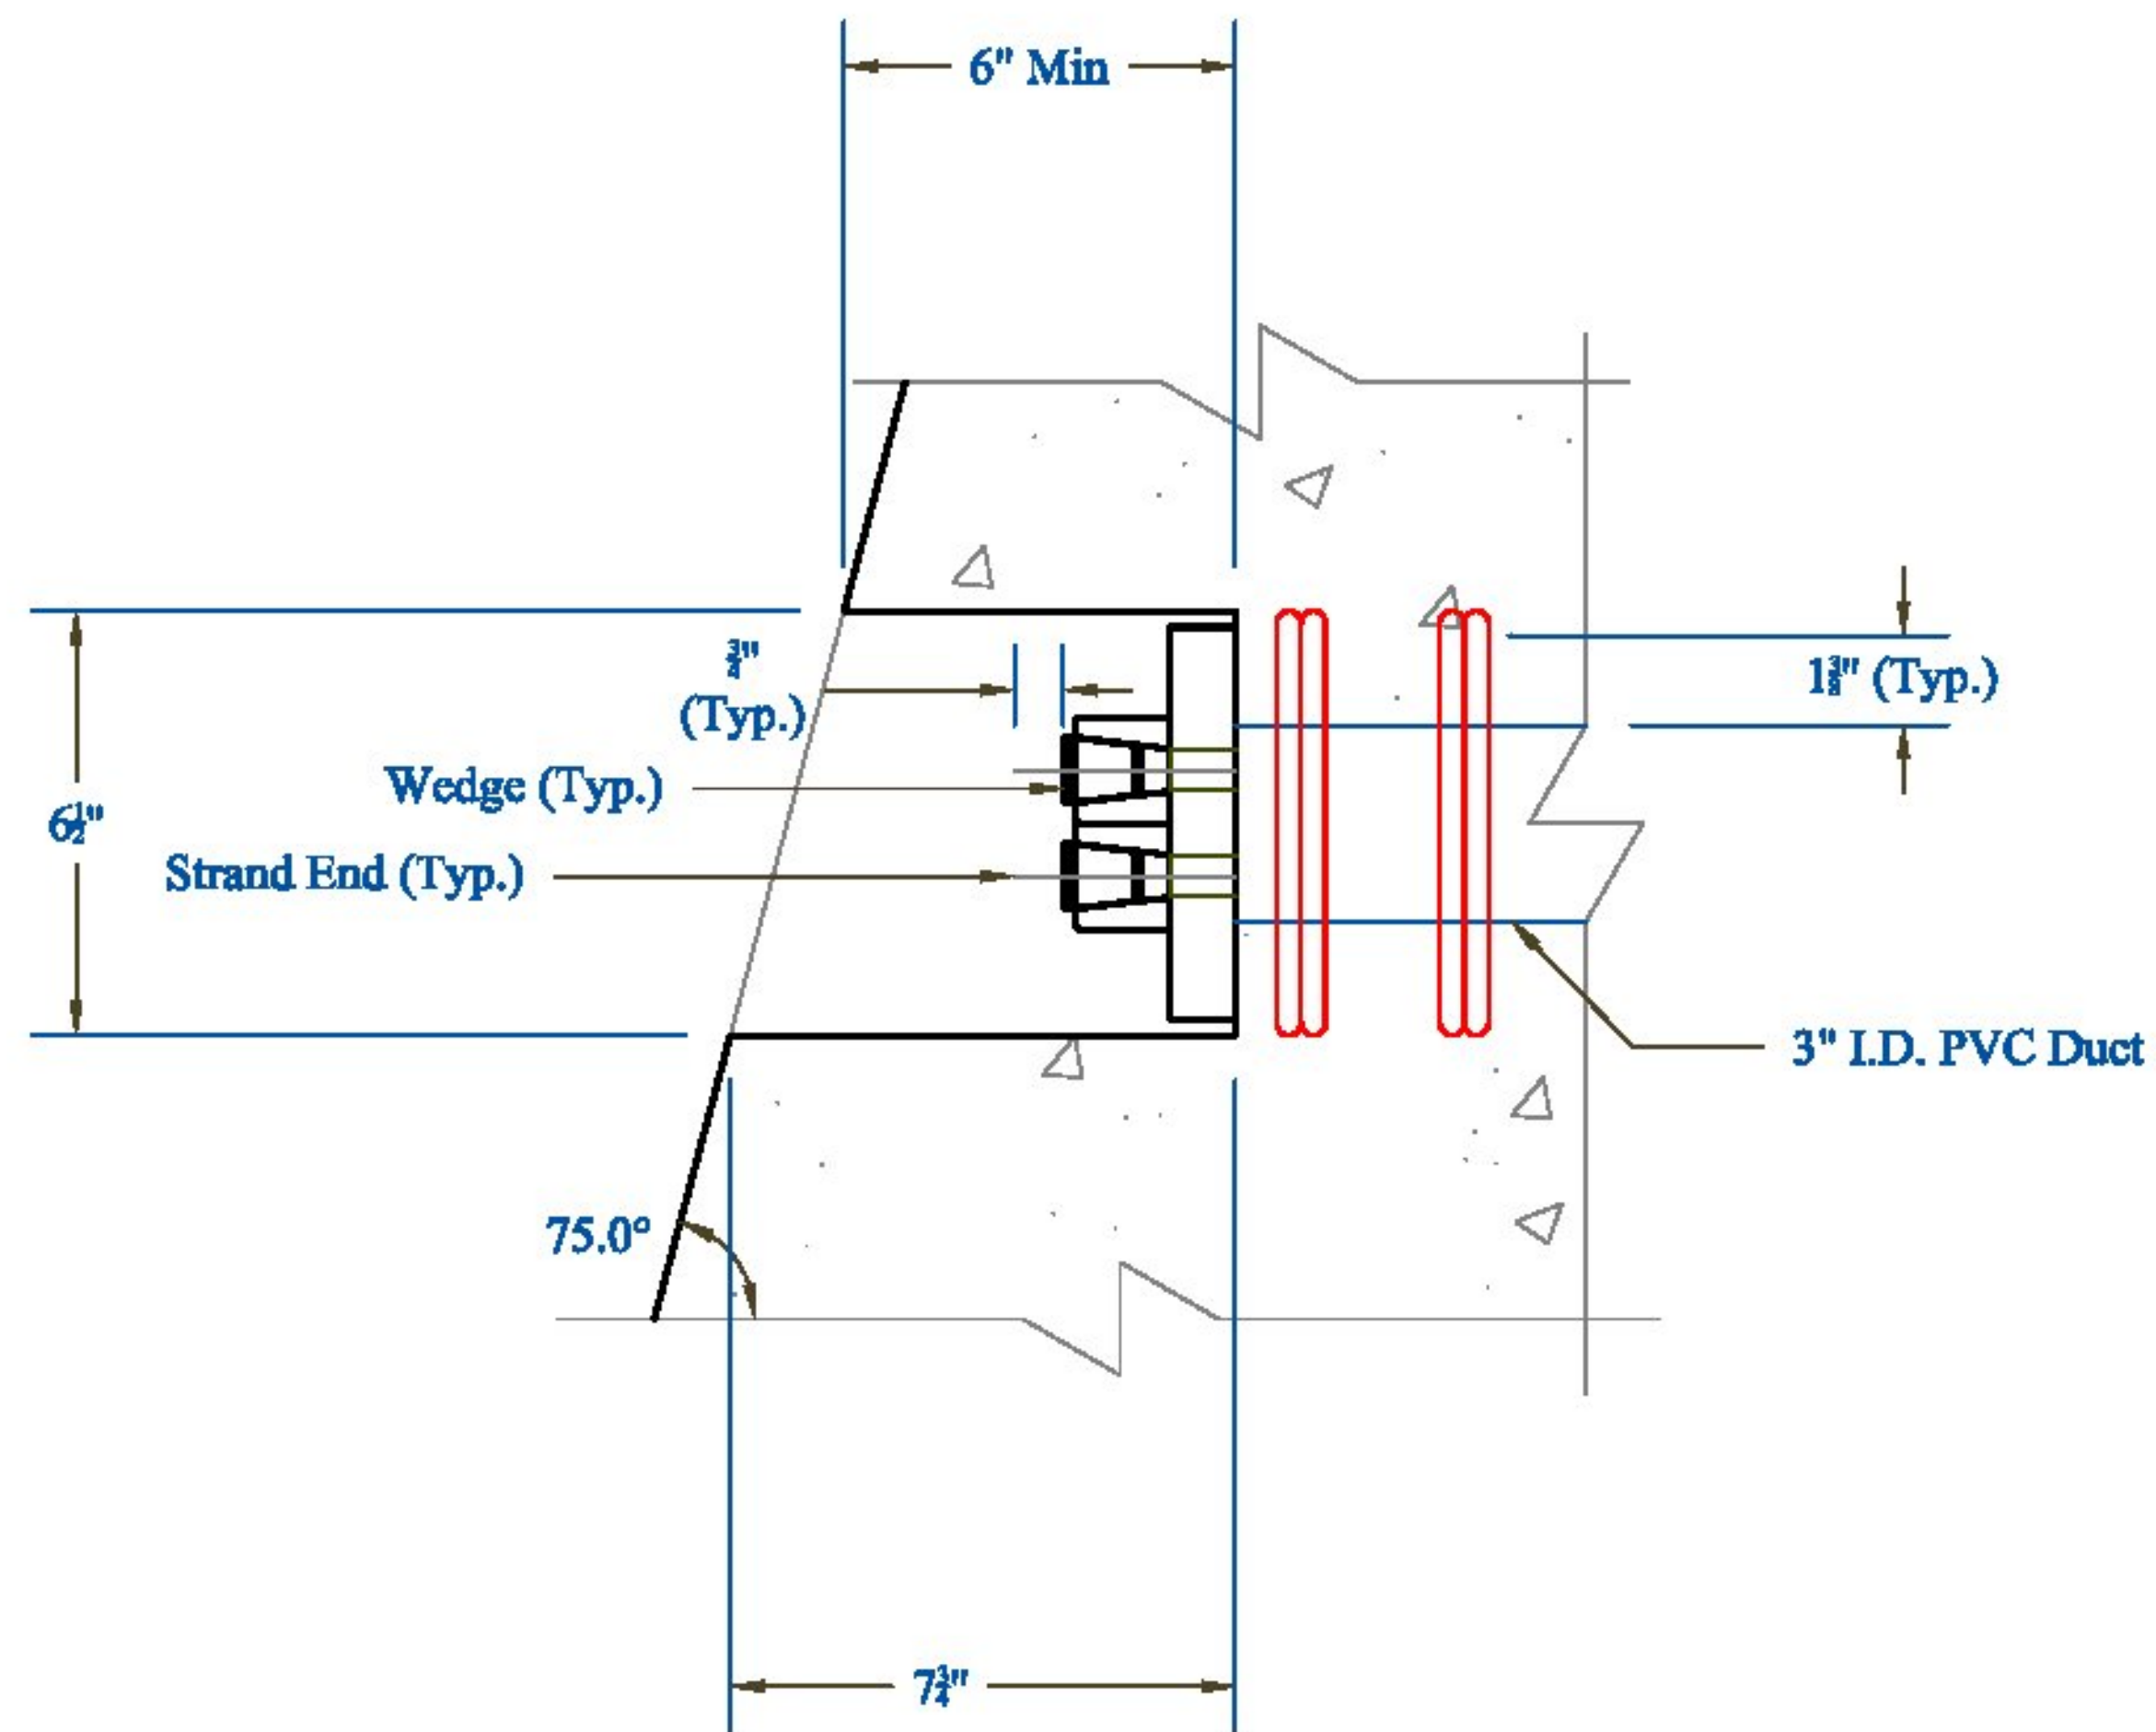

Tensioning Blockout Section

See Post Tensioning Note 1 & 6 on Pg. 1

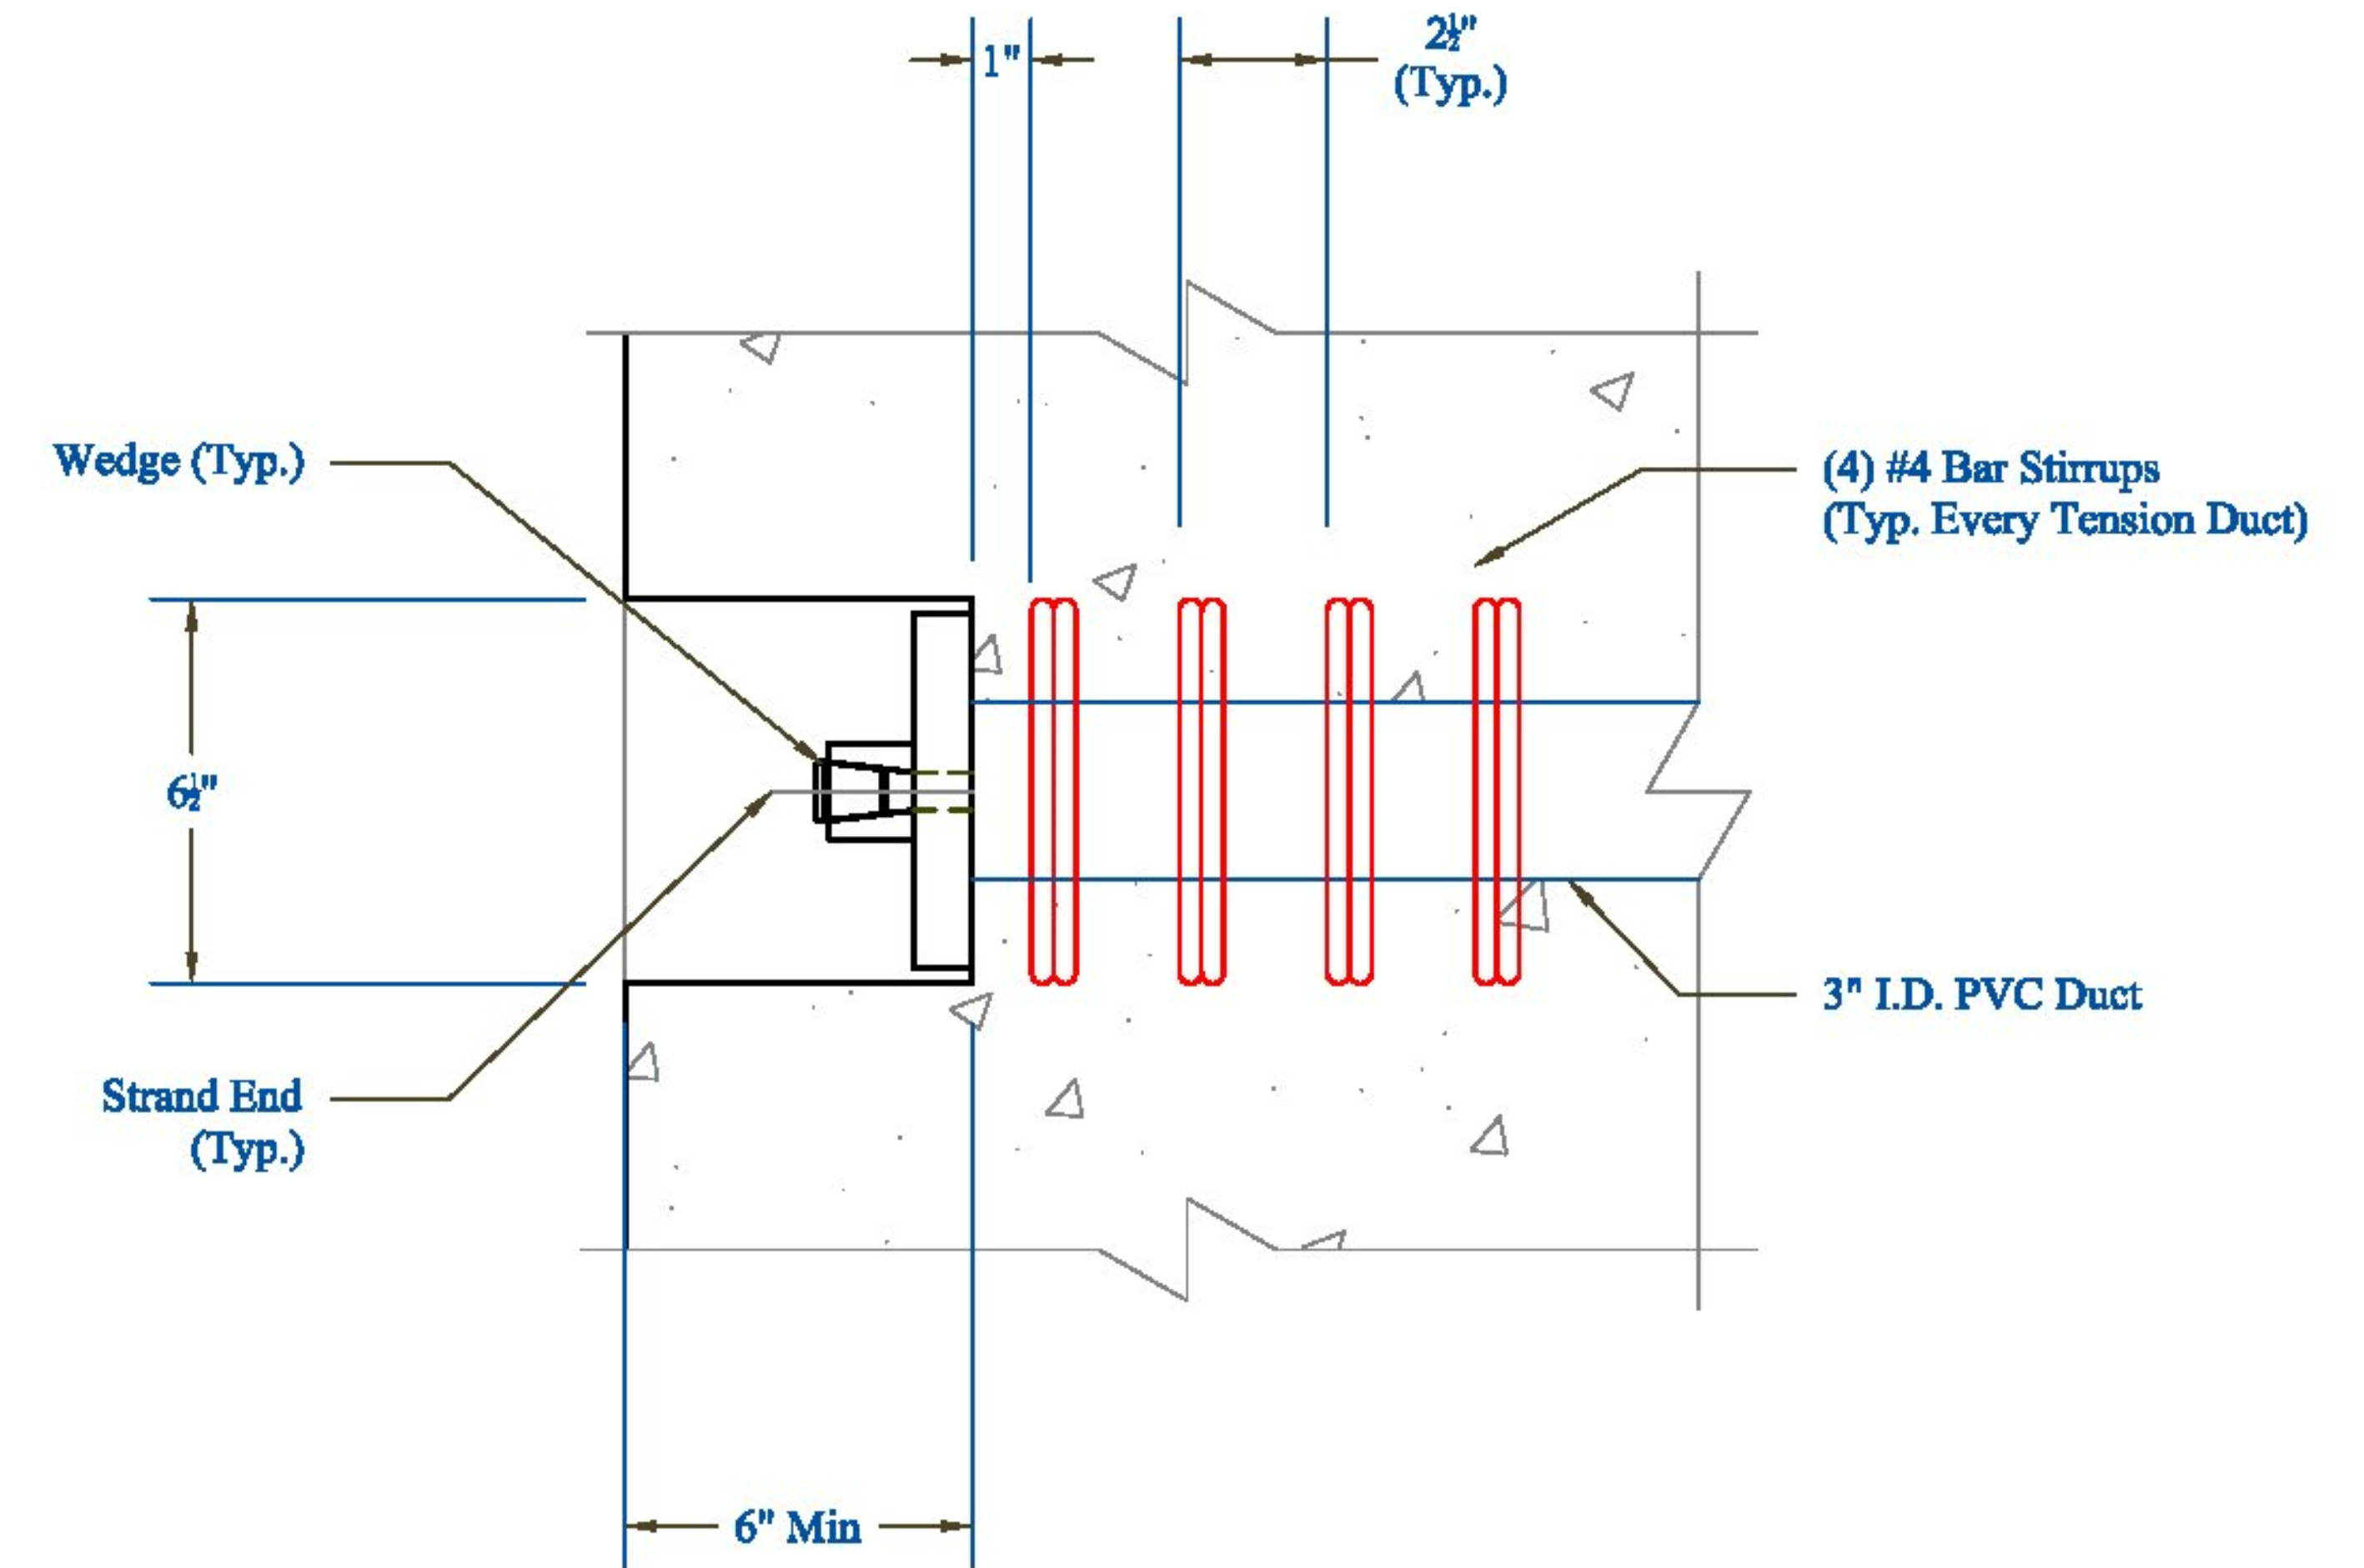

CONTRACTORS VISIT:	Vermont Agency of Transportation RECEIVED CK'D BY MEM OK'D BY CWC Apr. 17, 2015 RESUBMIT APPROVED ✓ BY C. Carlson DATE 04-17-2015	Rev. 1	Date 04/16/15	By IBA	Description Changes per State Review	PRECAST CONCRETE ABUTMENT SHOP DRAWINGS (SDI JOB #15264) SUPERVISOR: M. WHEELER DETAILER: I. ADAMS CHECKER: E. Barendse ENGINEER: VTAOT		PROJECT NAME: Bristol BR# 021-1(29) PROJECT #: 021-1(29) LOCATION: Bristol, VT	INSTALLER: S.D. Ireland Concrete 193 Industrial Ave Williston, VT 05495 03/17/2015	FABRICATOR: 193 INDUSTRIAL AVE. WILLISTON, VT 05495 Ph: (802) 658-0201		POST_TENSIONING_2	8_OF_16
		SD Ireland PRECAST											