


Reinforcing Schedule


Location	Mark	Description	Size	Spacing	Length	Qty.	A	B	C
CP Hook Bars	AS1401	2	#4	12"	67-1/8"	106*	30"	7-1/8"	30"
CP Sm Hook Bars	AS1402	2	#4	12"	66-1/8"	3	30"	6-1/8"	30"
AS#1/#4 T&B Mats	AS1501	Str	#5	12"	89-1/8"	79*	89-1/8"		
AS#2/#3 T&B Mats	AS1502	Str	#5	12"	87 1/2"	78	87 1/2"		
CP Hor Bars	AS1503	Str	#5	N/A	233-1/8"	12	233-1/8"		
Top Hor Bar	AS1601	Str	#6	12"	233"	34	233"		
Bottom Hor Hooks	AS1901	1	#9	10"	253-1/4"	36	233"	11-1/4"	9"
CP Hook Bars	AS2401	2	#4	12"	67-1/8"	105	30"	7-1/8"	30"
CP Sm Hook Bars	AS2402	2	#4	12"	66-1/8"	3	30"	6-1/8"	30"
AS#6/#8 T&B Mats	AS2501	Str	#5	12"	89-1/8"	80	89-1/8"		
AS#5/#7 T&B Mats	AS2502	Str	#5	12"	87 1/2"	76	87 1/2"		
CP Hor Bars	AS2503	Str	#5	N/A	233-1/8"	12	233-1/8"		
Top Hor Bar	AS2601	Str	#6	12"	233"	35*	233"		
Bottom Hor Hooks	AS2901	1	#9	10"	253-1/4"	37**	233"	11-1/4"	9"

*One Bar Added for Testing

Rebar Bend Types

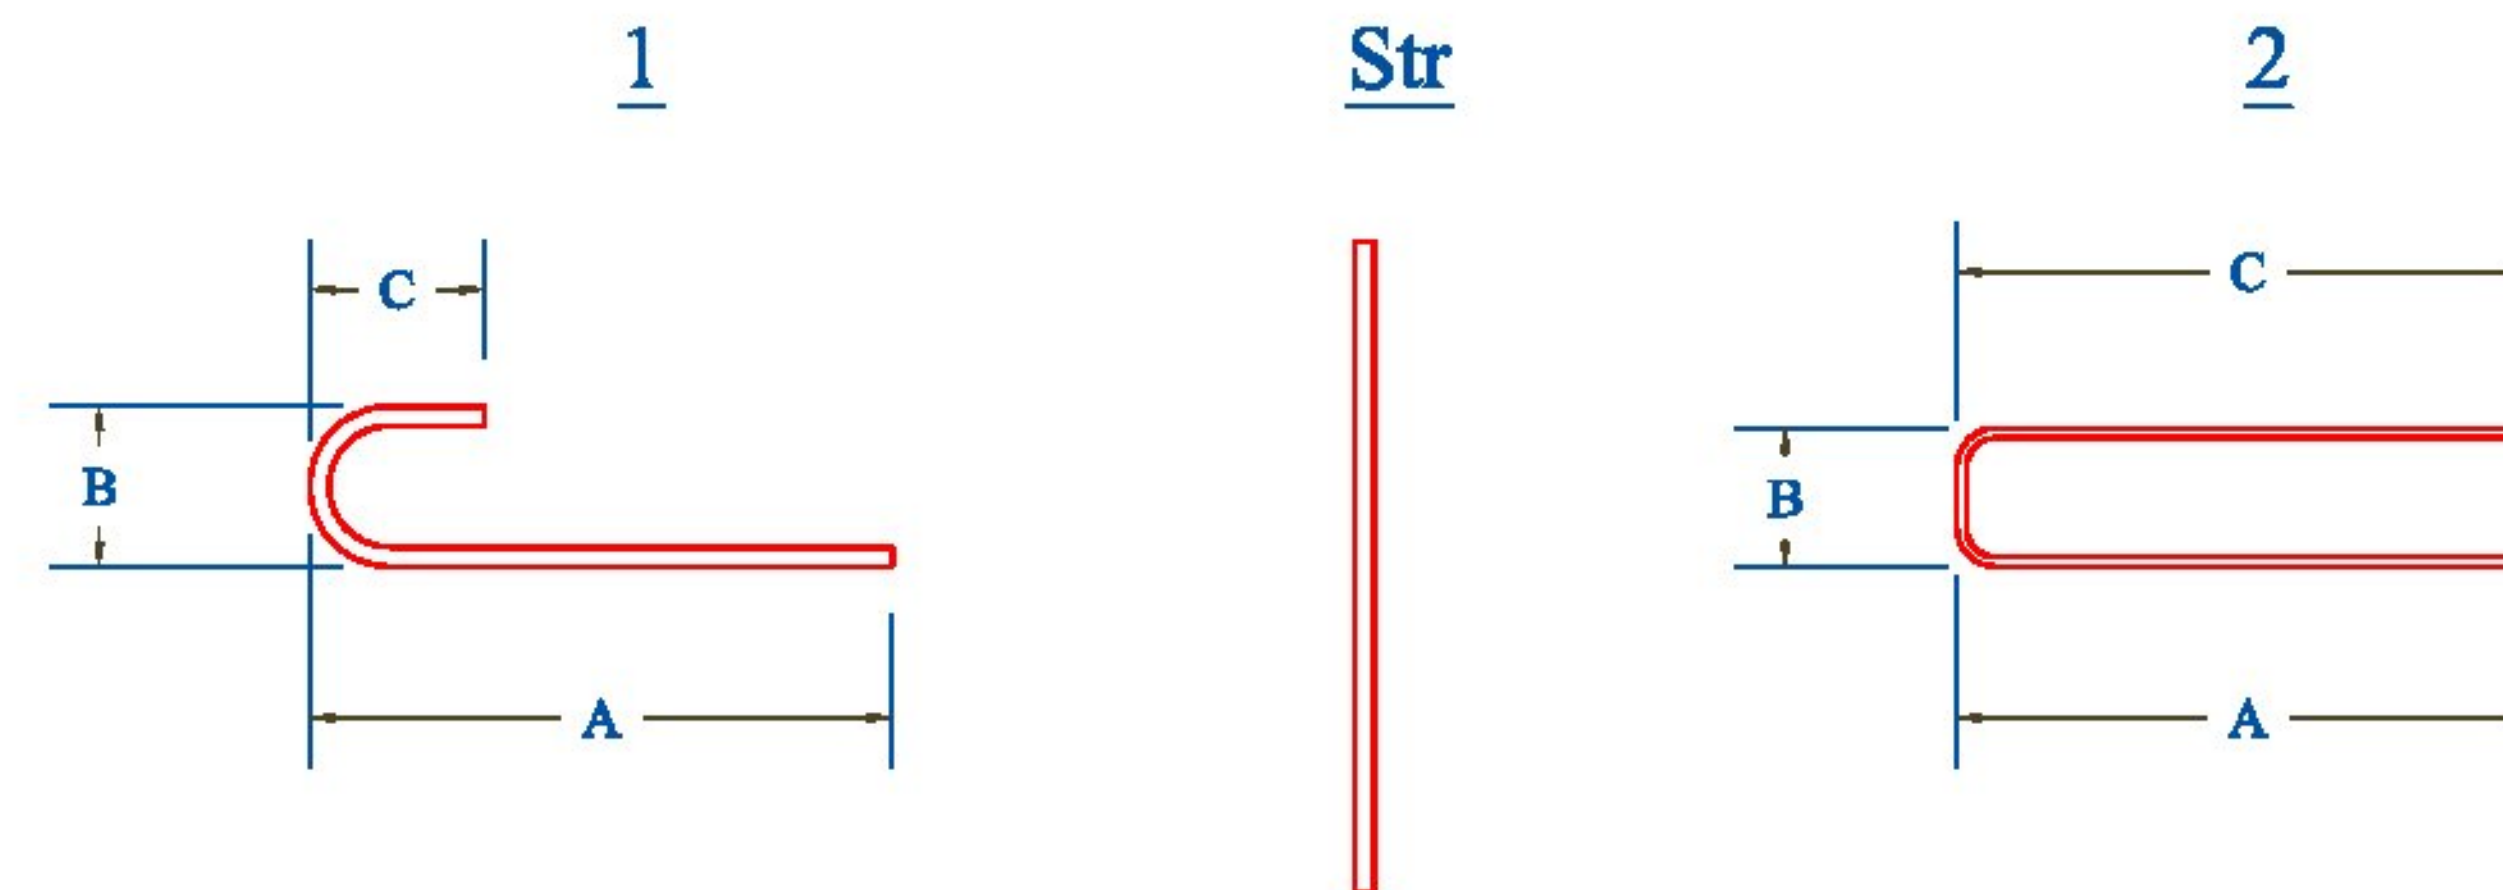

Std. Bar Bend Ø	
Bar #	Bend Ø
#4	3"
#5	3 3/4"
#6	4 1/2"
#9	9 1/2"

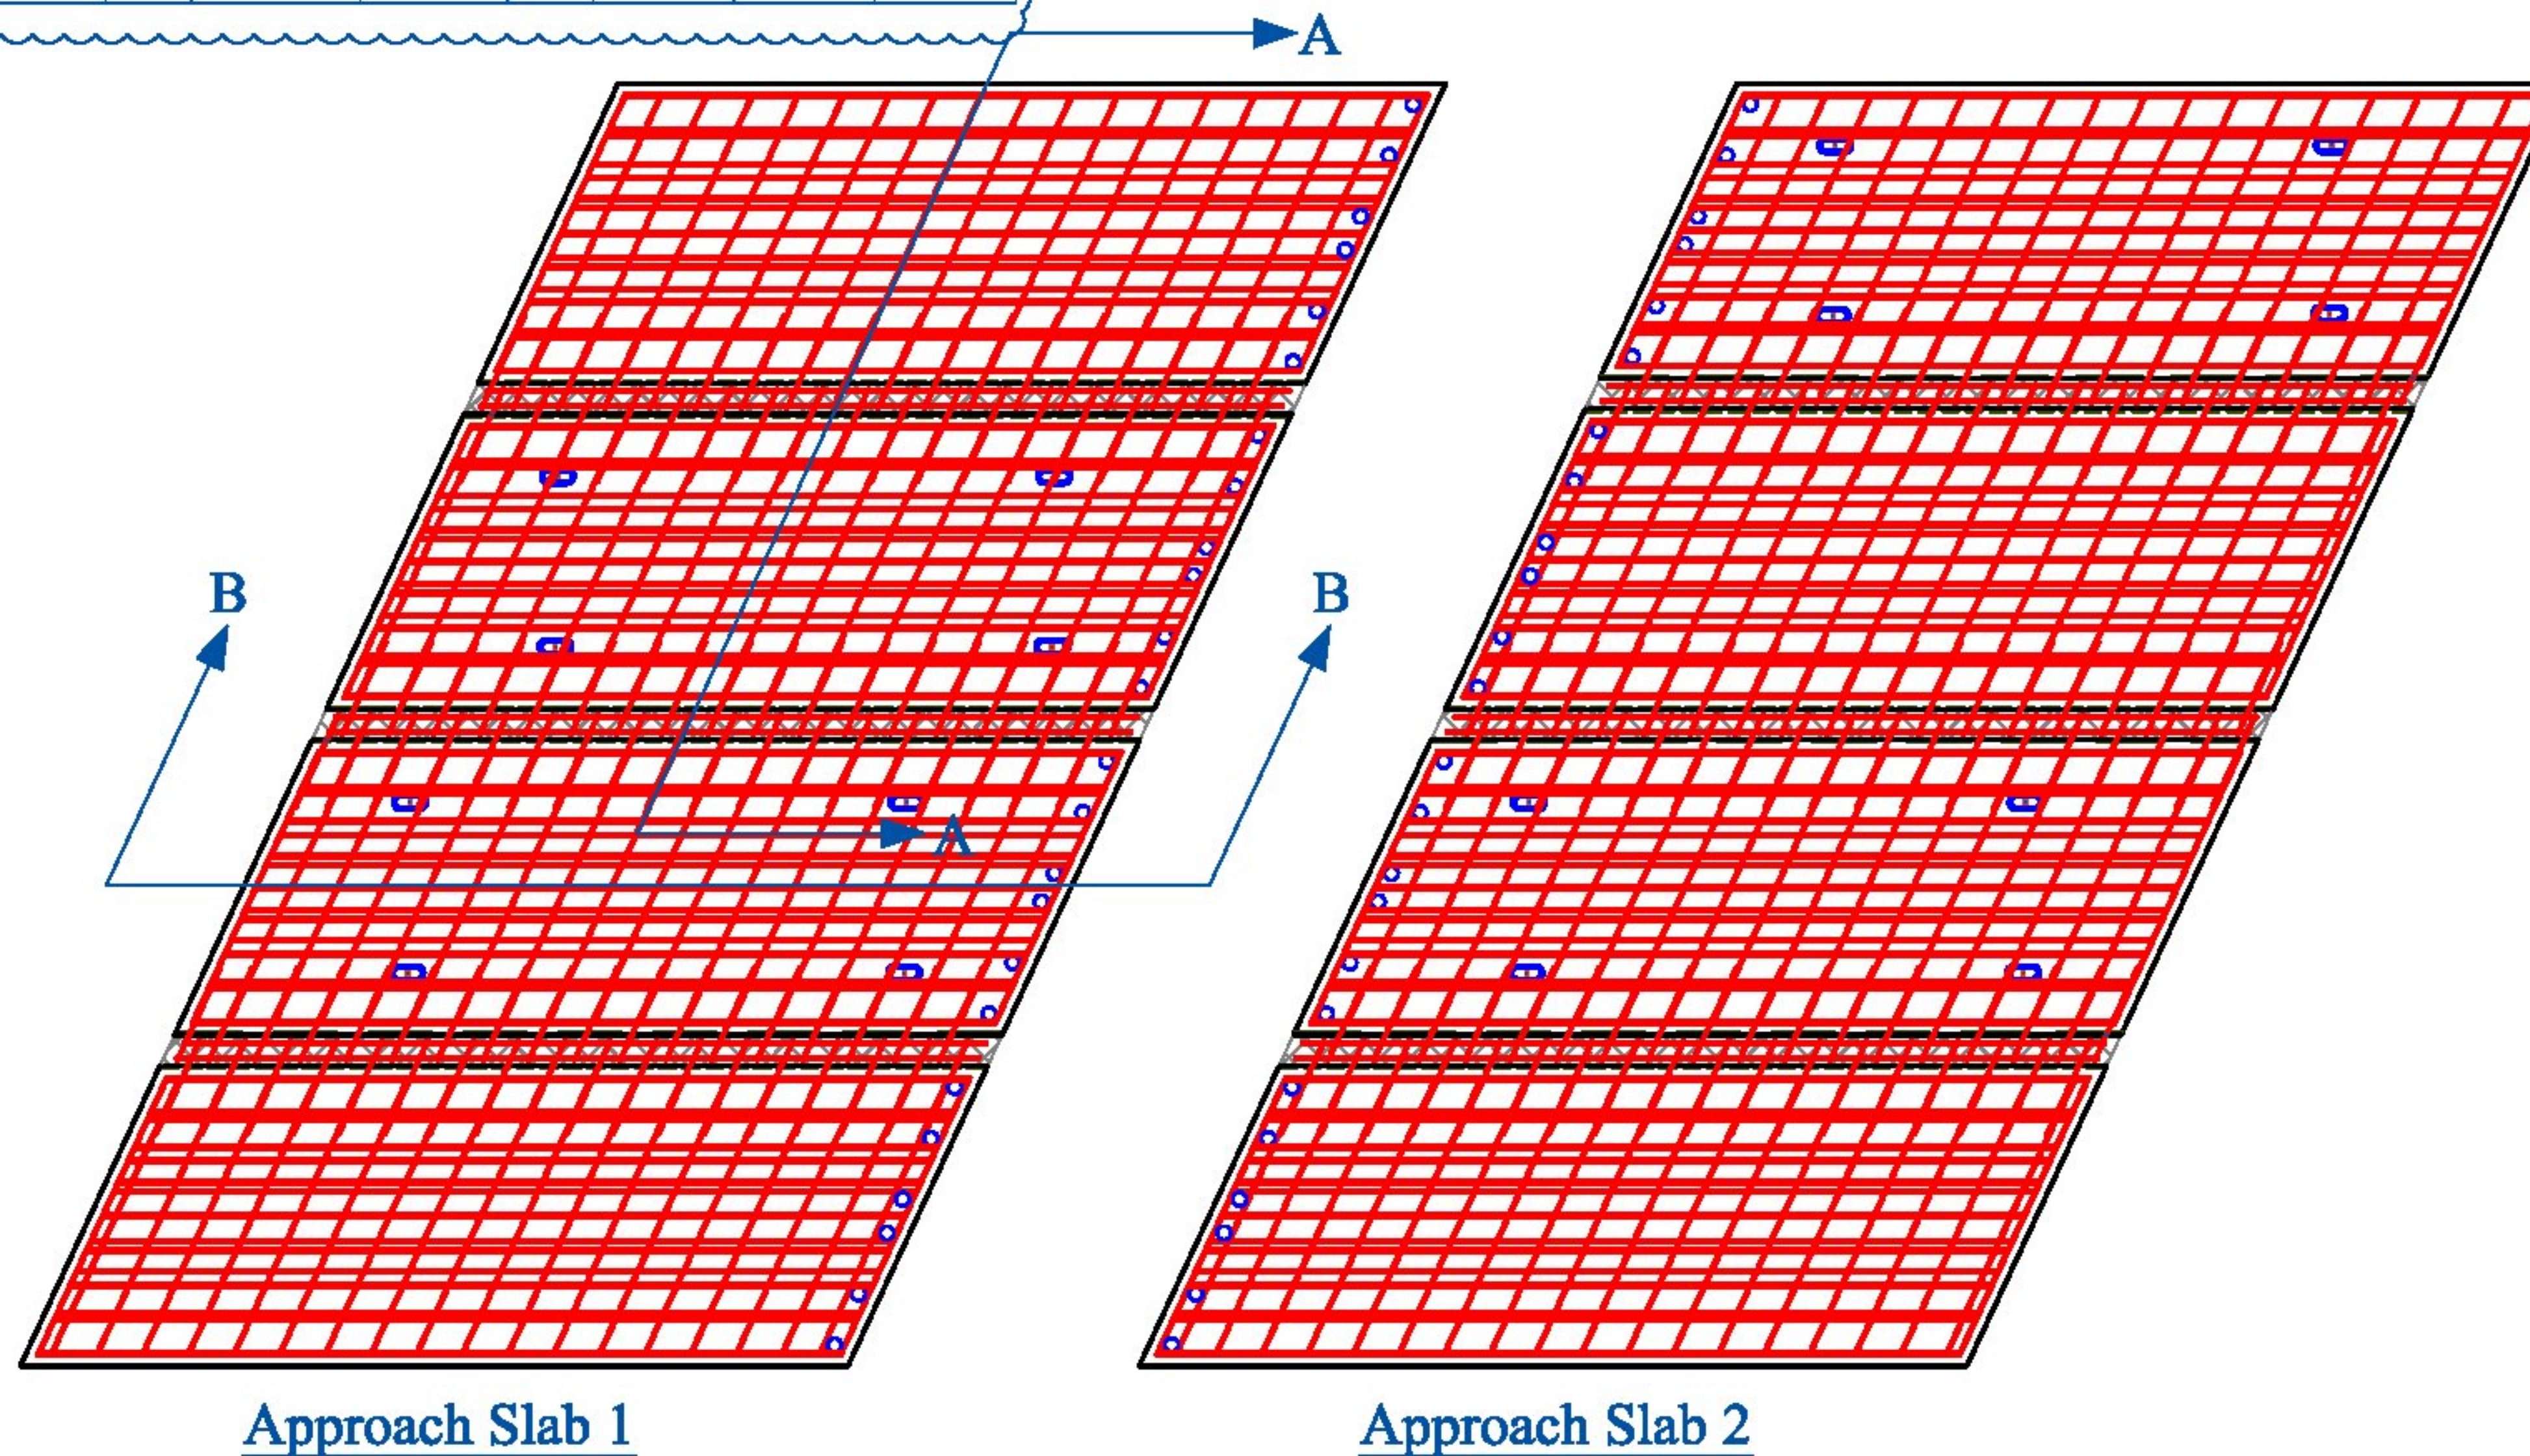

Vermont Agency of Transportation
RECEIVED
 CK'D BY MEM OK'D BY CWC
 May 29, 2015
 RESUBMIT APPROVED ✓
 BY C. Carlson DATE 05-29-2015

CONTRACTORS VISPE	Rev. 1 04/09/15 IBA	Date 04/16/15	By IBA	Description Changes per State Review	PRECAST CONCRETE APPROACH SLAB SHOP DRAWINGS (SDI JOB #15738)	INSTALLER: S.D. Ireland 183 Industrial Ave Williston, VT 05495	FABRICATOR: 193 INDUSTRIAL AVE. WILLISTON, VT 05495 Ph: (802) 658-0201
	Rev. 2		IBA	Changes per State Changes Received 04/13/15	SUPERVISOR: E. Barendse DETAILER: I. ADAMS CHECKER: E. Barendse ENGINEER: X	PROJECT NAME: Bristol BRP 021-1(29) PROJECT #: 021-1(29) LOCATION: Bristol, VT	SD Ireland PRECAST
					03/17/2015	BAR_PLAN	5_OF_10