
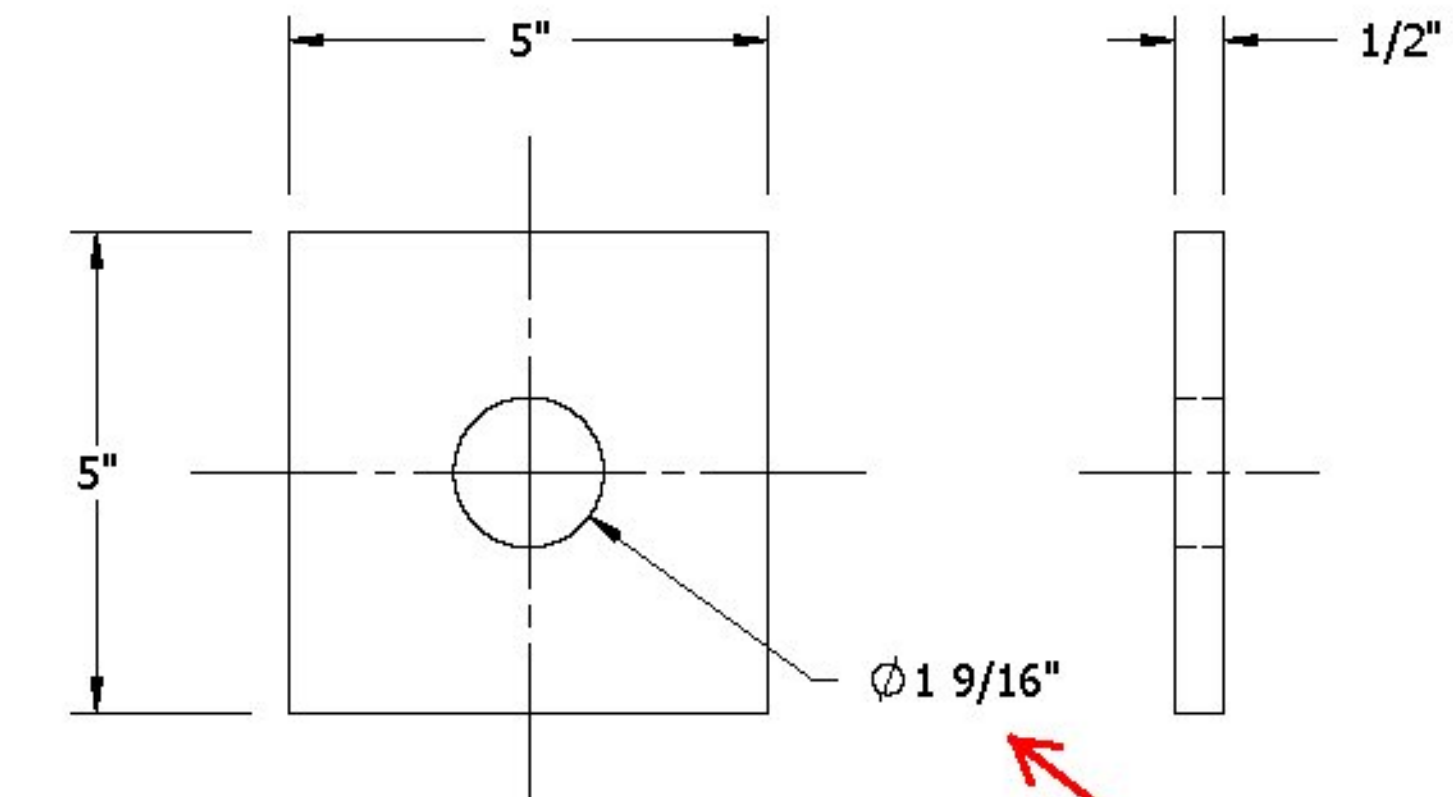


TOLERANCES:

- ANCHOR ROD LENGTH.....-0, +1/4"
- WASHER:
 - VERTICAL..... ± 1/16"
 - HORIZONTAL..... ± 1/4"
 - FLATNESS..... 0.001 x NOMINAL
 - HOLE/SLOT POSITION..... ± 1/16"
 - HOLE/SLOT SIZE..... -0, +1/16"

GALVANIZE: PER ASTM A123 OR A153 AS APPLICABLE.

REVISIONS			
REV.	DESCRIPTION	BY	DATE
A	SUBMITTAL	AL	3/25/2015

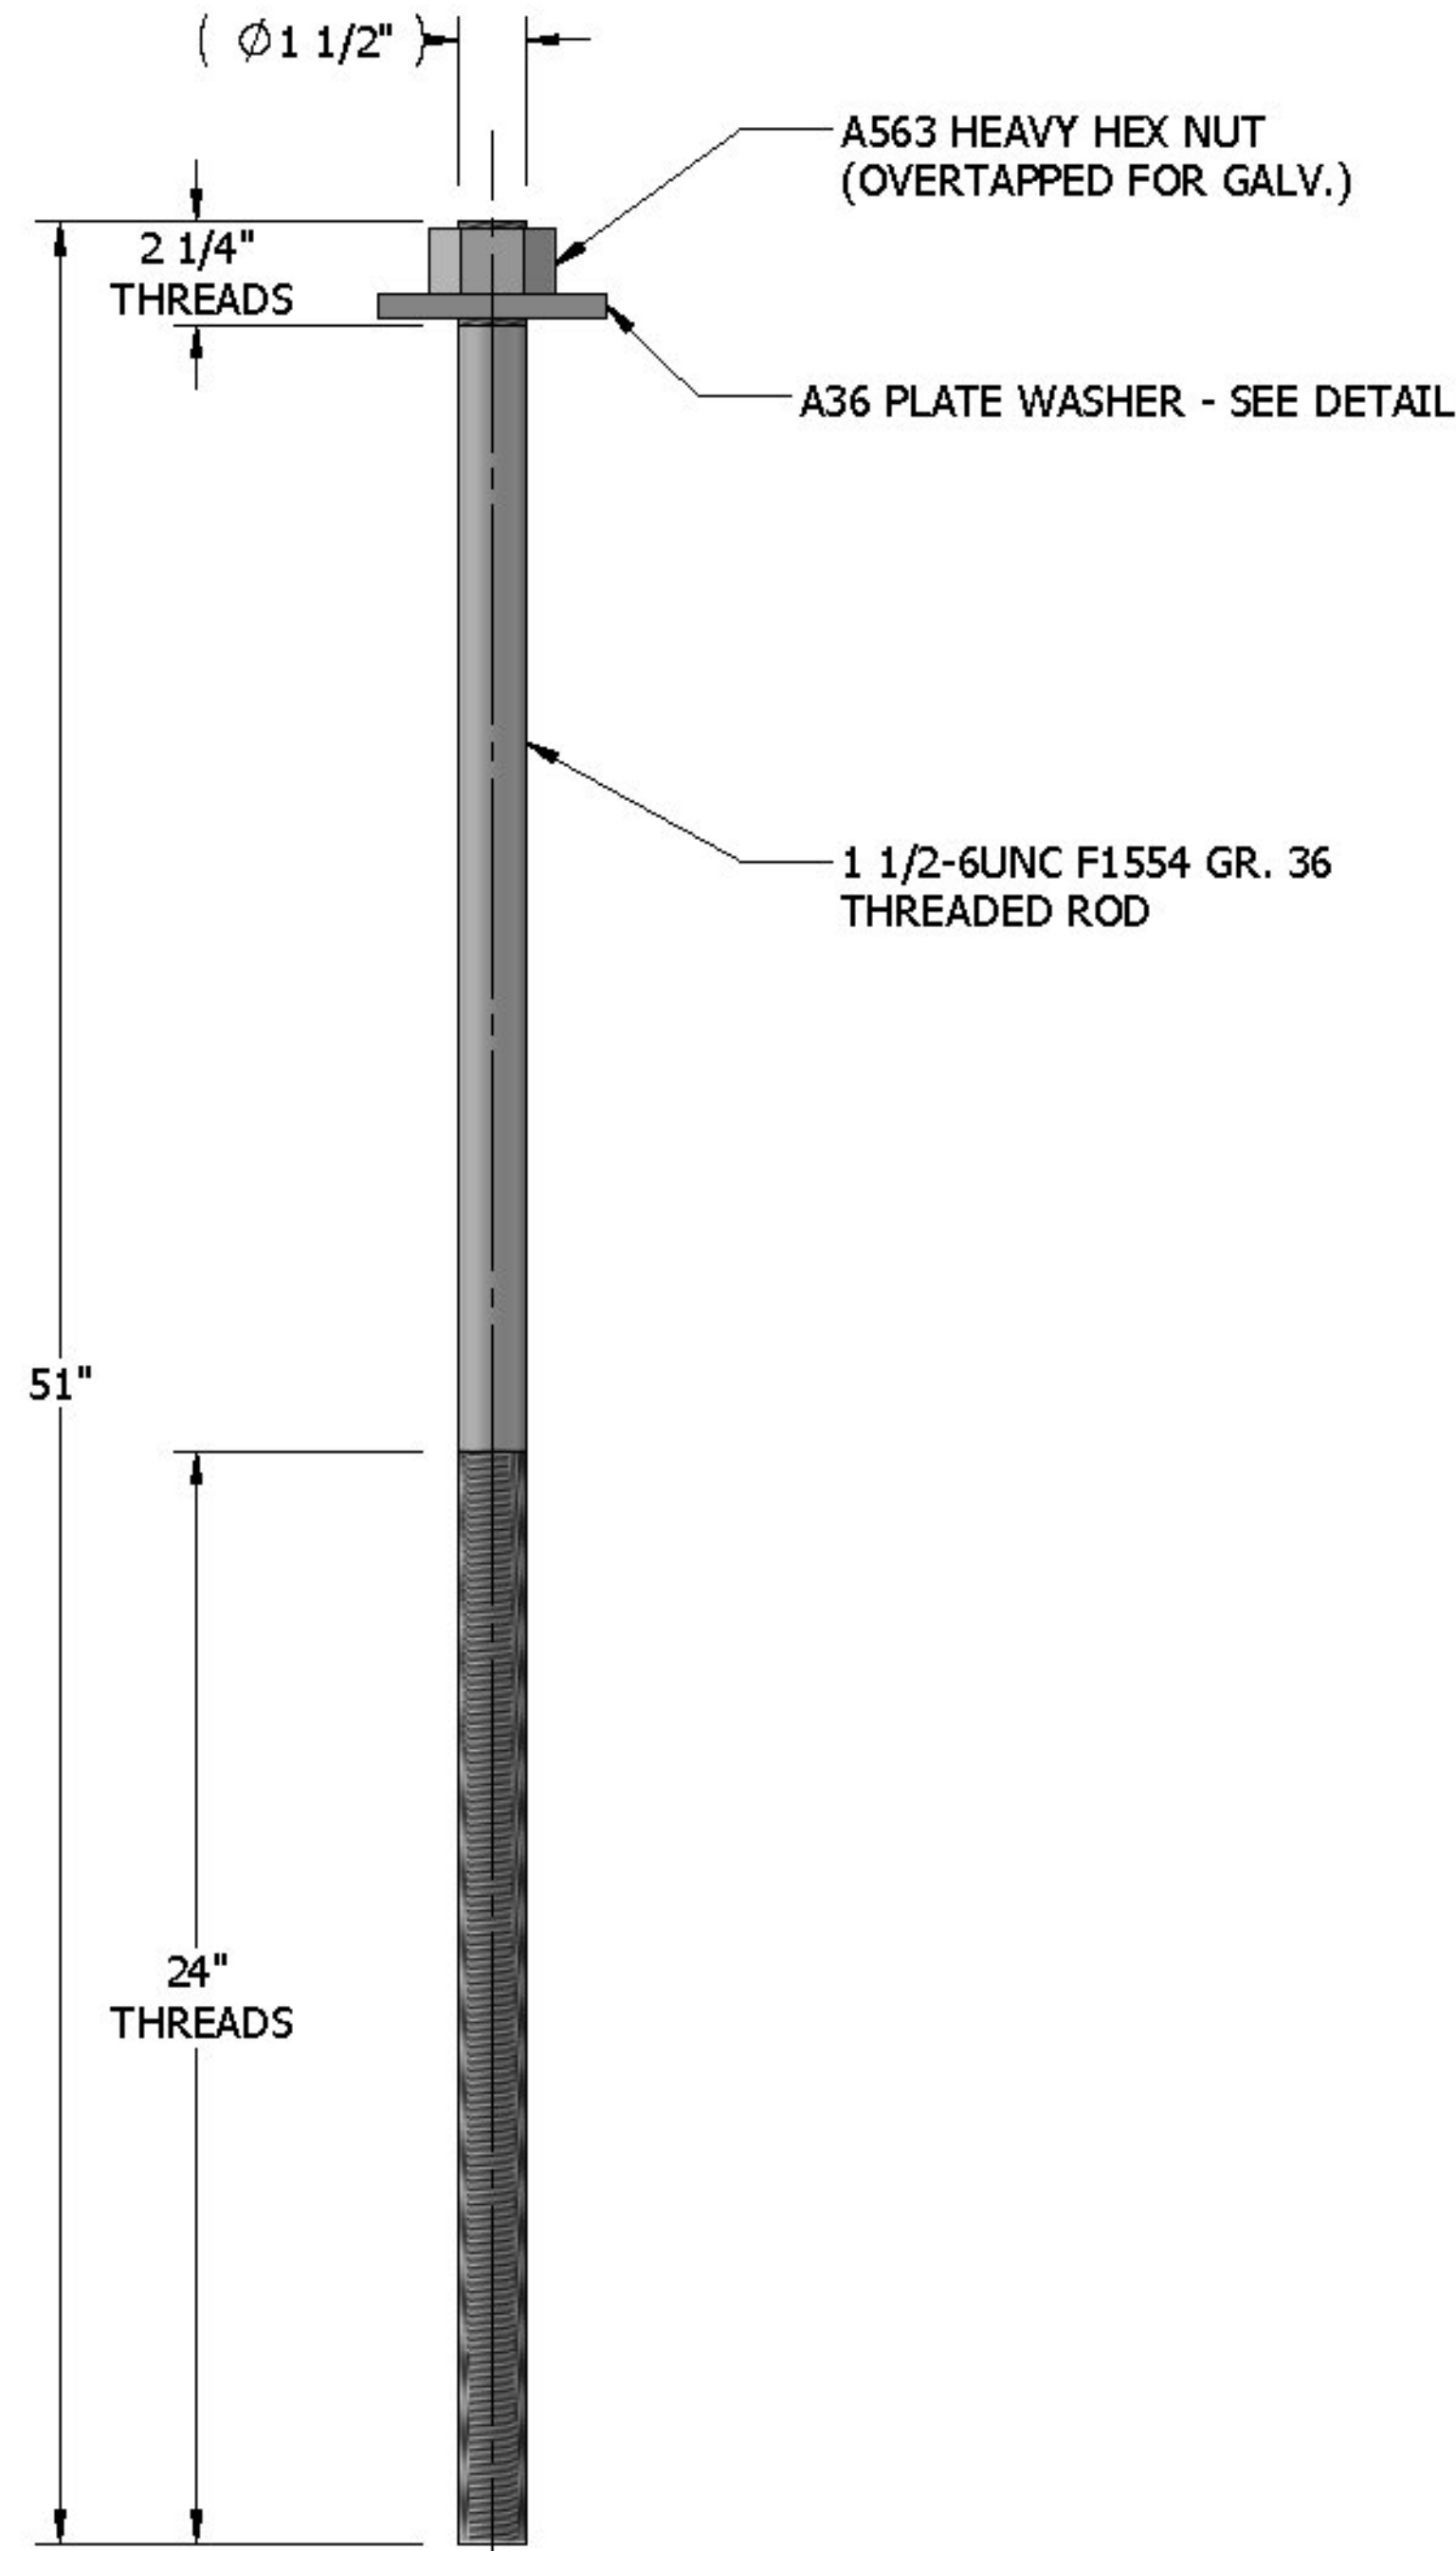

we specify 1.5" hole

**MK.02
ANCHOR RODS
GALVANIZED
(18) REQ'D**

ALL DIMENSIONS ARE IN INCHES
UNLESS OTHERWISE SPECIFIED

NOTE

INFORMATION SET FORTH IN THIS DRAWING IS PROPRIETARY WITH Seismic Energy Products, Inc. THIS DRAWING SHALL NOT BE REPRODUCED, COPIED, LOANED OR SUBMITTED TO OUTSIDE PARTIES FOR EXAMINATION WITHOUT OUR CONSENT EXCEPT FOR THE PURPOSE FOR WHICH IT WAS INTENDED.

SEP Seismic Energy Products, Inc.
STRUCTURAL BEARINGS FOR BRIDGES & BUILDINGS
ATHENS, TX PHONE: 903-675-8571

BEARING ASSY FOR:
STATE OF VERMONT AGENCY OF TRANSPORTATION
BRISTOL

CONTRACTOR: **S.D. IRELAND BROTHERS CORP**

BRIDGE NO.	6
COUNTY	ADDISON
PROJECT NO.	BRF 021-1(29)

DRAWN	ALUTTRELL	DATE	3/17/15	PO #	S. QT.
CHECKED		DATE		SO NO. & ST.	61921 VT
REVIEWED		DATE		SHEET 2 OF 2	