


EM - NC1  
(20) REQ'D. 3' = 1'-0"

MISCELLANEOUS MATERIALS				
ITEM	MARK	QTY.	DESCRIPTION	REMARKS
1	EM-NC1	20	1" THICK x 6' x 6' W/ (2) 3/4" HOLES (GALV.)	FOR ERECTION; SEE DETAIL THIS SHEET
2		40	1/2" SINGLE USE STRESSING CHUCK	FOR ERECTION
3		20	1/2" x 270 KSI x 41'-4" LONG POLYSTRAND	FOR ERECTION
4		80	COMPRESSIBLE SEALER SELF ADHESIVE	FOR ERECTION
5				
6				
7		24	#4 x 2'-10" (LEVEL II, DUAL COATED)	
8		192	#4 x 3'-11" (LEVEL II, DUAL COATED)	
9				
10		4	#5 x 4'-10" (LEVEL II, DUAL COATED)	
11				
12		208	3/4" x 6" NON-FERROUS VOID DRAIN	
13		104	10" x 8'-2 7/8" VOID	
14		14	GUARD RAIL ANCHOR PLATE (GALV.)	SUPPLIED BY OTHERS
15		40	SET OF (4) 1/2" STRAND LIFTING LOOPS	
16				
17				
18				
19				
20				

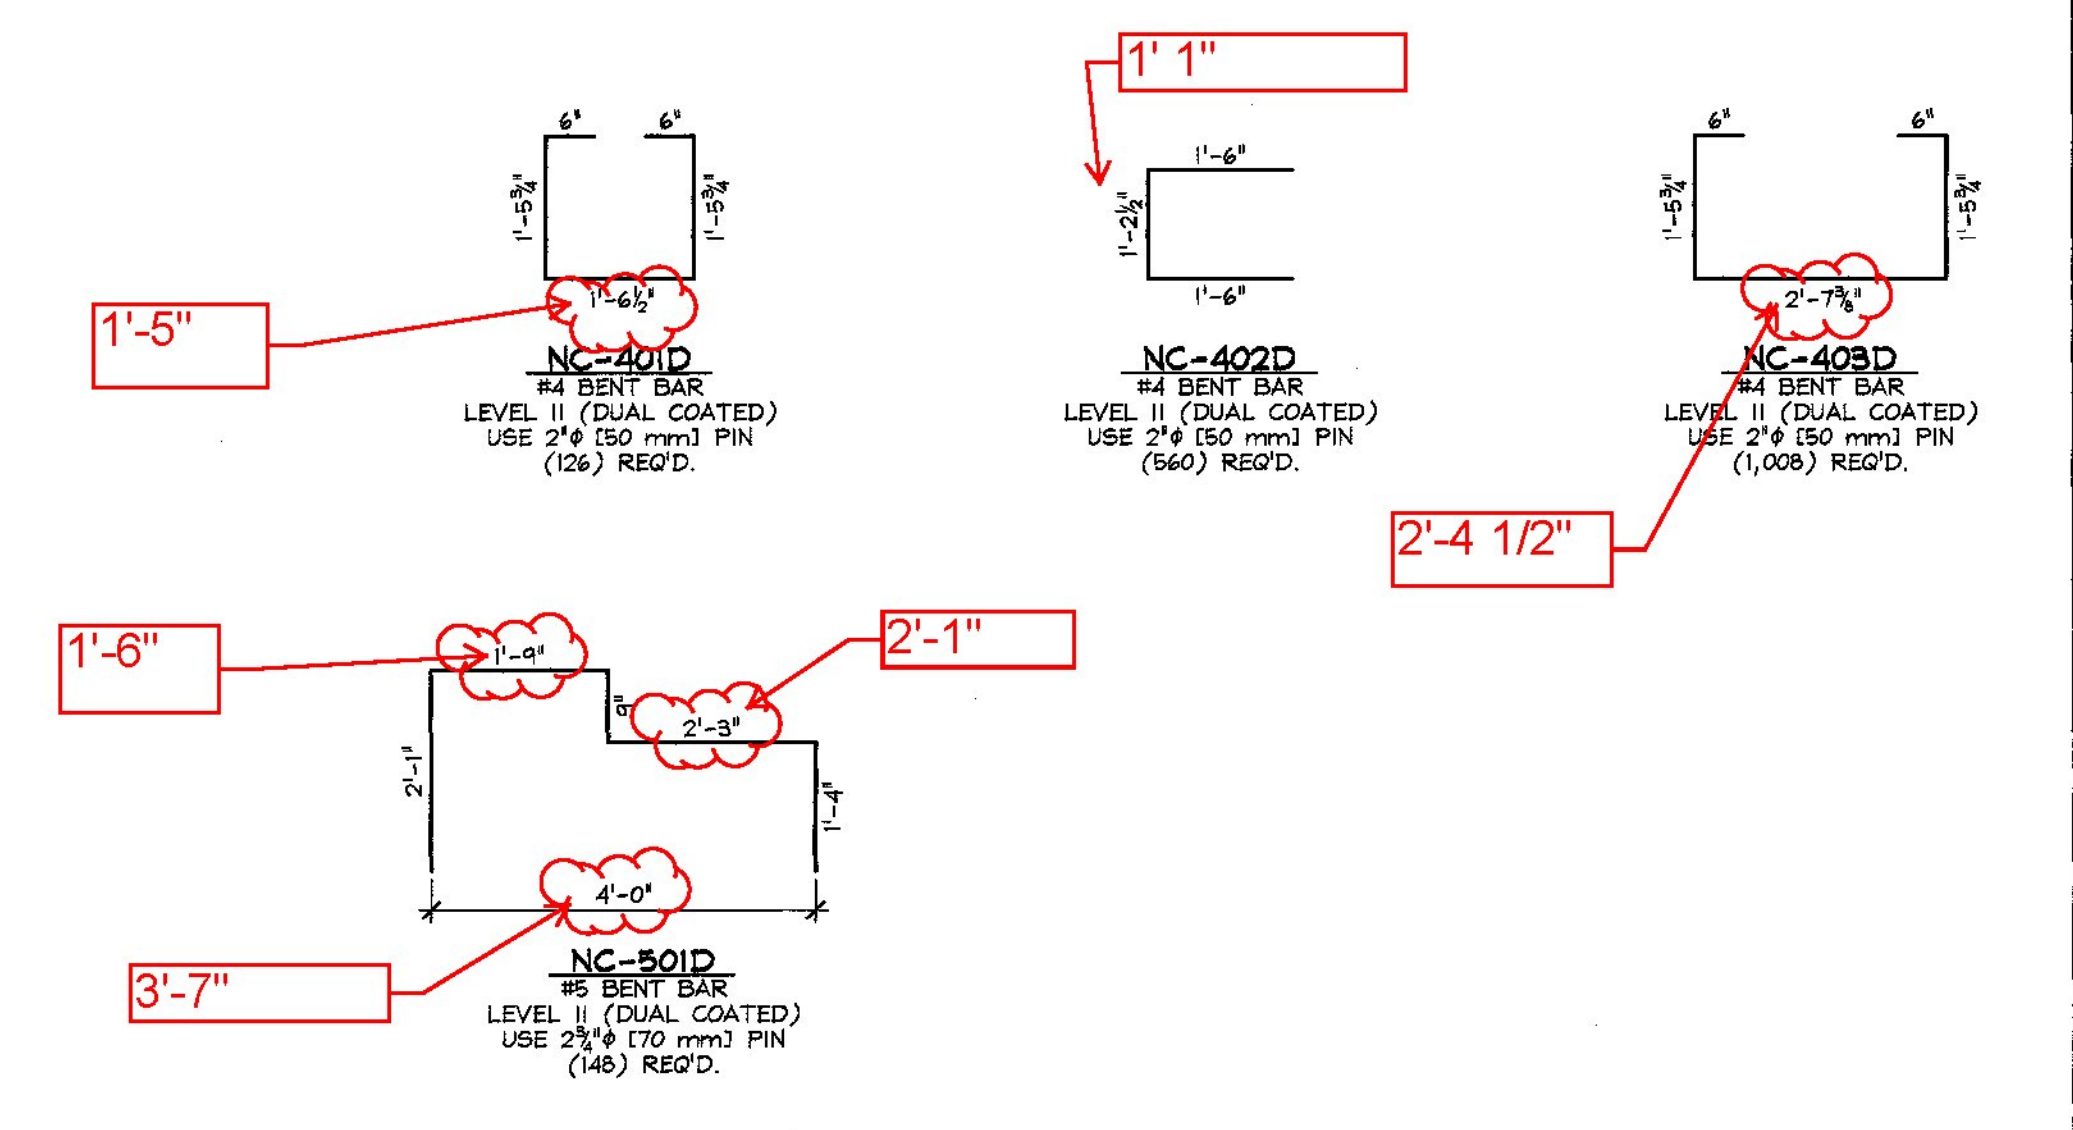

APPROVAL STAMP:  Vermont Agency of Transportation <b>RECEIVED</b> CK'D BY MEM OK'D BY CWC Mar. 16, 2015 RESUBMIT APPROVED AS NOTED ✓ BY C. Carlson DATE 03-27-2015	<b>J.P. CARRARA &amp; SONS INC.</b> Precast & Prestress Manufacturer <small>2464 GAGE ST. MIDDLEBURY, VERMONT 05753 Phone: (802)388-6361 Fax: (802)388-9010</small>	S.D. IRELAND CONCRETE CONSTRUCTION CORP. SOUTH BURLINGTON, VERMONT
	STATE OF VERMONT AGENCY OF TRANSPORTATION COUNTY OF ADDISON	DATE: MAR. 6, 2015 SCALE: NOTED
TOWN OF BRISTOL VT RT. 116 (MINOR ARTERIAL) OVER LITTLE NOTCH CREEK BRIDGE NO.: 6 PROJECT NO.: BRF 021-1(24)		DWG. NO: <b>M1</b>
<b>MATERIALS LIST</b>		