



**TYPICAL SECTION - ALTERNATE A**  
**PAVER PLACED SURFACE TREATMENT TYPE C**  
**US RTE. 4 EASTBOUND MM 0.190 - MM 18.805**  
**US RTE. 4 WESTBOUND MM 0.594 - MM 18.805**  
 0.195  
 0.578

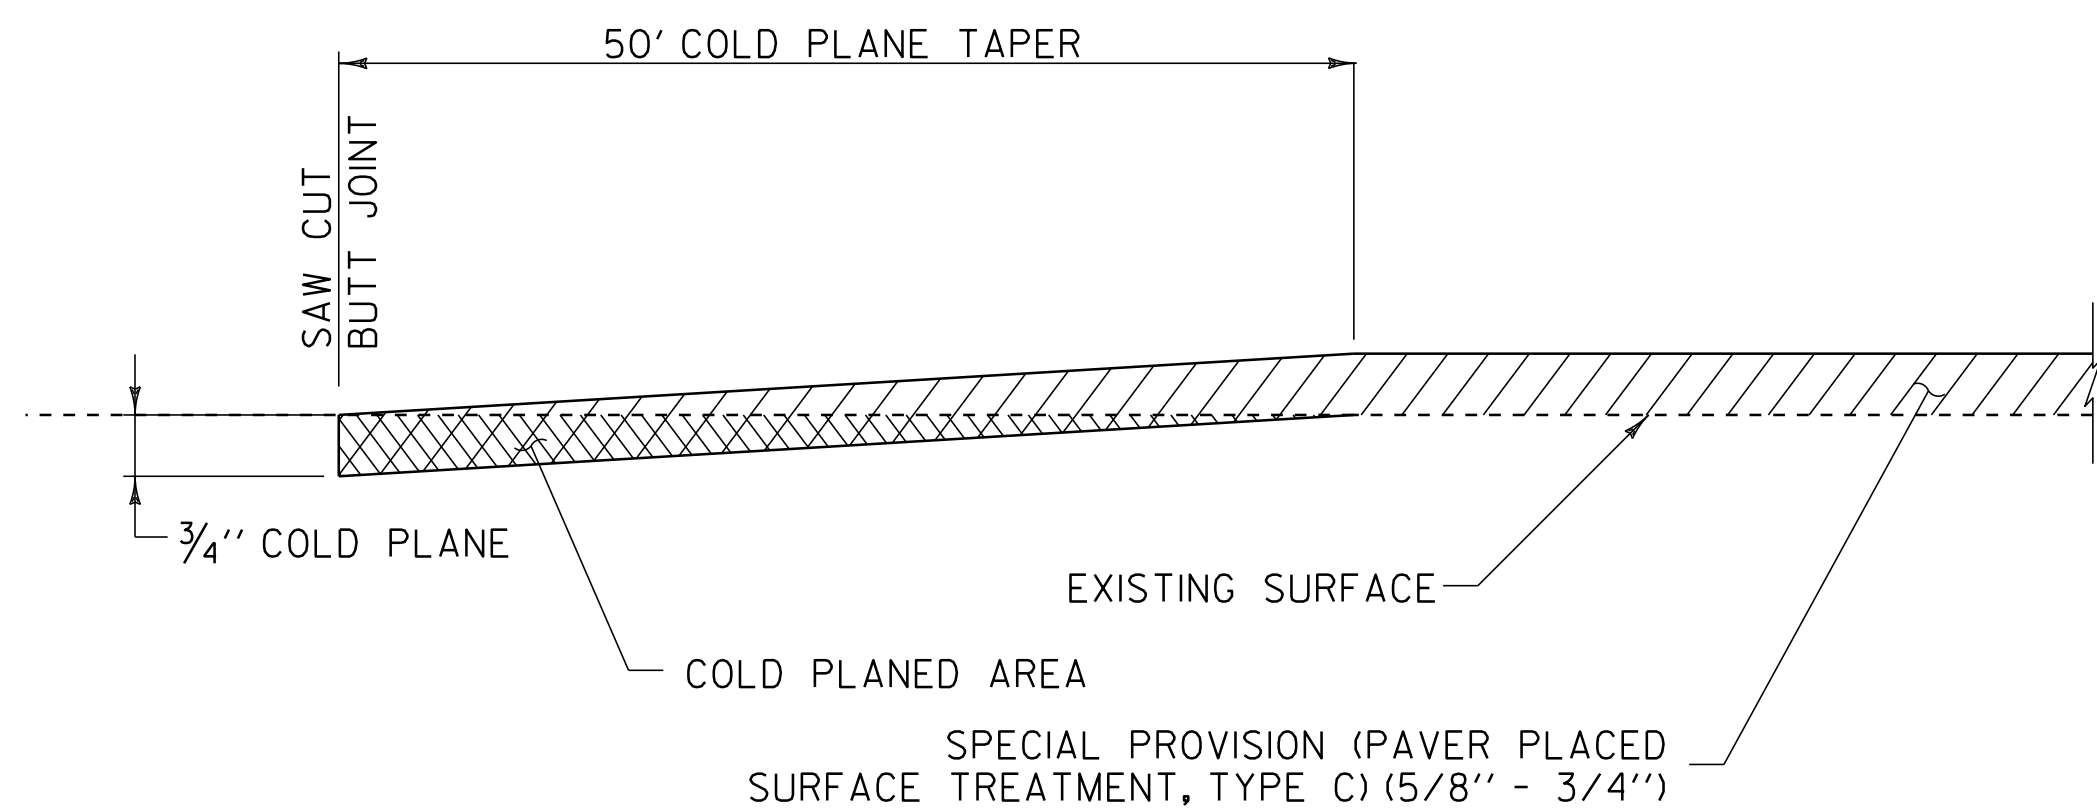


**COLD PLANE DETAIL AT BEGIN/END PROJECT & RAMPS**

NOTES:  
 1. SURFACE PREPARATION IS REQUIRED ON ALL RAMPS.

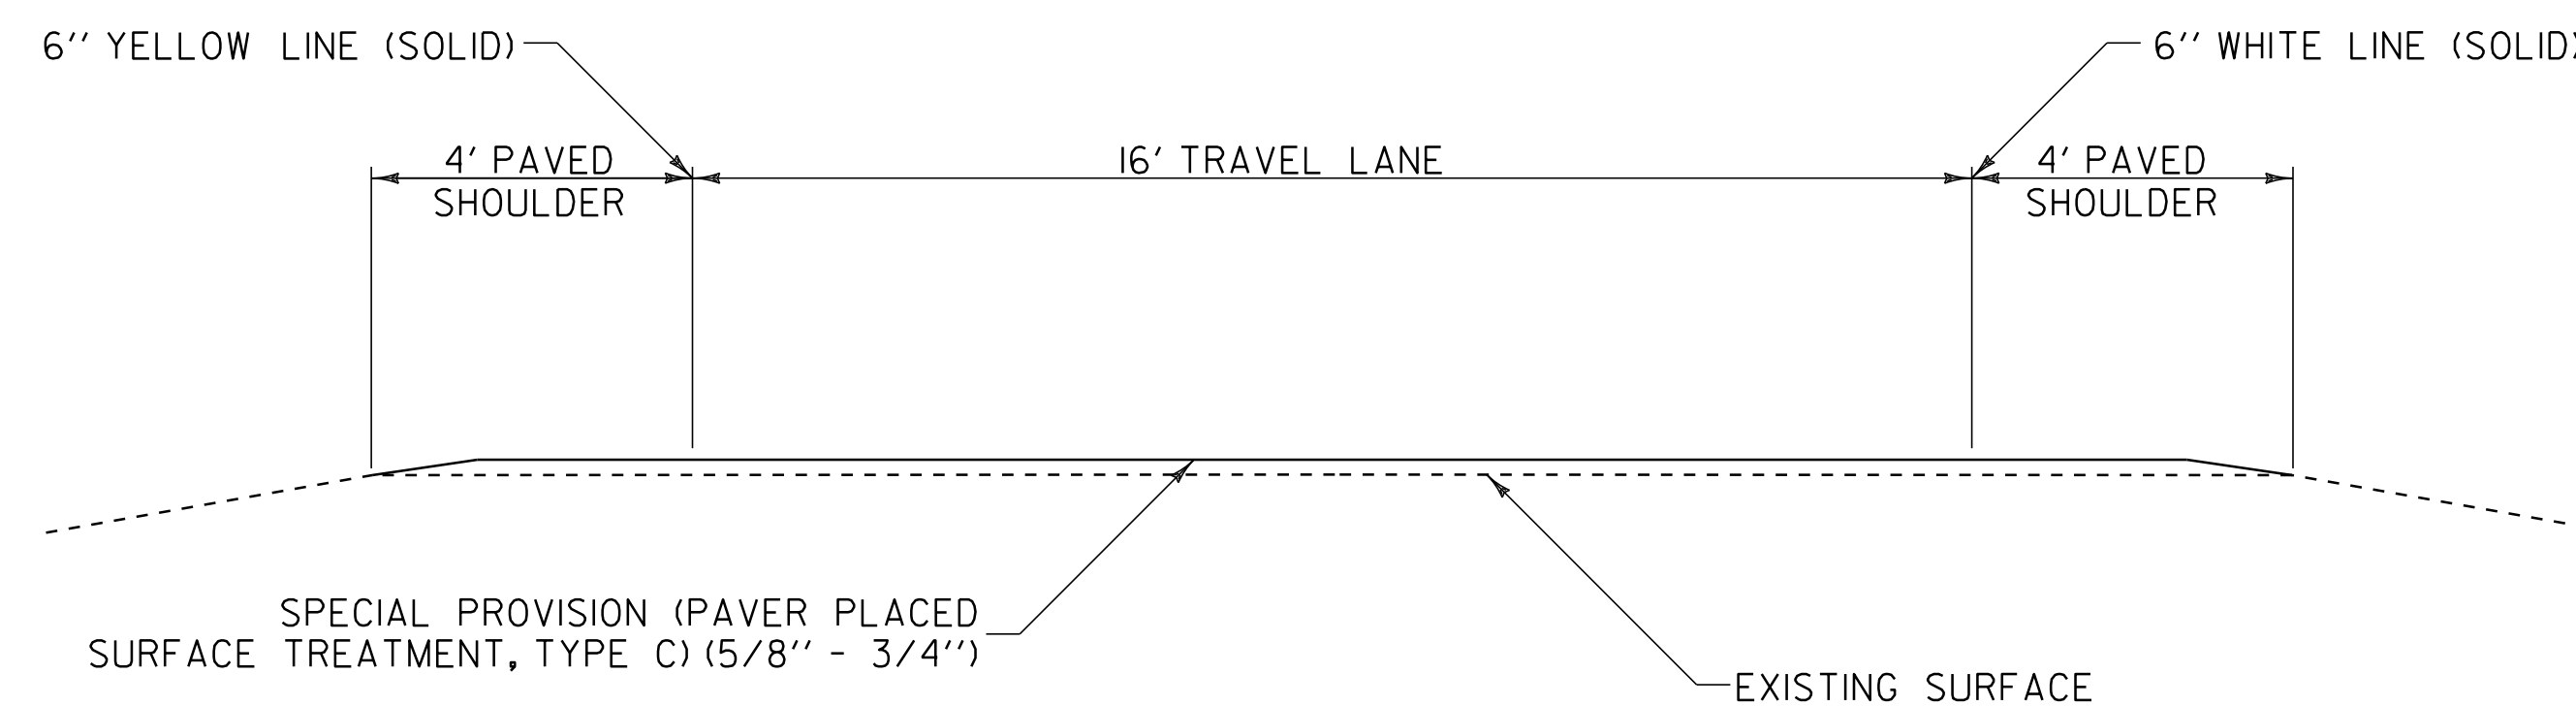

**TYPICAL RAMP SECTION**

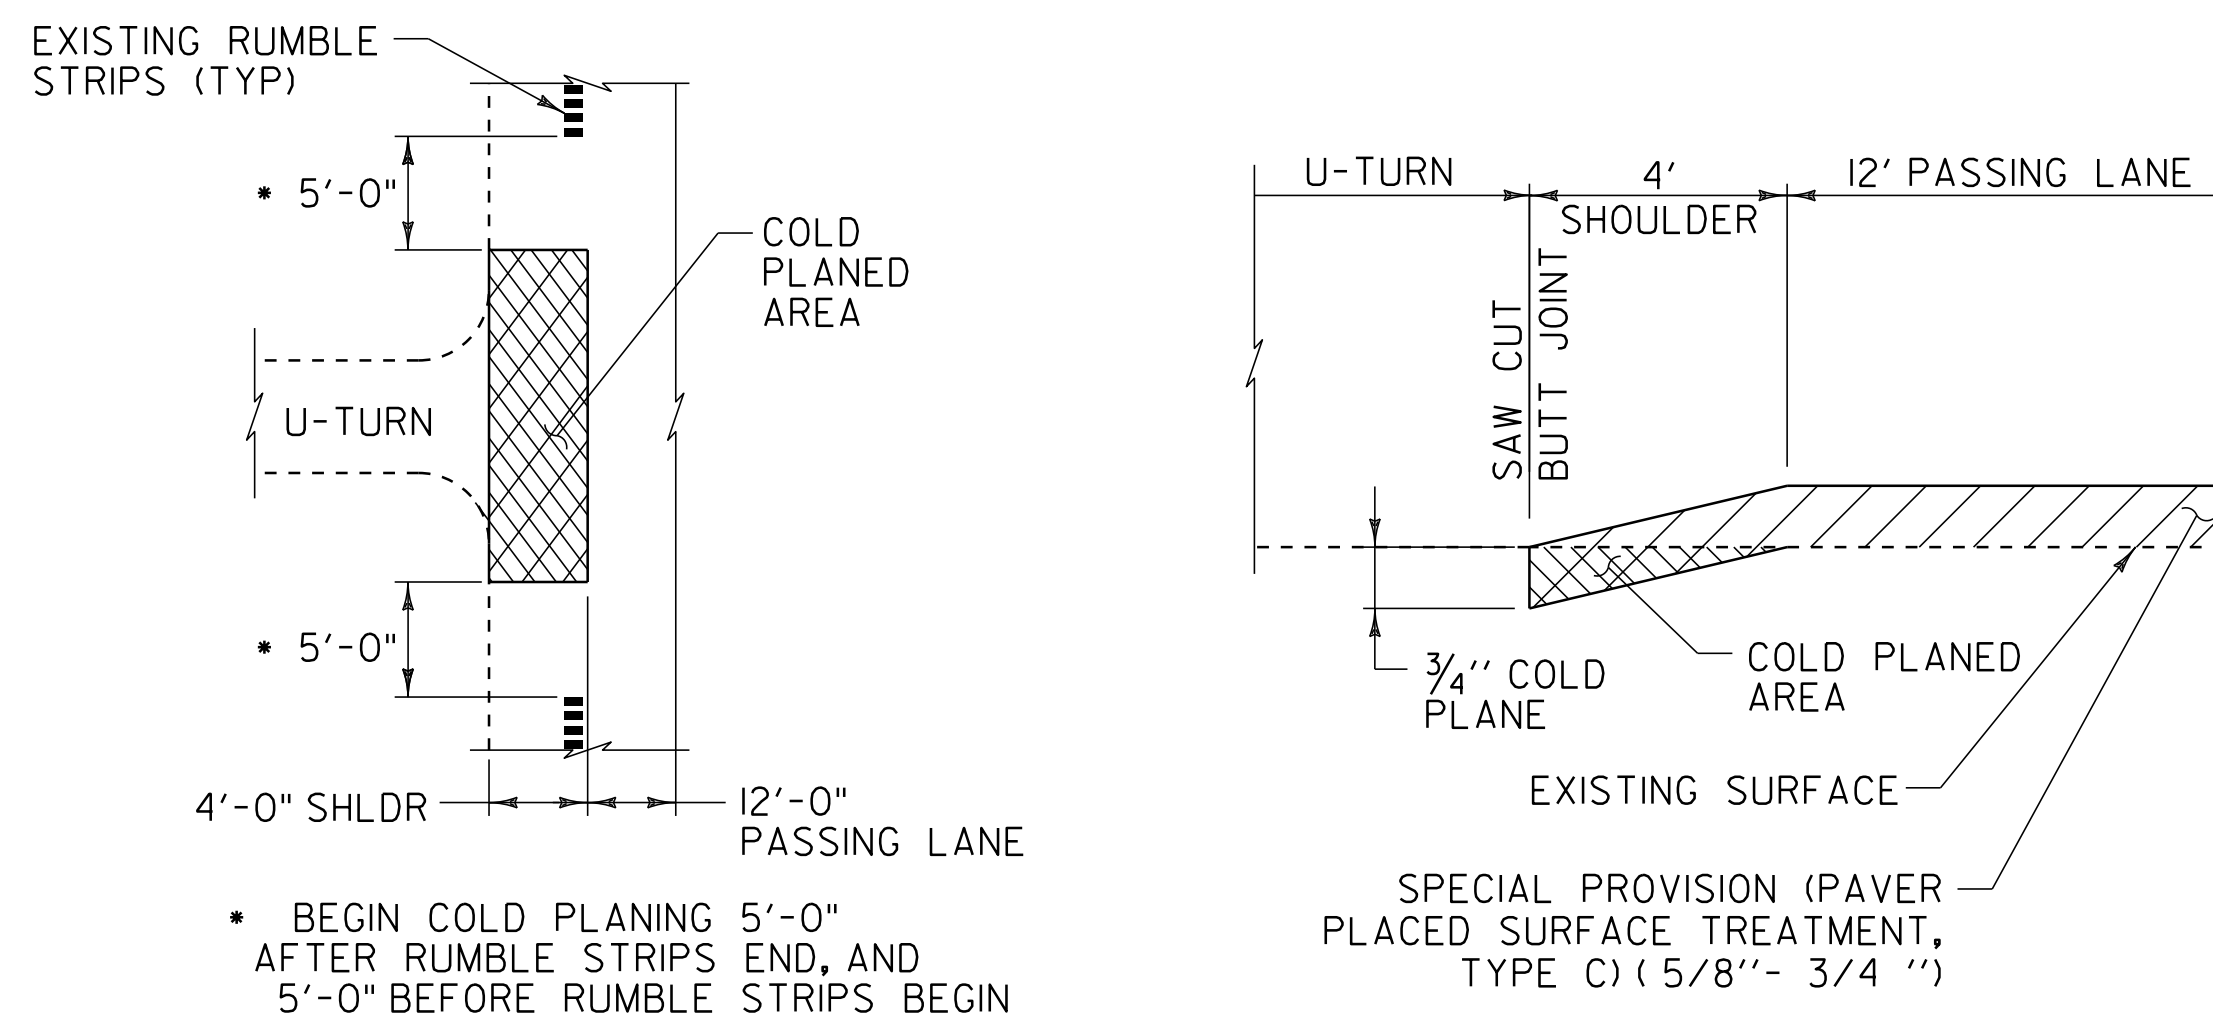

\* BEGIN COLD PLANING 5'-0" AFTER RUMBLE STRIPS END, AND 5'-0" BEFORE RUMBLE STRIPS BEGIN

**COLD PLANE DETAIL AT U-TURNS**

**NOT TO SCALE**

**ALTERNATE A  
 TYPICAL  
 SECTIONS**

PROJECT NAME: FAIR HAVEN-RUTLAND TOWN  
 PROJECT NUMBER: NH SURF (22)  
 FILE NAME: 10b106/10b106.dgn  
 PROJECT LEADER: M. FOWLER  
 DESIGNED BY: PVT. MGT.  
 IPARM FILE NAME: 10B106\*3.1  
 PLOT DATE: 23-MAY-2013 11:41  
 DRAWN BY: PVT. MGT.  
 CHECKED BY: PVT. MGT.  
 SHEET 3 OF 24