


CHANGED LIMIT OF TREATMENT AND PAVEMENT MARKINGS DUE TO CONFLICT WITH ANOTHER PROJECT:
 * CASTLETON, CASTLETON, CASTLETON-WEST RUTLAND AC STP 2908, AC STP 2909, AC STP 2705

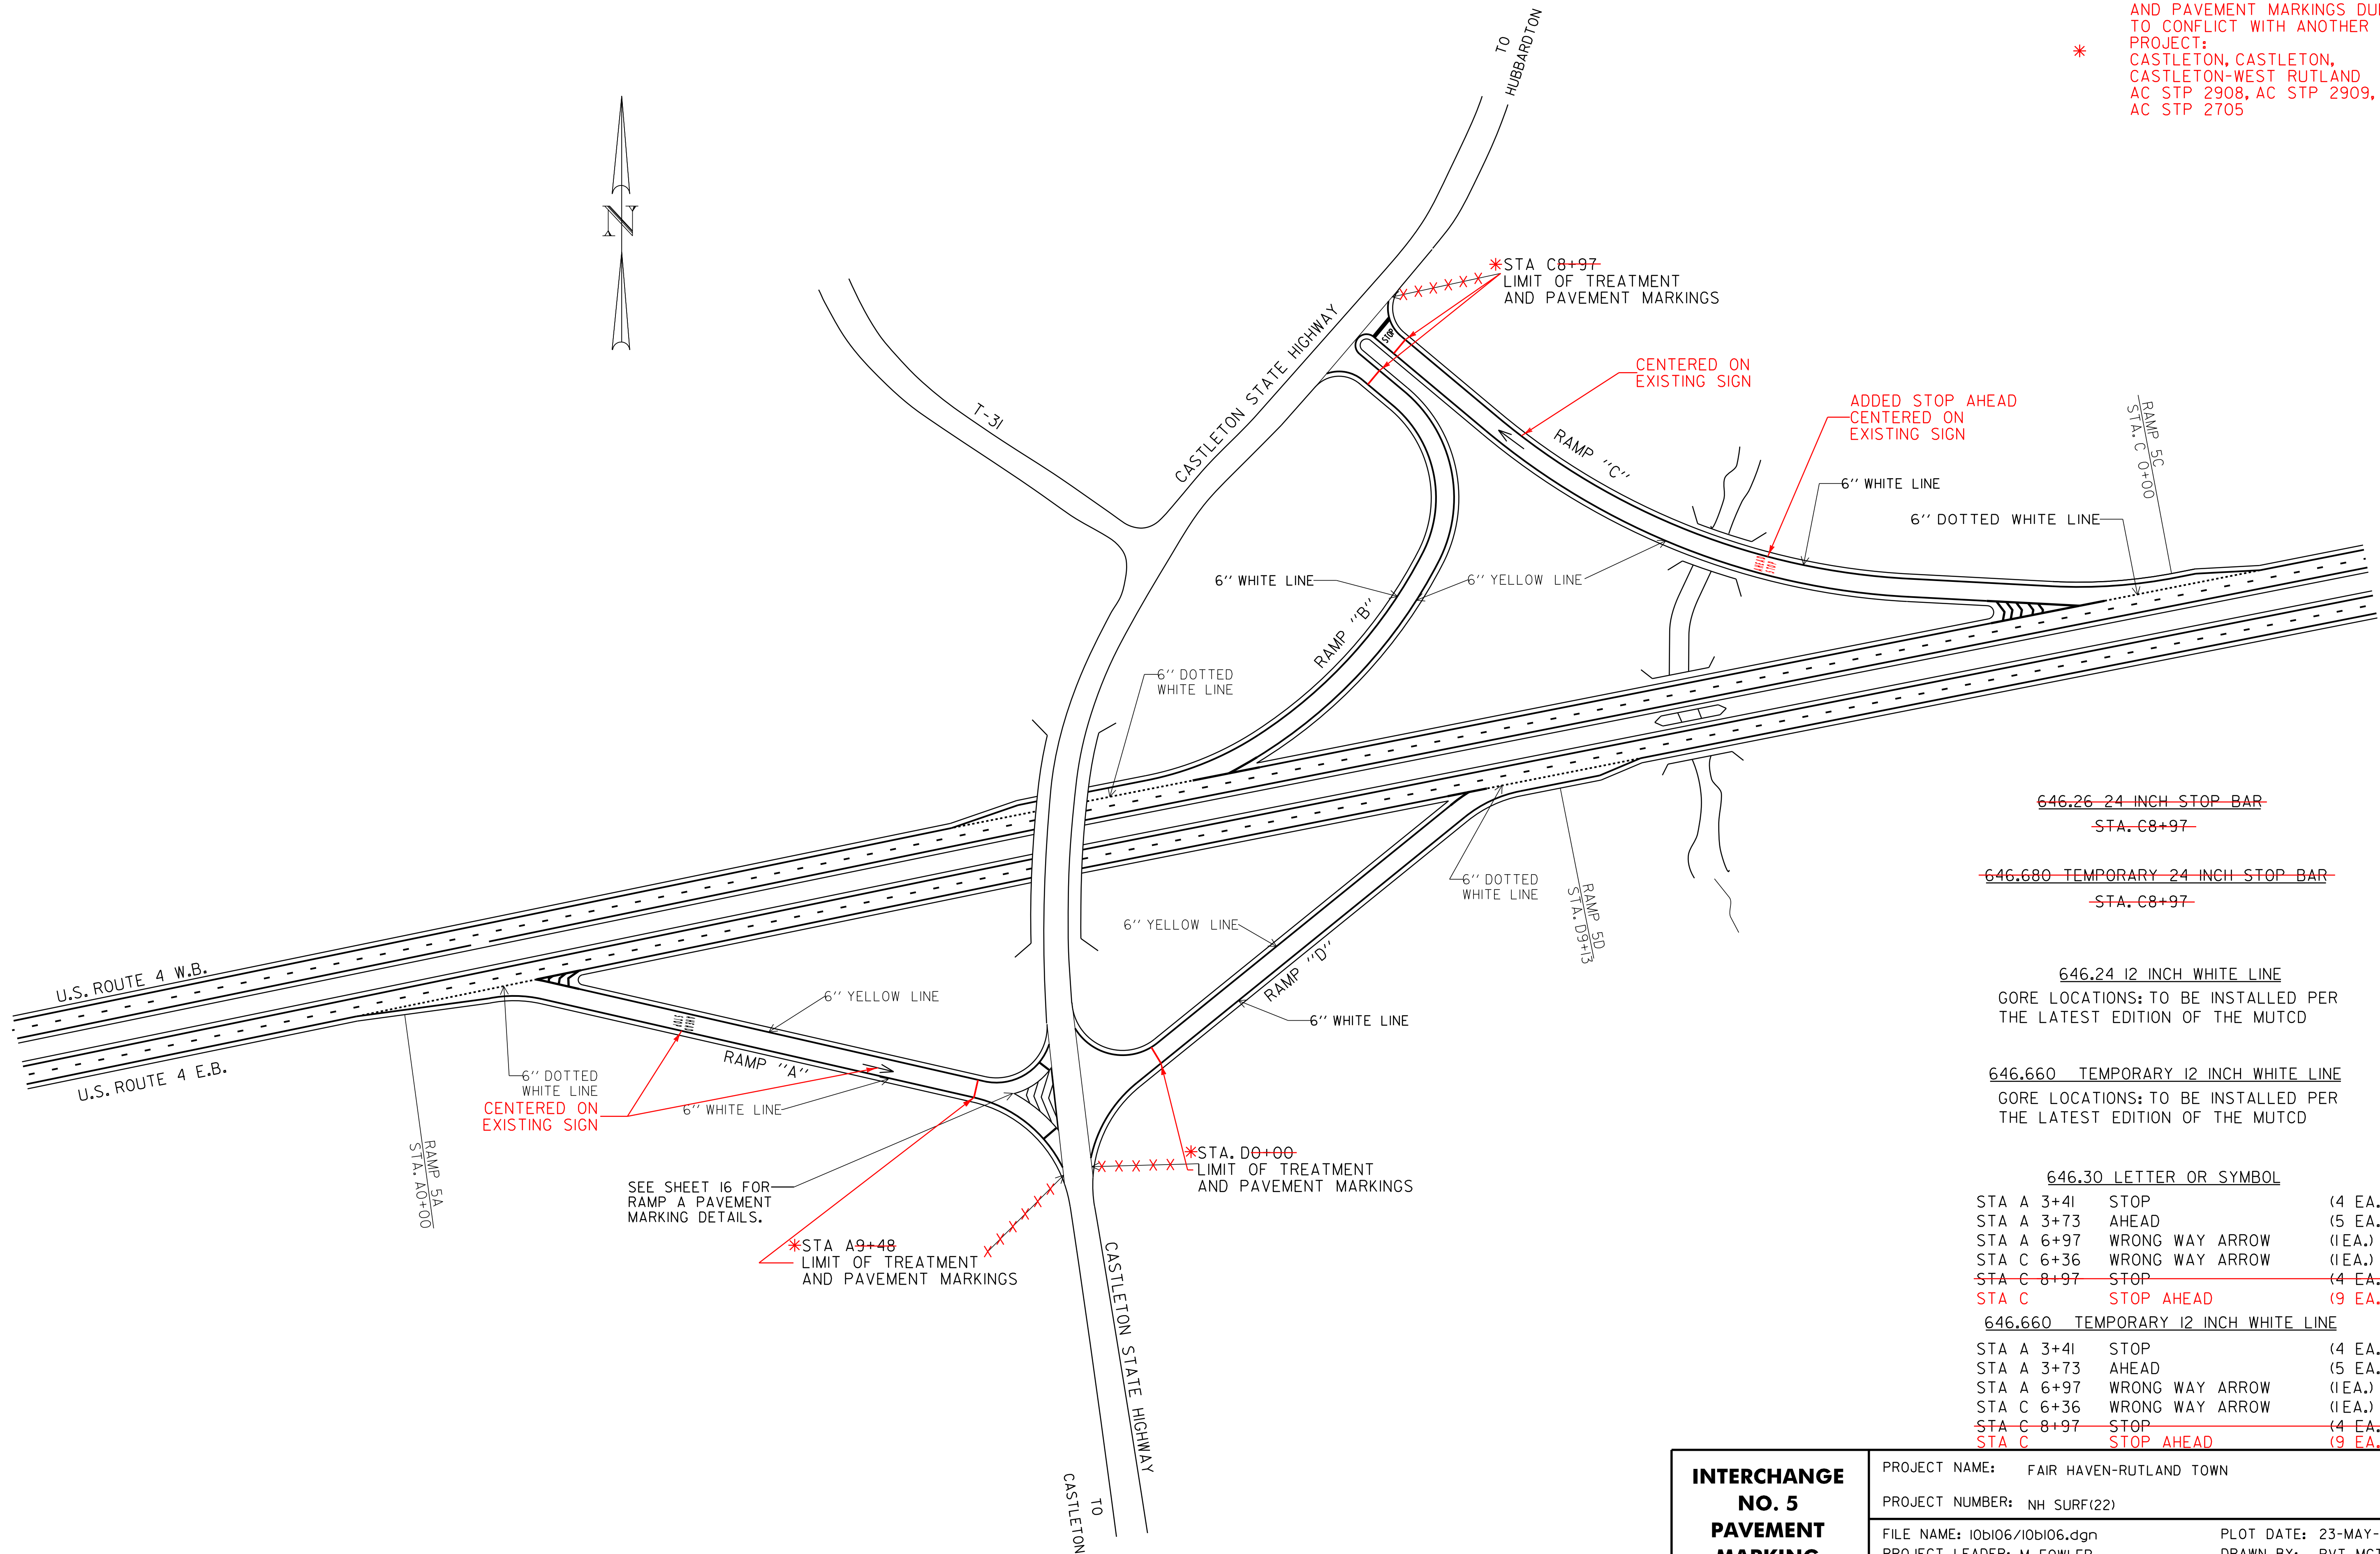

~~646.26 24 INCH STOP BAR
 STA. C8+97~~

~~646.680 TEMPORARY 24 INCH STOP BAR
 STA. C8+97~~

646.24 12 INCH WHITE LINE
 GORE LOCATIONS: TO BE INSTALLED PER THE LATEST EDITION OF THE MUTCD

646.660 TEMPORARY 12 INCH WHITE LINE
 GORE LOCATIONS: TO BE INSTALLED PER THE LATEST EDITION OF THE MUTCD

646.30 LETTER OR SYMBOL

STA A 3+41	STOP	(4 EA.)
STA A 3+73	AHEAD	(5 EA.)
STA A 6+97	WRONG WAY ARROW	(1EA.)
STA C 6+36	WRONG WAY ARROW	(1EA.)
STA C 8+97	STOP	(4 EA.)
STA C	STOP AHEAD	(9 EA.)

646.660 TEMPORARY 12 INCH WHITE LINE

STA A 3+41	STOP	(4 EA.)
STA A 3+73	AHEAD	(5 EA.)
STA A 6+97	WRONG WAY ARROW	(1EA.)
STA C 6+36	WRONG WAY ARROW	(1EA.)
STA C 8+97	STOP	(4 EA.)
STA C	STOP AHEAD	(9 EA.)

NOT TO SCALE

INTERCHANGE NO. 5 PAVEMENT MARKING DETAIL SHEET	PROJECT NAME: FAIR HAVEN-RUTLAND TOWN	PLOT DATE: 23-MAY-2013 11:41
	PROJECT NUMBER: NH SURF(22)	DRAWN BY: PVT. MGT.
	FILE NAME: I0bI06/I0bI06.dgn	CHECKED BY: PVT. MGT.
	PROJECT LEADER: M. FOWLER DESIGNED BY: PVT. MGT.	SHEET 14 OF 24

SEE SHEET 16 FOR RAMP A PAVEMENT MARKING DETAILS.