


US 4 Fair Haven-Rutland Town NH Surf (22) Westbound Ride

Profiled 7-12-11

Travel Lane Avg. IRI = 78.4, Passing Lane Avg. IRI = 84.6

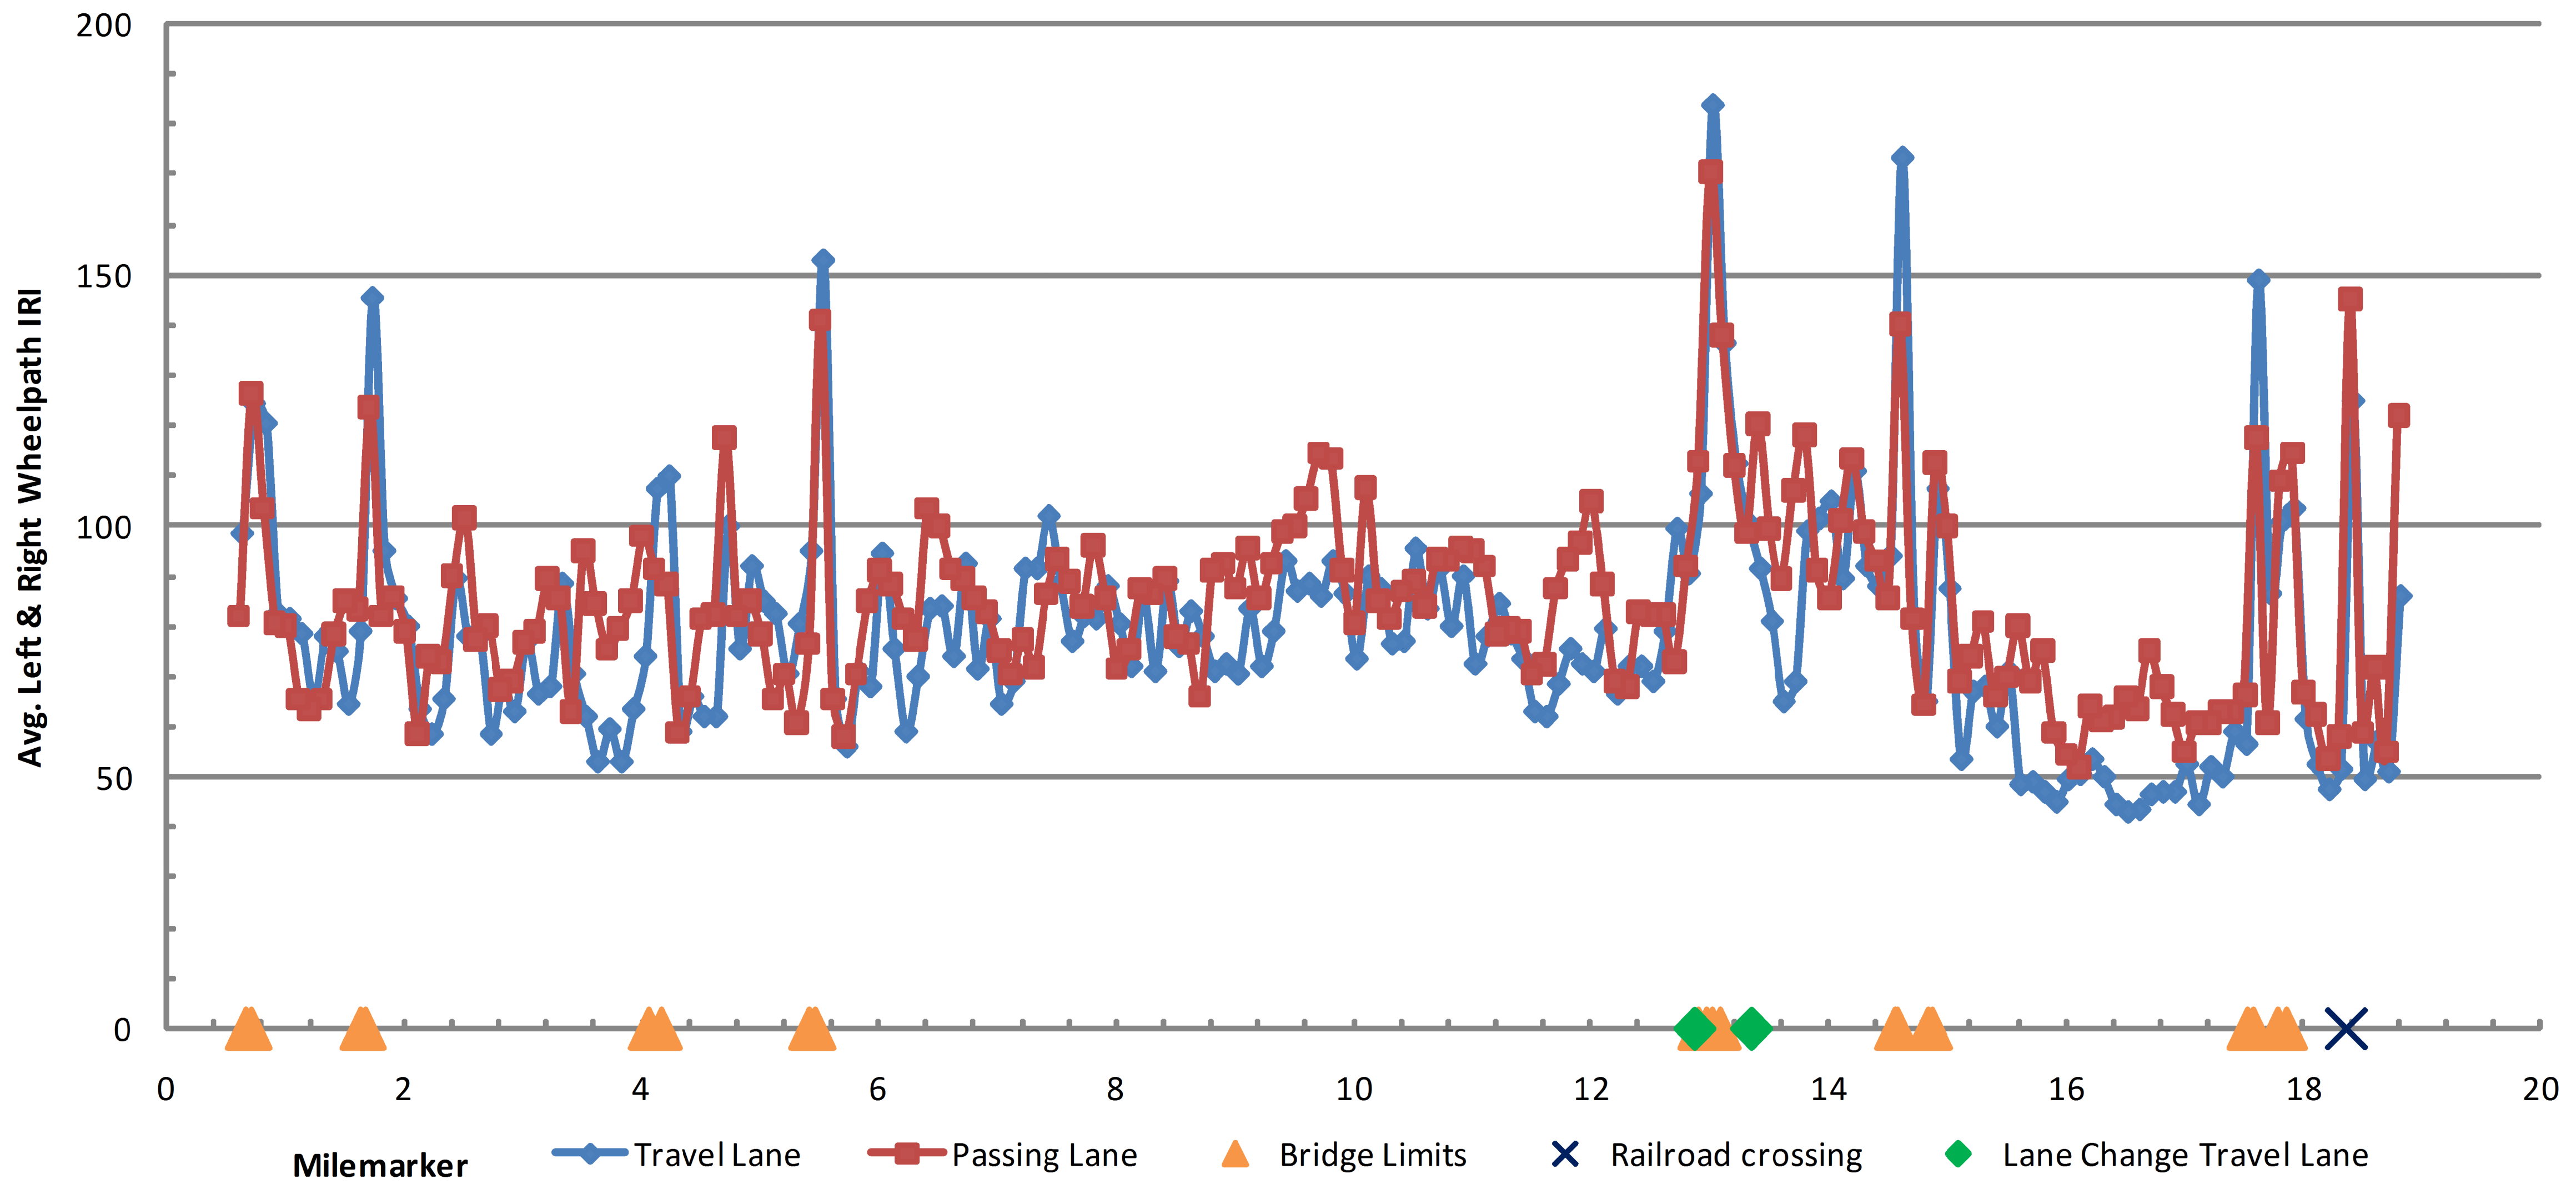

WESTBOUND ROUGHNESS DATA INFORMATION SHEET

PROJECT NAME: FAIR HAVEN-RUTLAND TOWN

PROJECT NUMBER: NH SURF(22)

FILE NAME: IOBIO6/IOBIO6.DGN

PROJECT LEADER: M. FOWLER

DESIGNED BY: PVT. MGT.

IOBIO6*18.1

PLOT DATE: 23-MAY-2013 11:41

DRAWN BY: PVT. MGT.

CHECKED BY: PVT. MGT.

SHEET 18 OF 24