


# US 4 Fair Haven-Rutland Town NH Surf (22) Eastbound Ride

Profiled 7-12-11

Travel Lane Avg. IRI = 75.4, Passing Lane Avg. IRI = 81.9

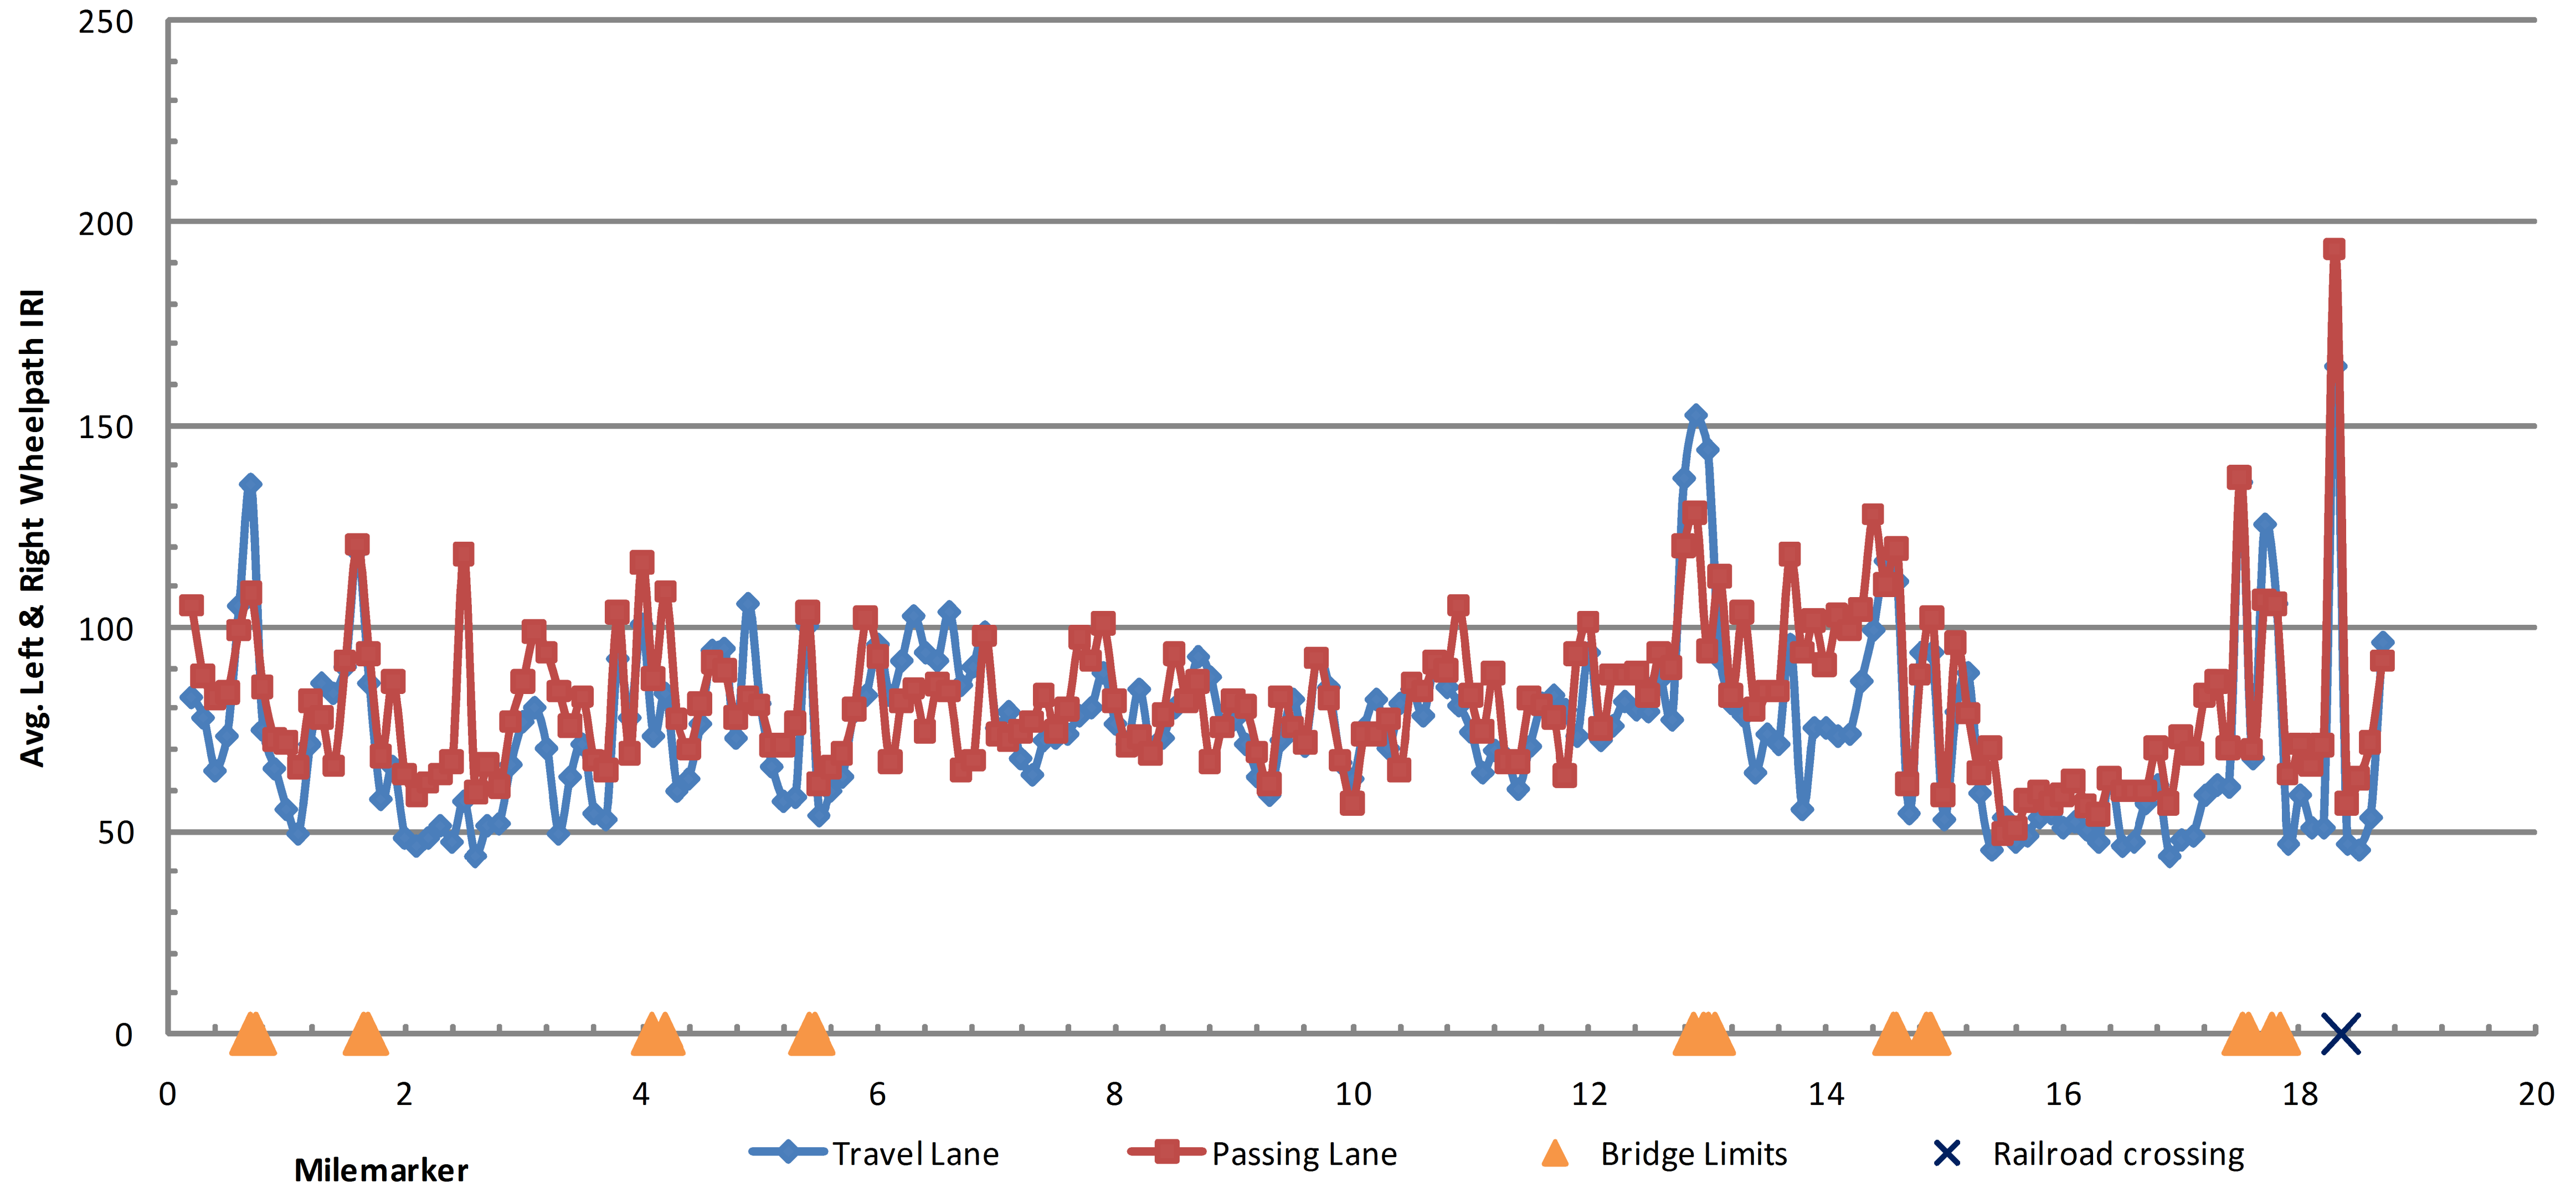

**EASTBOUND  
ROUGHNESS  
DATA  
INFORMATION  
SHEET**

PROJECT NAME: FAIR HAVEN-RUTLAND TOWN

PROJECT NUMBER: NH SURF(22)

FILE NAME: IOBIO6/IOBIO6.DGN  
PROJECT LEADER: M. FOWLER  
DESIGNED BY: PVT. MGT.  
IOBIO6#20.I

PLOT DATE: 23-MAY-2013 11:41  
DRAWN BY: PVT. MGT.  
CHECKED BY: PVT. MGT.  
SHEET 20 OF 24