




**INTERCHANGE NO. 1**

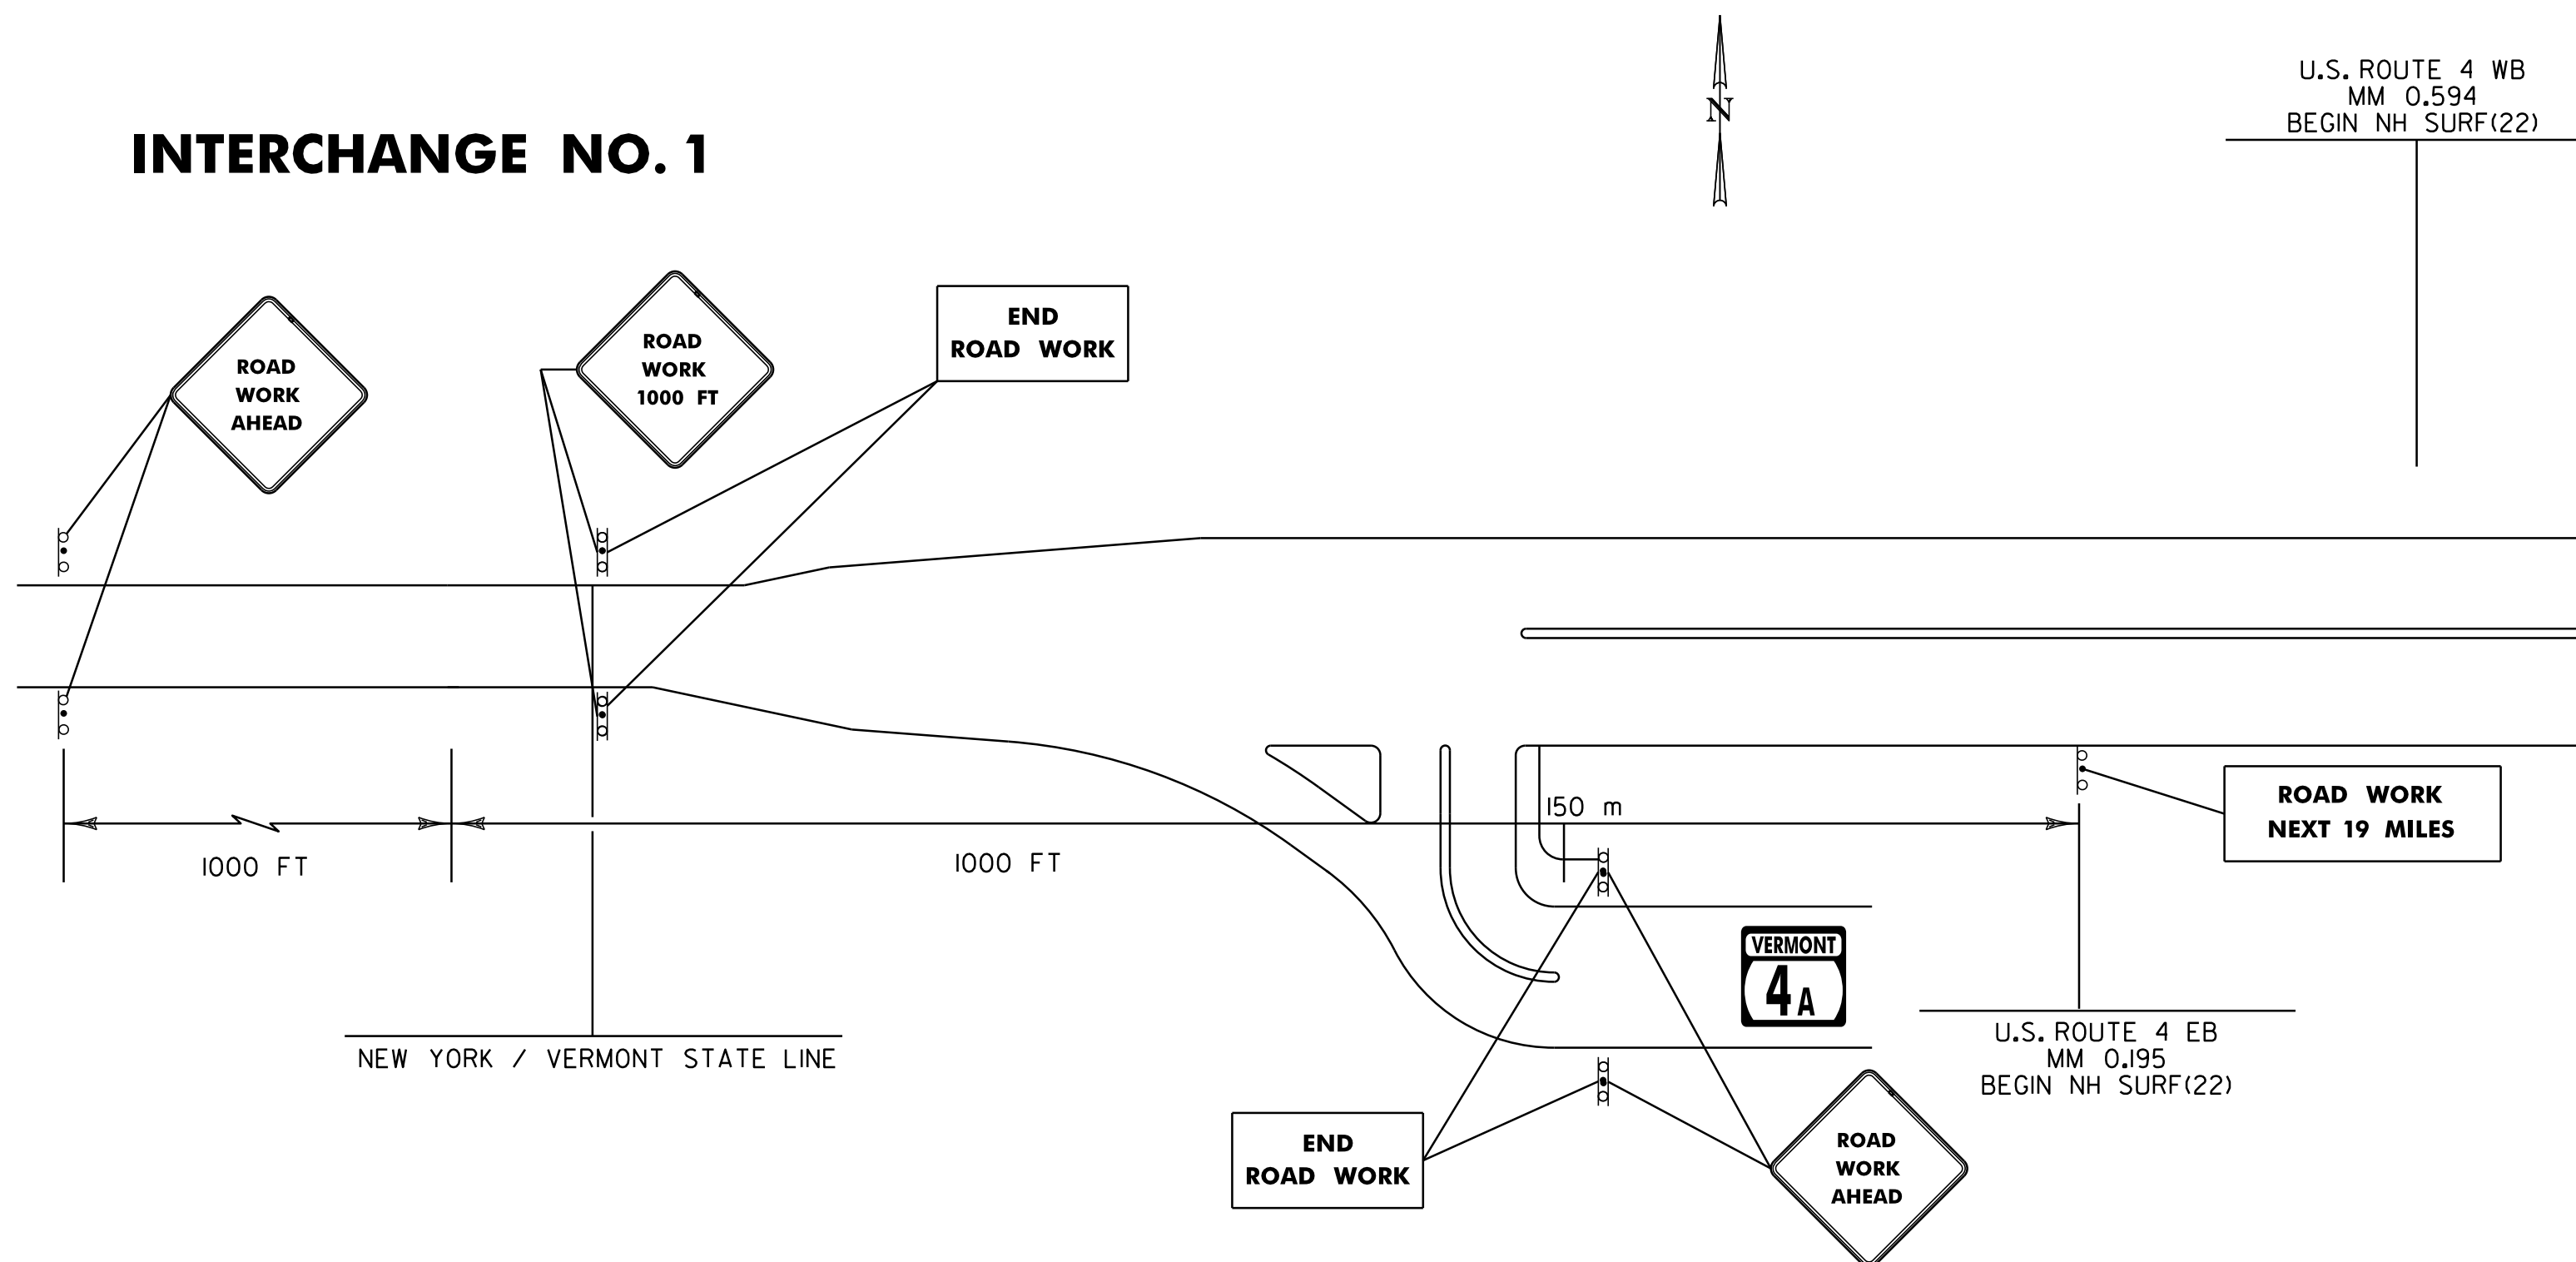


**INTERCHANGE NO. 2**

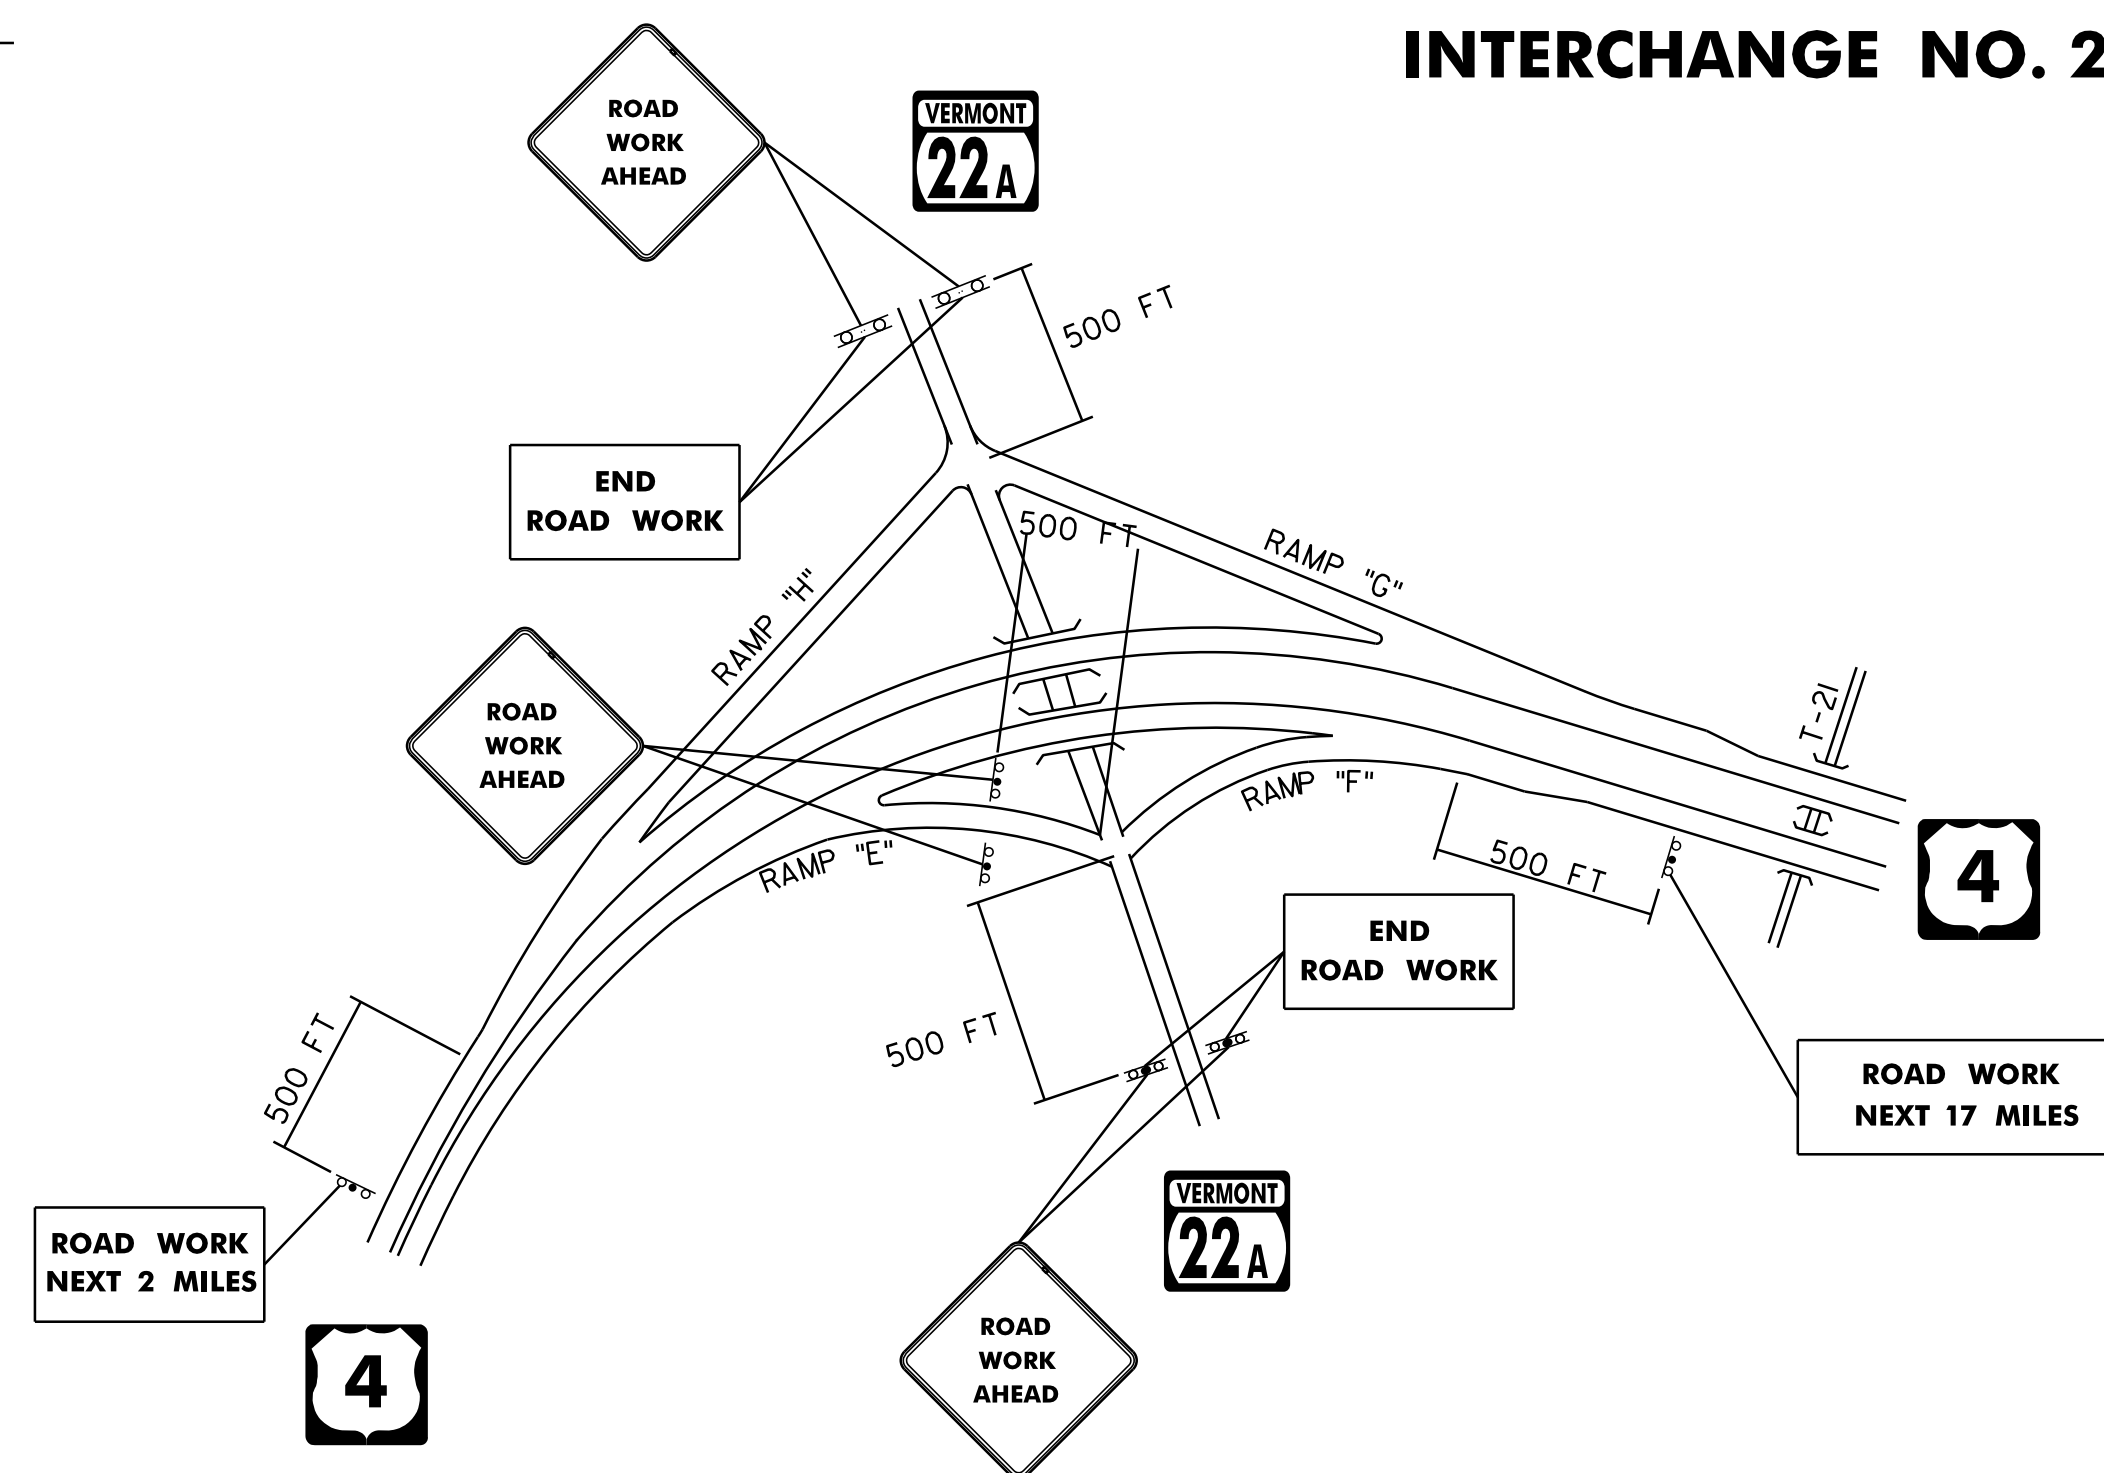

**INTERCHANGE NO. 3**

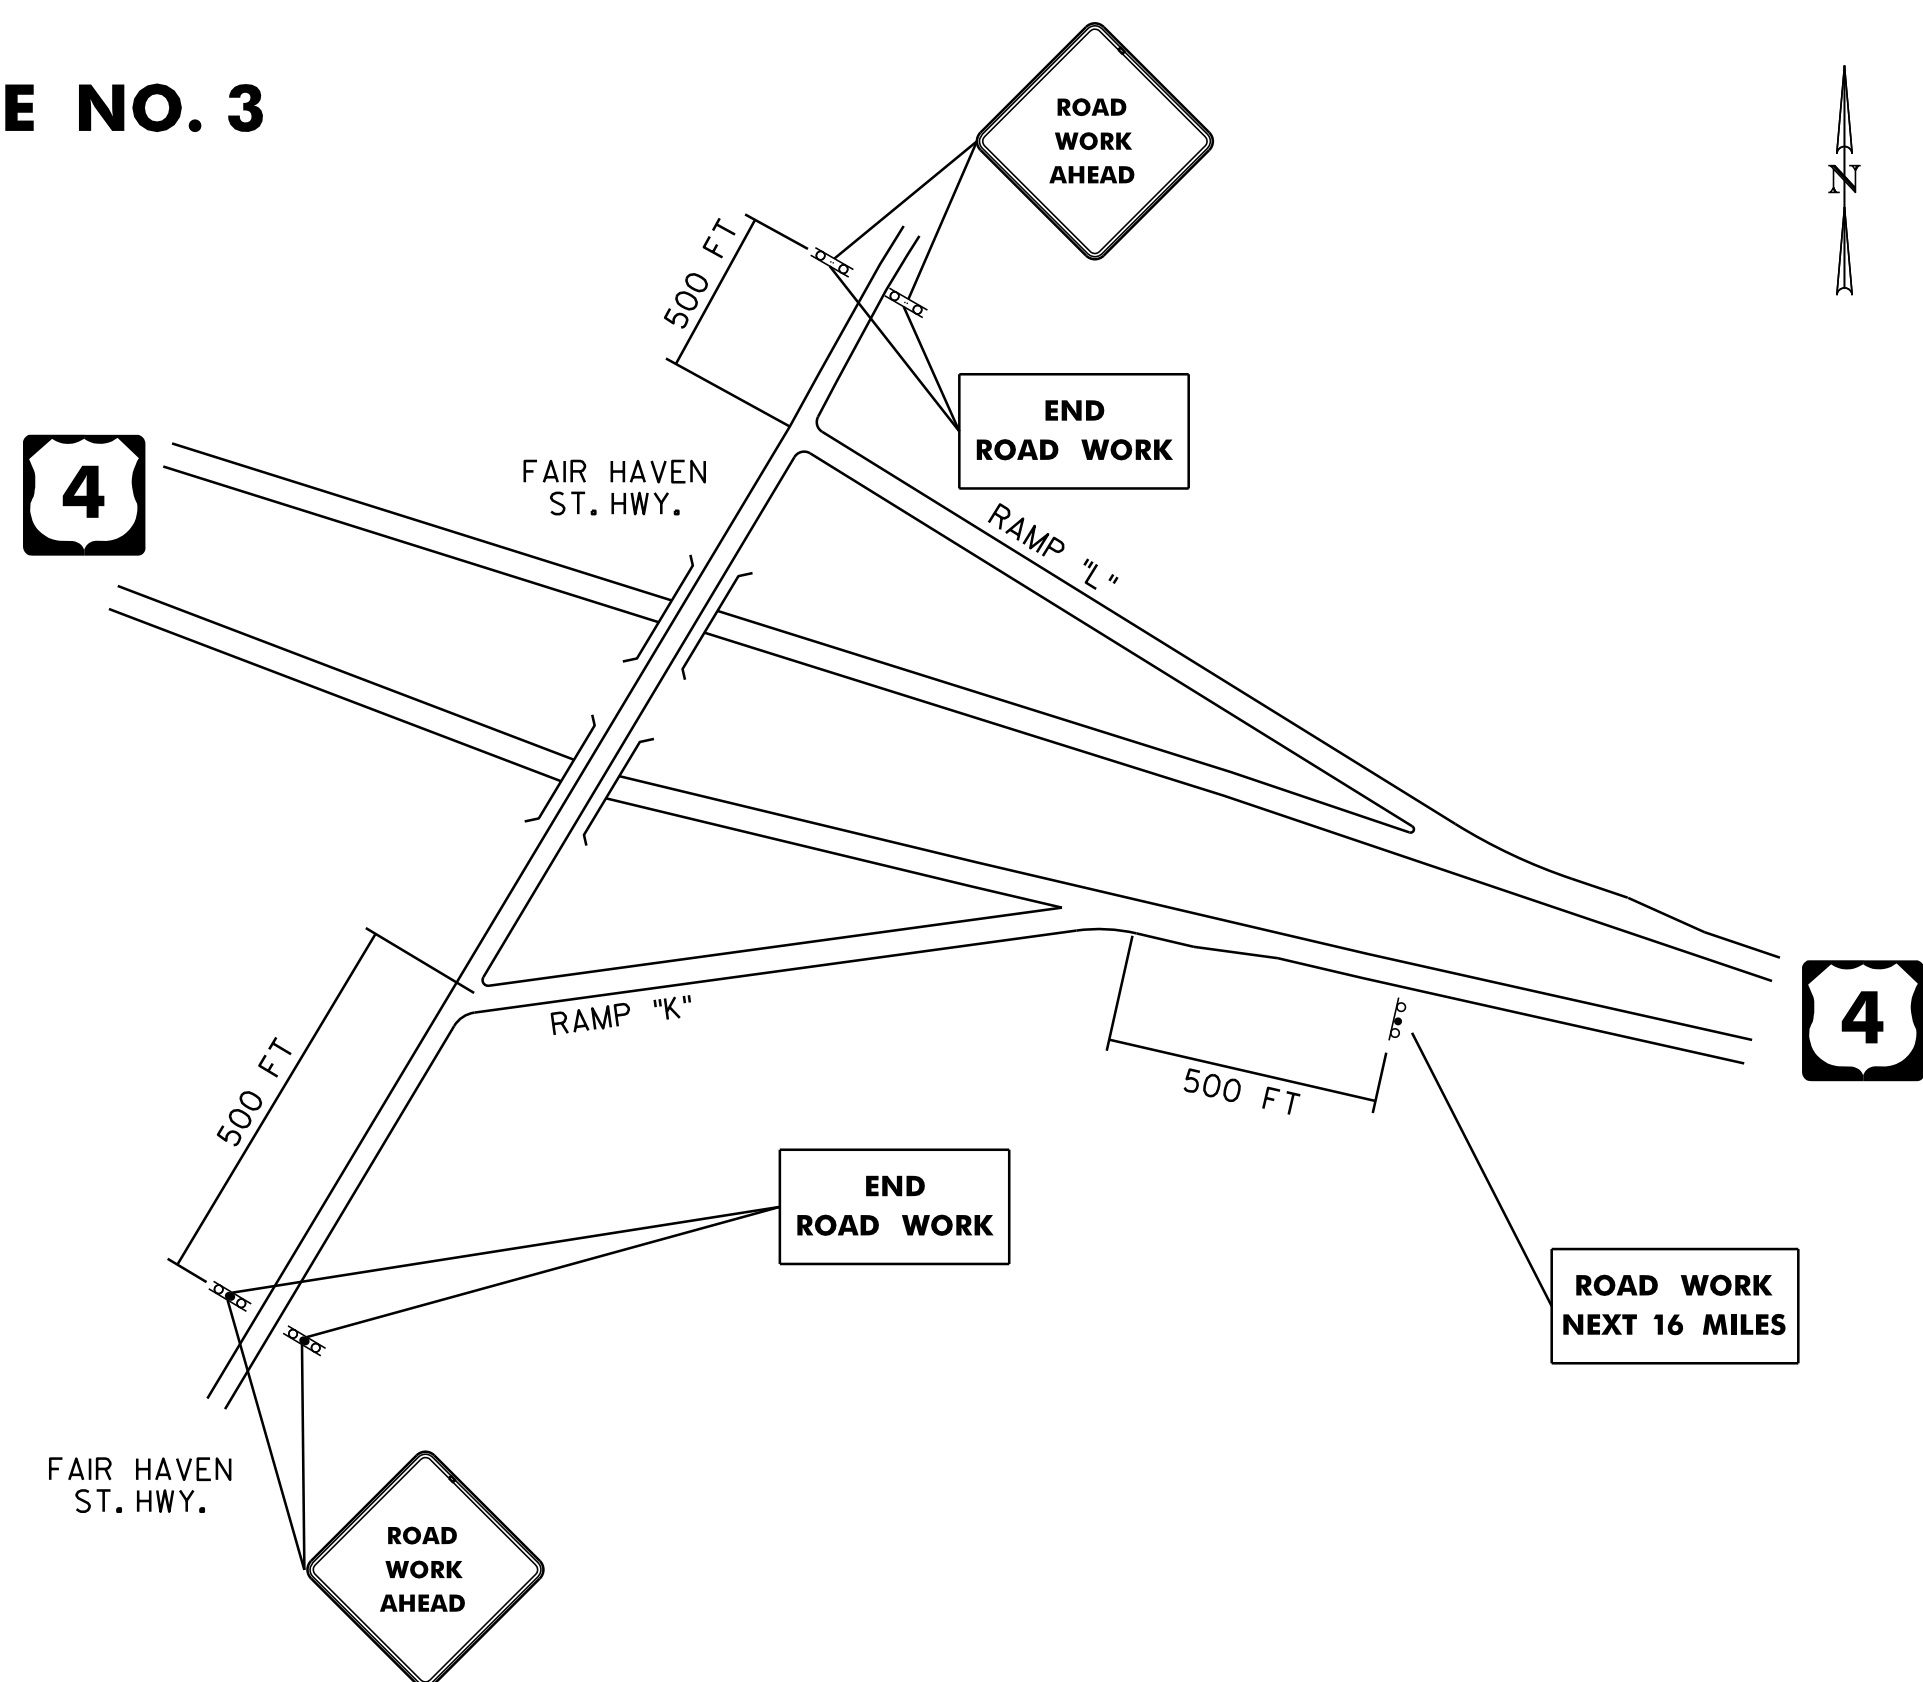

**INTERCHANGE NO. 4**

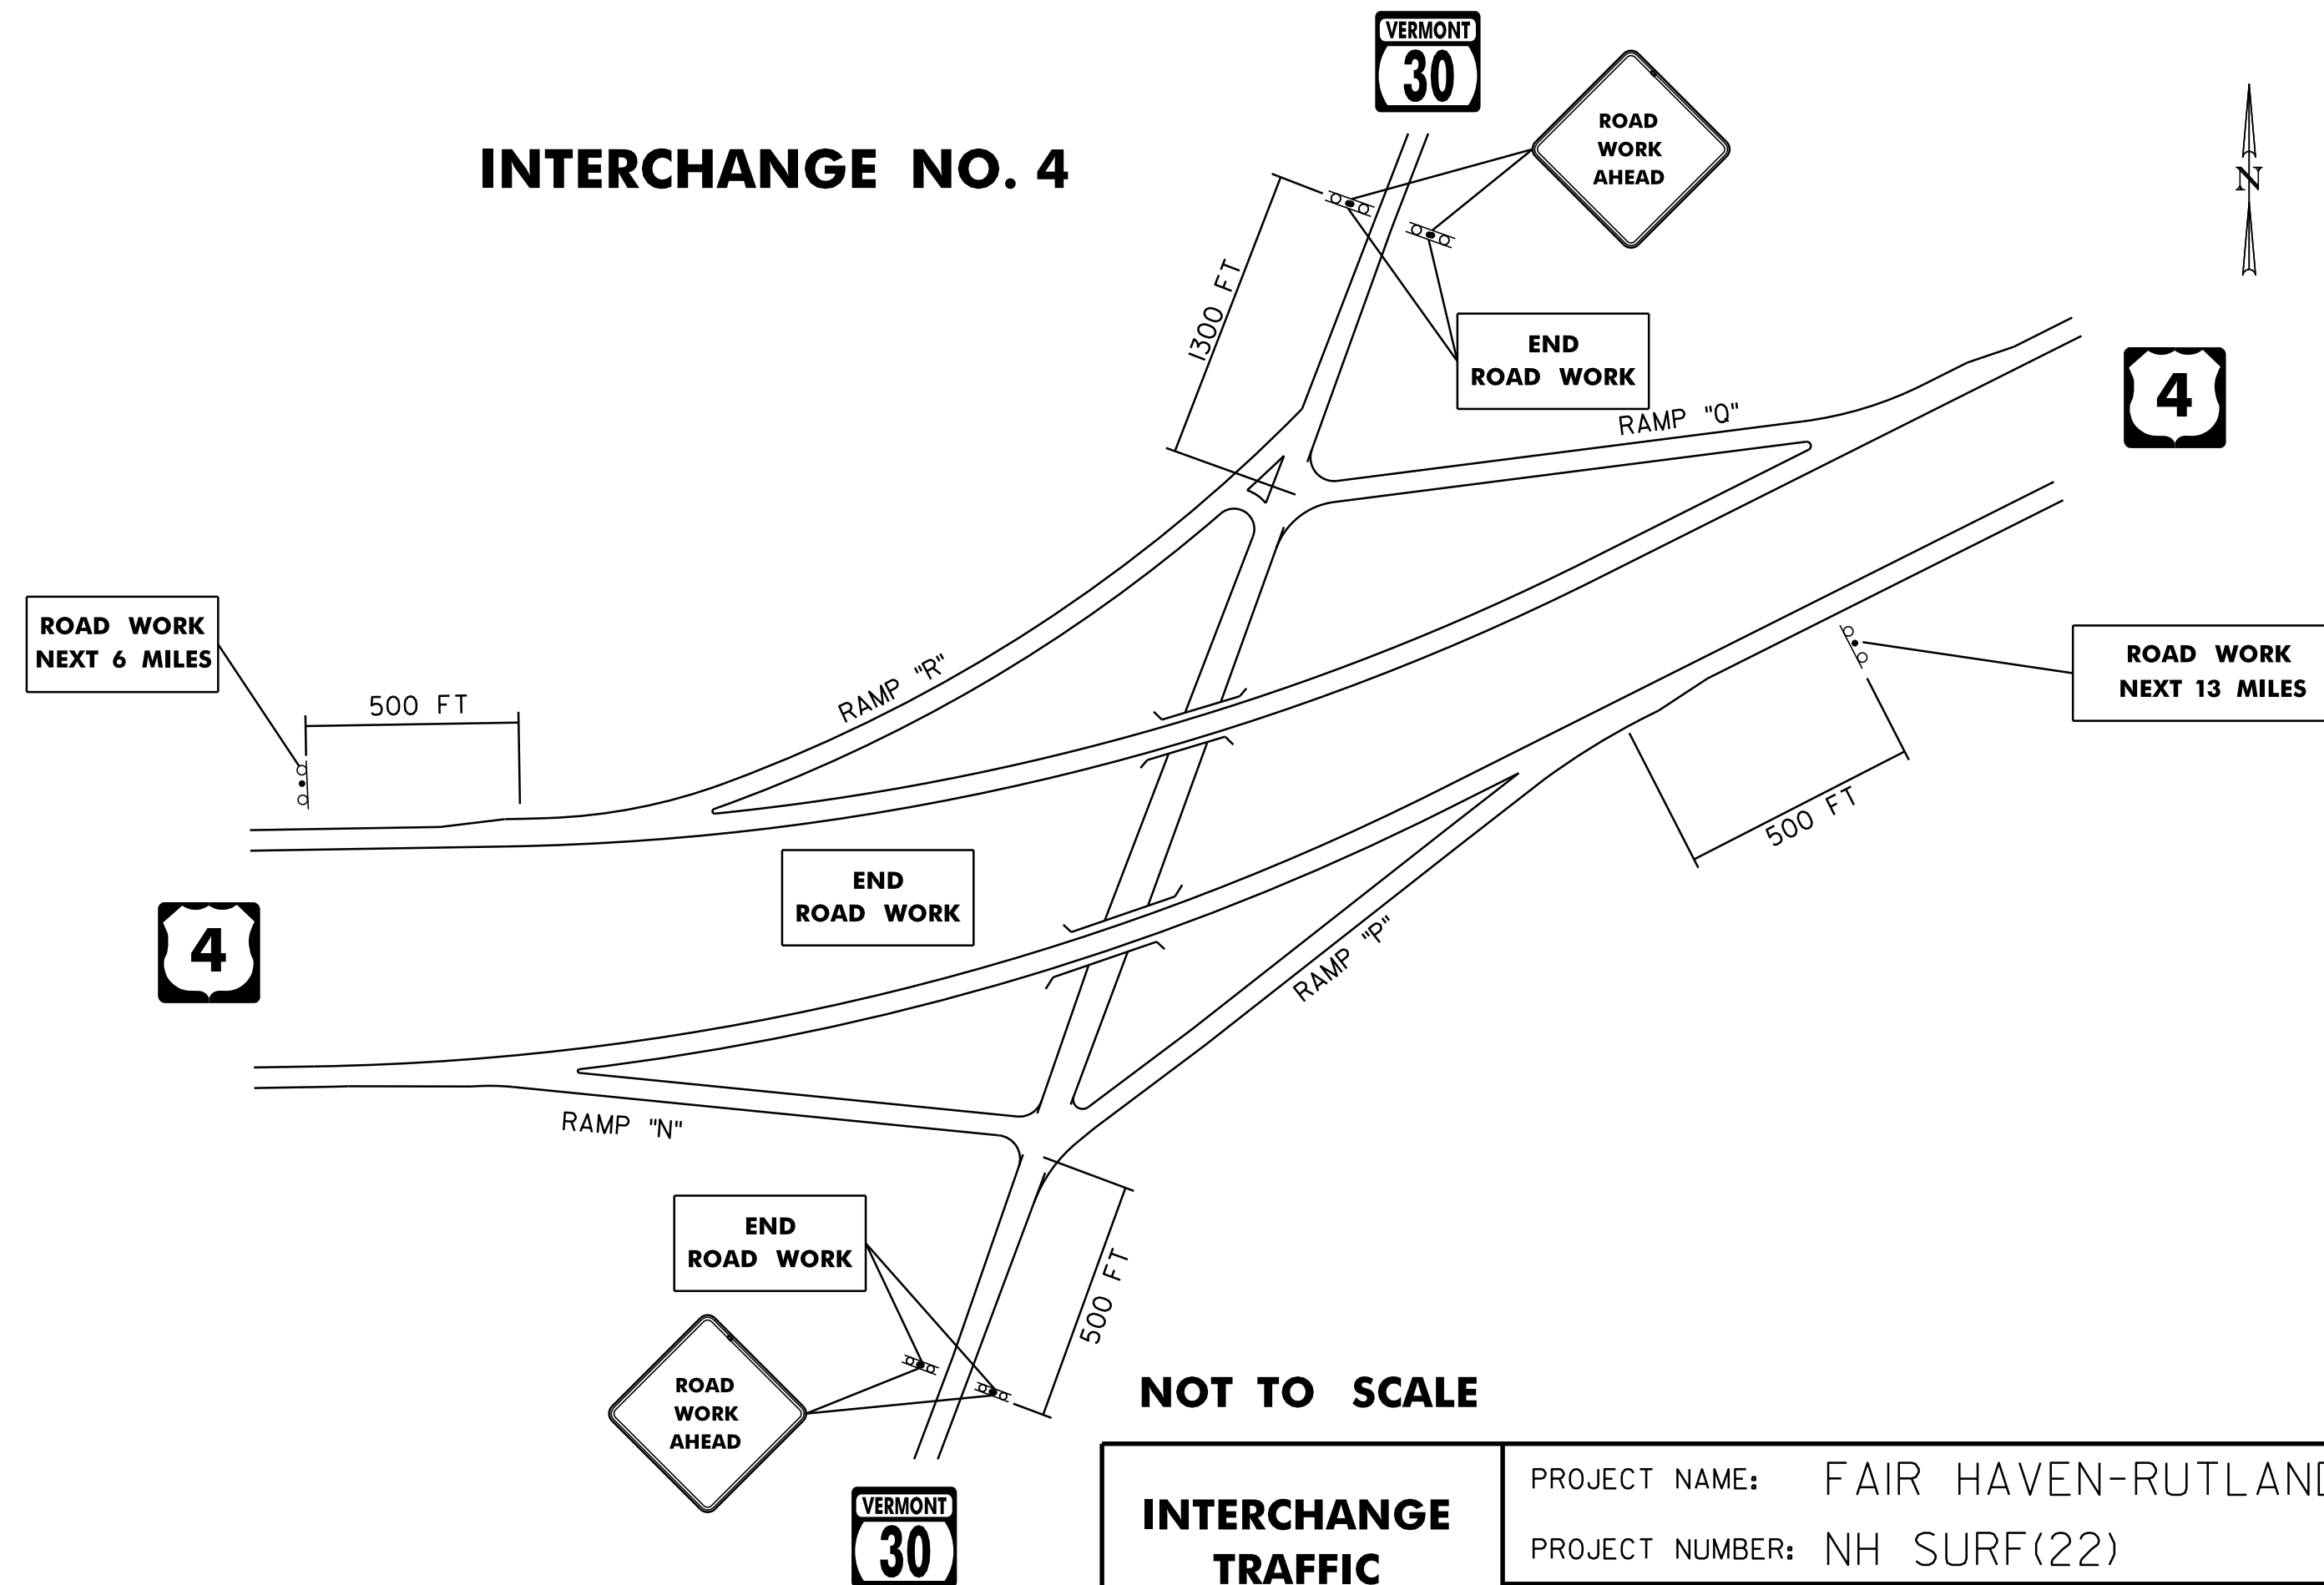

NOTE:  
SEE STANDARD E-100 FOR ADDITIONAL SIGN PLACEMENT DETAILS

NOT TO SCALE

**INTERCHANGE TRAFFIC CONTROL SHEET 1**

PROJECT NAME:	FAIR HAVEN-RUTLAND TOWN	PLOT DATE:	23-MAY-2013 11:42
PROJECT NUMBER:	NH SURF(22)	DRAWN BY:	PVT. MGT.
FILE NAME:	10B106/10B106.DGN	CHECKED BY:	PVT. MGT.
PROJECT LEADER:	M. FOWLER	SHEET	22 OF 24
DESIGNED BY:	PVT. MGT.		
10B106#22.1			