

646.26 24 INCH STOP BAR
STA. LI2+24


646.680 TEMPORARY 24 INCH STOP BAR
STA. LI2+24

646.24 12 INCH WHITE LINE
GORE LOCATIONS: TO BE INSTALLED PER
THE LATEST EDITION OF THE MUTCD

646.660 TEMPORARY 12 INCH WHITE LINE
GORE LOCATIONS: TO BE INSTALLED PER
THE LATEST EDITION OF THE MUTCD

646.30 LETTER OR SYMBOL
STA LI0+40 WRONG WAY ARROW (1 EA.)
STA LI2+15 STOP (4 EA.)
STA L STOP AHEAD (9 EA.)

646.690 TEMPORARY LETTER OR SYMBOL
STA LI0+40 WRONG WAY ARROW (1 EA.)
STA LI2+15 STOP (4 EA.)
STA L STOP AHEAD (9 EA.)

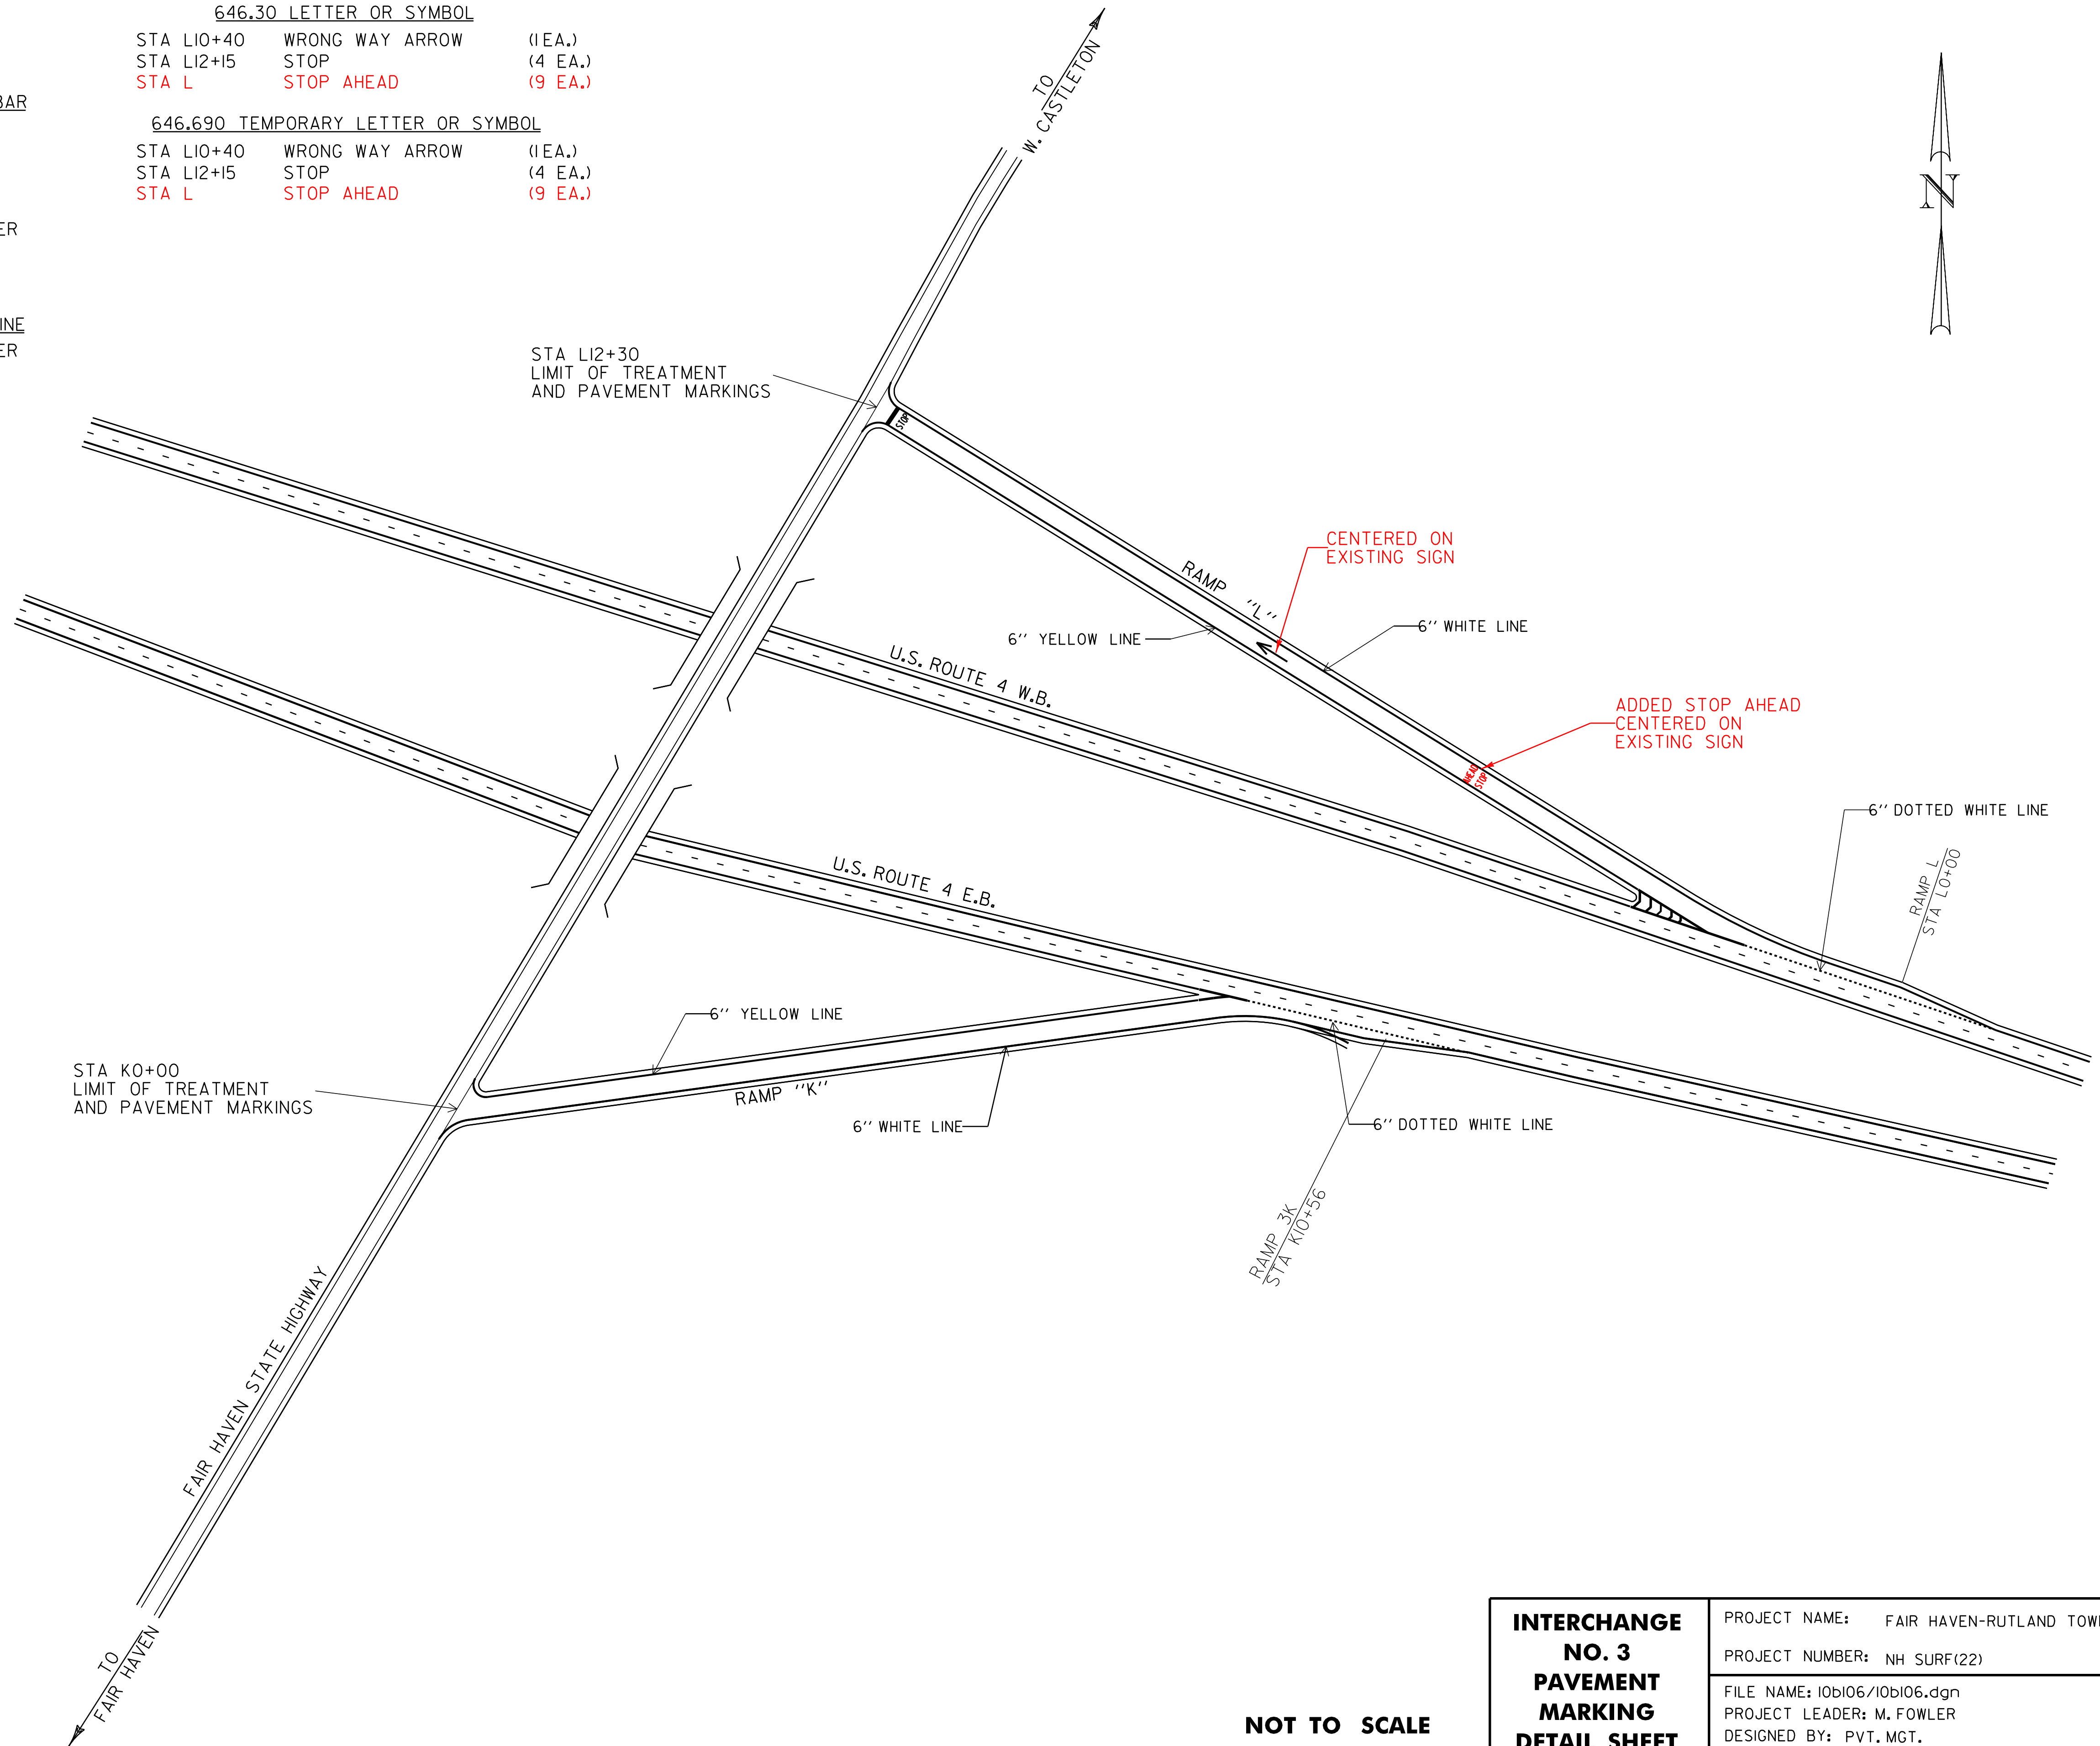

NOT TO SCALE

**INTERCHANGE
NO. 3
PAVEMENT
MARKING
DETAIL SHEET**

PROJECT NAME: FAIR HAVEN-RUTLAND TOWN
PROJECT NUMBER: NH SURF(22)
FILE NAME: IOBI06/IOBI06.dgn
PROJECT LEADER: M. FOWLER
DESIGNED BY: PVT. MGT.
IOBI06*12.1

PLOT DATE: 31-MAY-2013 11:55
DRAWN BY: PVT. MGT.
CHECKED BY: PVT. MGT.
SHEET 12 OF 24