
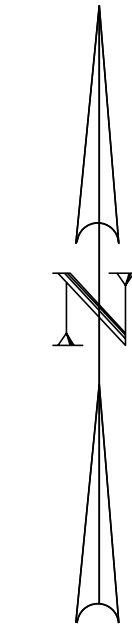


* CHANGED LIMIT OF TREATMENT AND PAVEMENT MARKINGS DUE TO CONFLICT WITH ANOTHER PROJECT:
 CASTLETON, CASTLETON, CASTLETON-WEST RUTLAND AC STP 2908, AC STP 2909, AC STP 2705

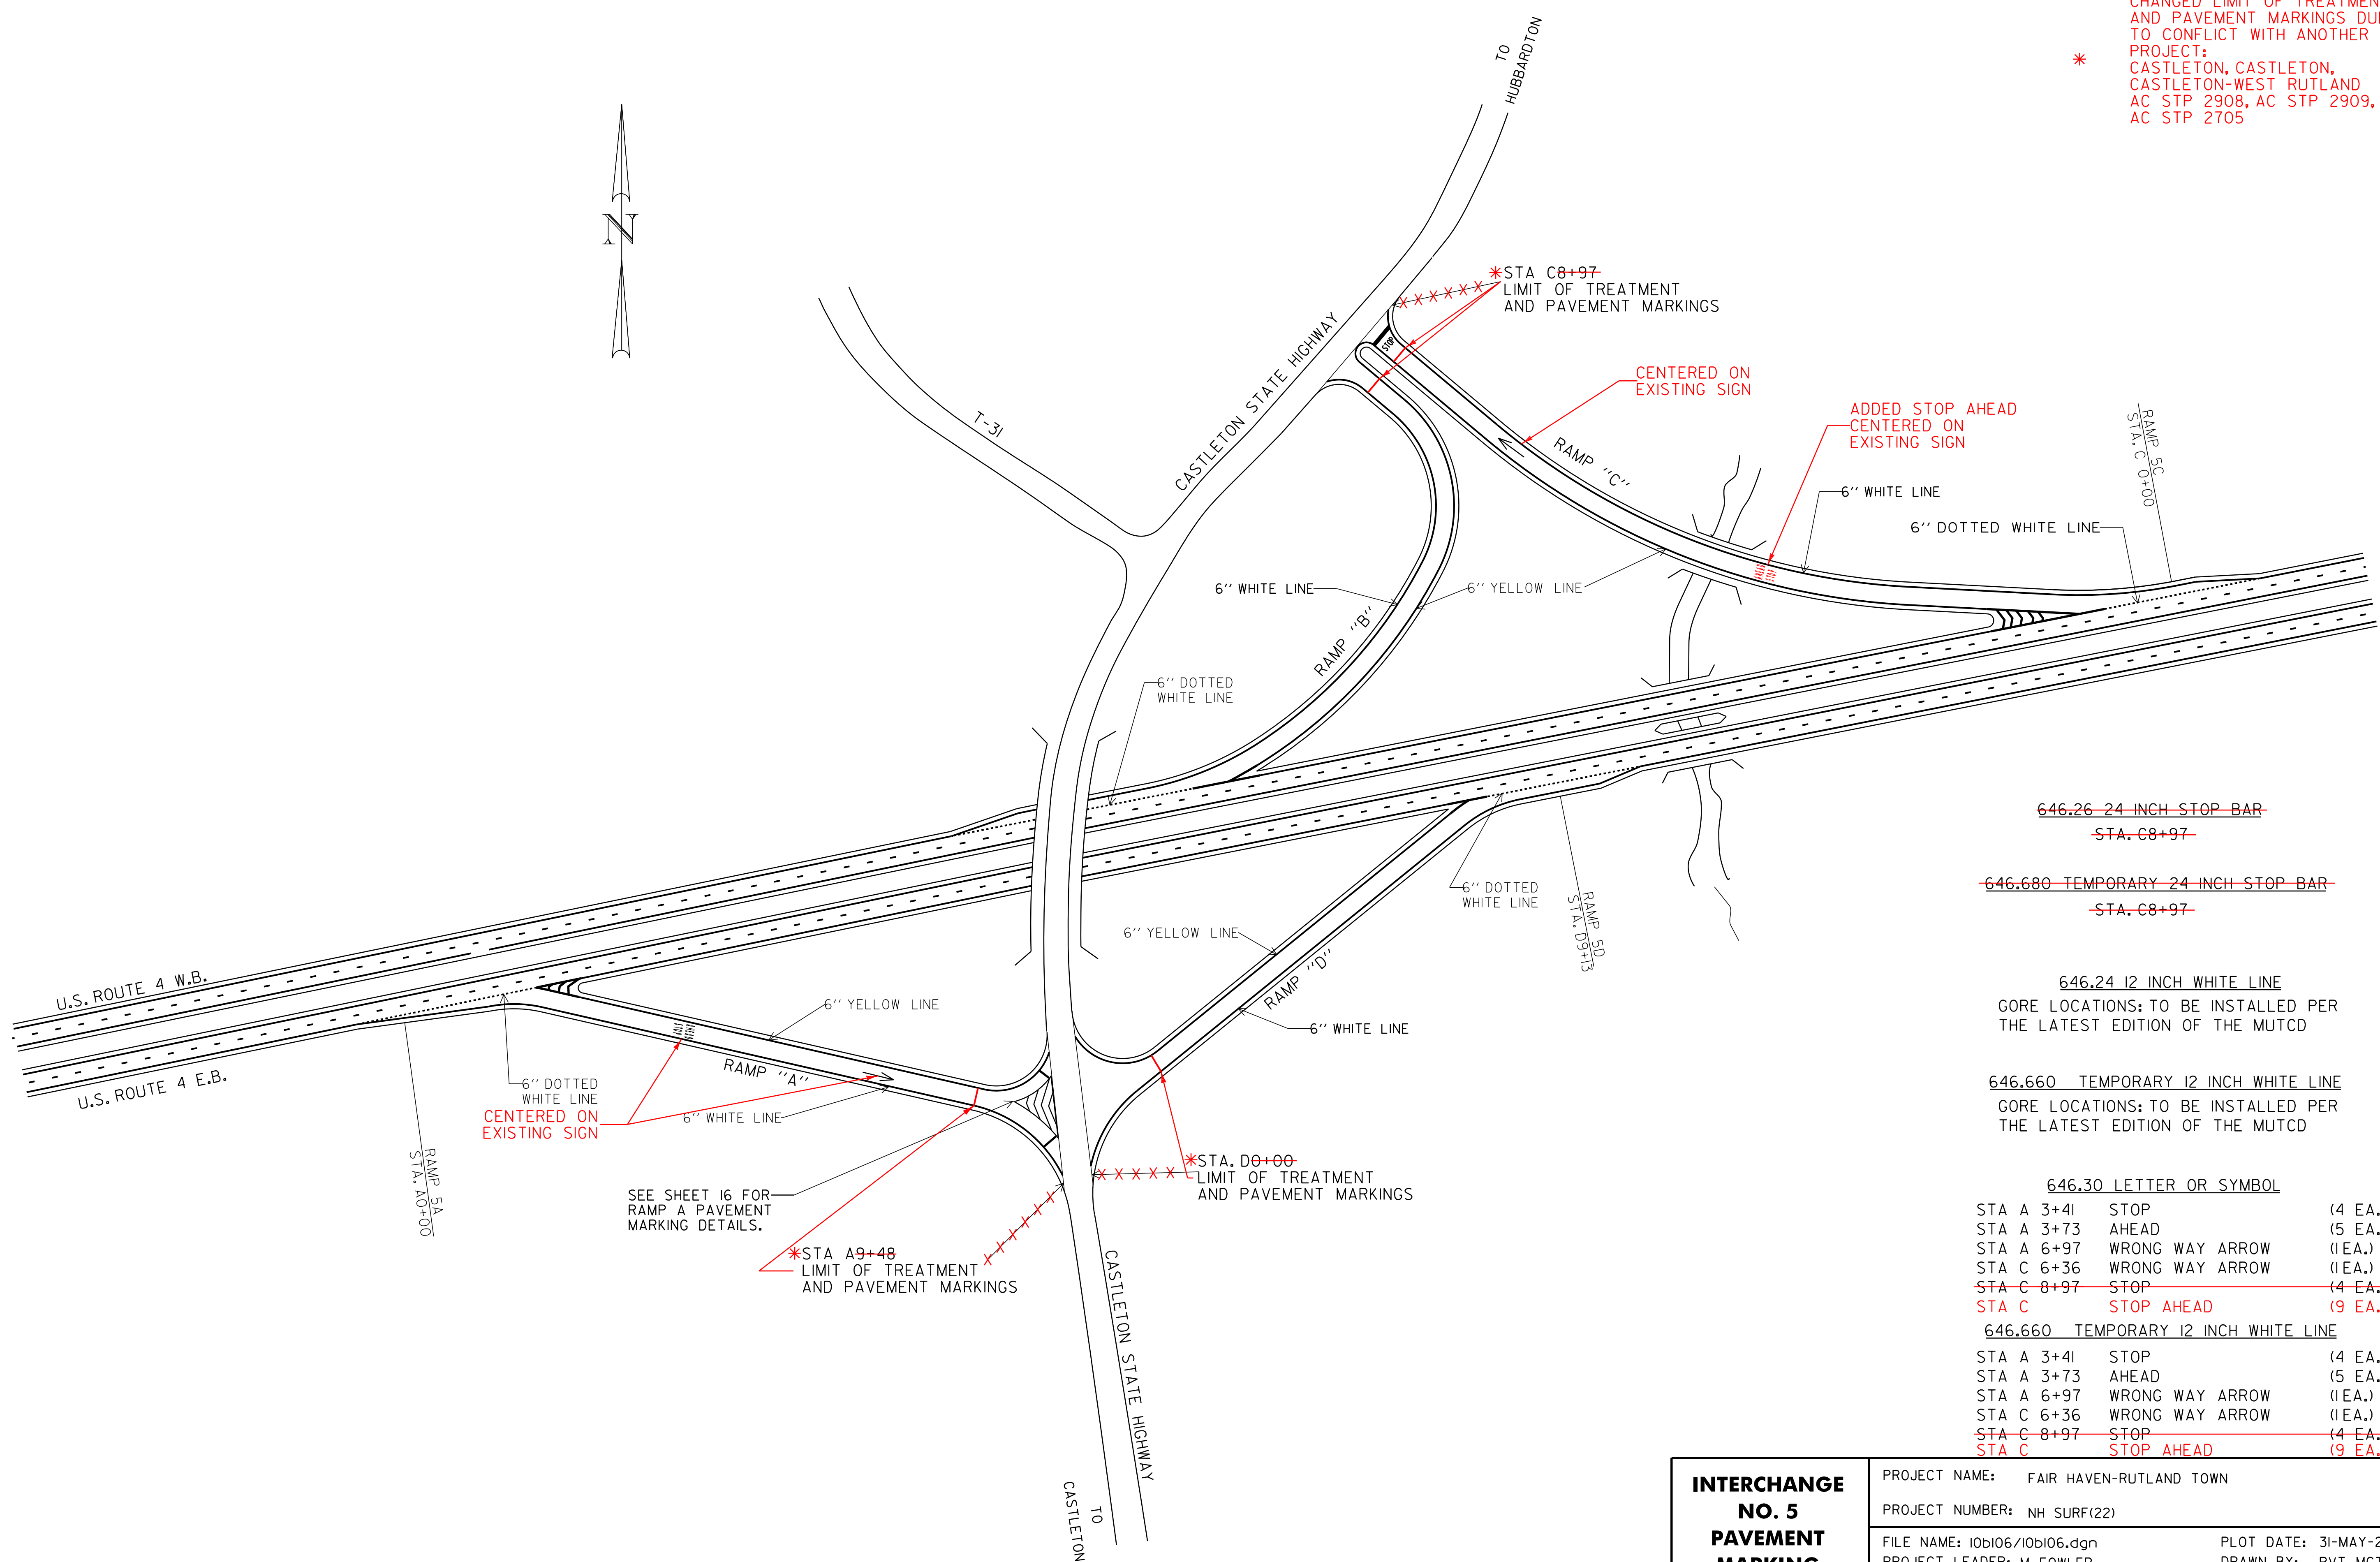

- ~~646.26 24 INCH STOP BAR~~
~~STA. C8+97~~
- ~~646.680 TEMPORARY 24 INCH STOP BAR~~
~~STA. C8+97~~
- 646.24 12 INCH WHITE LINE
GORE LOCATIONS: TO BE INSTALLED PER THE LATEST EDITION OF THE MUTCD
- ~~646.660 TEMPORARY 12 INCH WHITE LINE~~
~~GORE LOCATIONS: TO BE INSTALLED PER THE LATEST EDITION OF THE MUTCD~~
- 646.30 LETTER OR SYMBOL
- STA A 3+41 STOP (4 EA.)
- STA A 3+73 AHEAD (5 EA.)
- STA A 6+97 WRONG WAY ARROW (1EA.)
- STA C 6+36 WRONG WAY ARROW (1EA.)
- ~~STA C 8+97 STOP (4 EA.)~~
- STA C STOP AHEAD (9 EA.)
- 646.660 TEMPORARY 12 INCH WHITE LINE
- STA A 3+41 STOP (4 EA.)
- STA A 3+73 AHEAD (5 EA.)
- STA A 6+97 WRONG WAY ARROW (1EA.)
- STA C 6+36 WRONG WAY ARROW (1EA.)
- ~~STA C 8+97 STOP (4 EA.)~~
- STA C STOP AHEAD (9 EA.)

NOT TO SCALE

INTERCHANGE NO. 5 PAVEMENT MARKING DETAIL SHEET	PROJECT NAME: FAIR HAVEN-RUTLAND TOWN	PLOT DATE: 31-MAY-2013 11:55
	PROJECT NUMBER: NH SURF(22)	DRAWN BY: PVT. MGT.
	FILE NAME: I0BI06/I0BI06.dgn	CHECKED BY: PVT. MGT.
	PROJECT LEADER: M. FOWLER DESIGNED BY: PVT. MGT.	SHEET 14 OF 24

I0AI06*14.1