


646.20 4 INCH WHITE LINE
 646.602 TEMPORARY 4 INCH WHITE LINE, PAINT
 MM 1.745 - MM 4.500 LT & RT
 (WITH BREAKS OR RADII AT TOWN HIGHWAYS)

646.21 4 INCH YELLOW LINE
 646.612 TEMPORARY 4 INCH YELLOW LINE, PAINT
 MM 1.745 - MM 2.280 SOLID LT & RT
 MM 2.280 - MM 2.387 SOLID LT, DASHED RT
 MM 2.387 - MM 2.854 DASHED RT
 MM 2.854 - MM 3.022 DASHED LT, SOLID RT
 MM 3.022 - MM 3.036 SOLID LT & RT
 MM 3.036 - MM 3.193 SOLID LT, DASHED RT
 MM 3.193 - MM 3.571 DASHED RT
 MM 3.571 - MM 3.665 DASHED LT, SOLID RT
 MM 3.665 - MM 3.786 SOLID LT & RT
 MM 3.786 - MM 3.930 SOLID LT, DASHED RT
 MM 3.930 - MM 3.940 DASHED RT
 MM 3.940 - MM 4.078 DASHED LT, SOLID RT
 MM 4.078 - MM 4.480 SOLID LT & RT
 MM 4.480 - MM 4.500 SOLID LT, DASHED RT
 (WITH CENTERLINE BREAKS AT TOWN HIGHWAYS)

TEST SECTION

- (A) 9.5 MM SBS POLYMER-MODIFIED BIT CONC. PAVEMENT
- (B) 9.5 MM SBS POLYMER-MODIFIED BIT CONC. PAVEMENT 25% RAP
- (C) BIT CONC. PAVEMENT, SMALL QTY

NOTES:
 1. THIS SHEET TO BE USED FOR THE LAYOUT OF ALL CENTERLINE PAVEMENT MARKINGS. THE RESIDENT ENGINEER MAY CONTACT KEITH SWEET, PAVEMENT MARKING SUPERVISOR AT (802) 828-5573 FOR ASSISTANCE LAYING OUT THE CENTERLINE DURING CONSTRUCTION.
 2. TWO (2) APPLICATIONS OF FINAL PAVEMENT MARKINGS WILL BE REQUIRED. SEE SPECIAL PROVISIONS FOR COMPLETION DATE REQUIREMENTS.

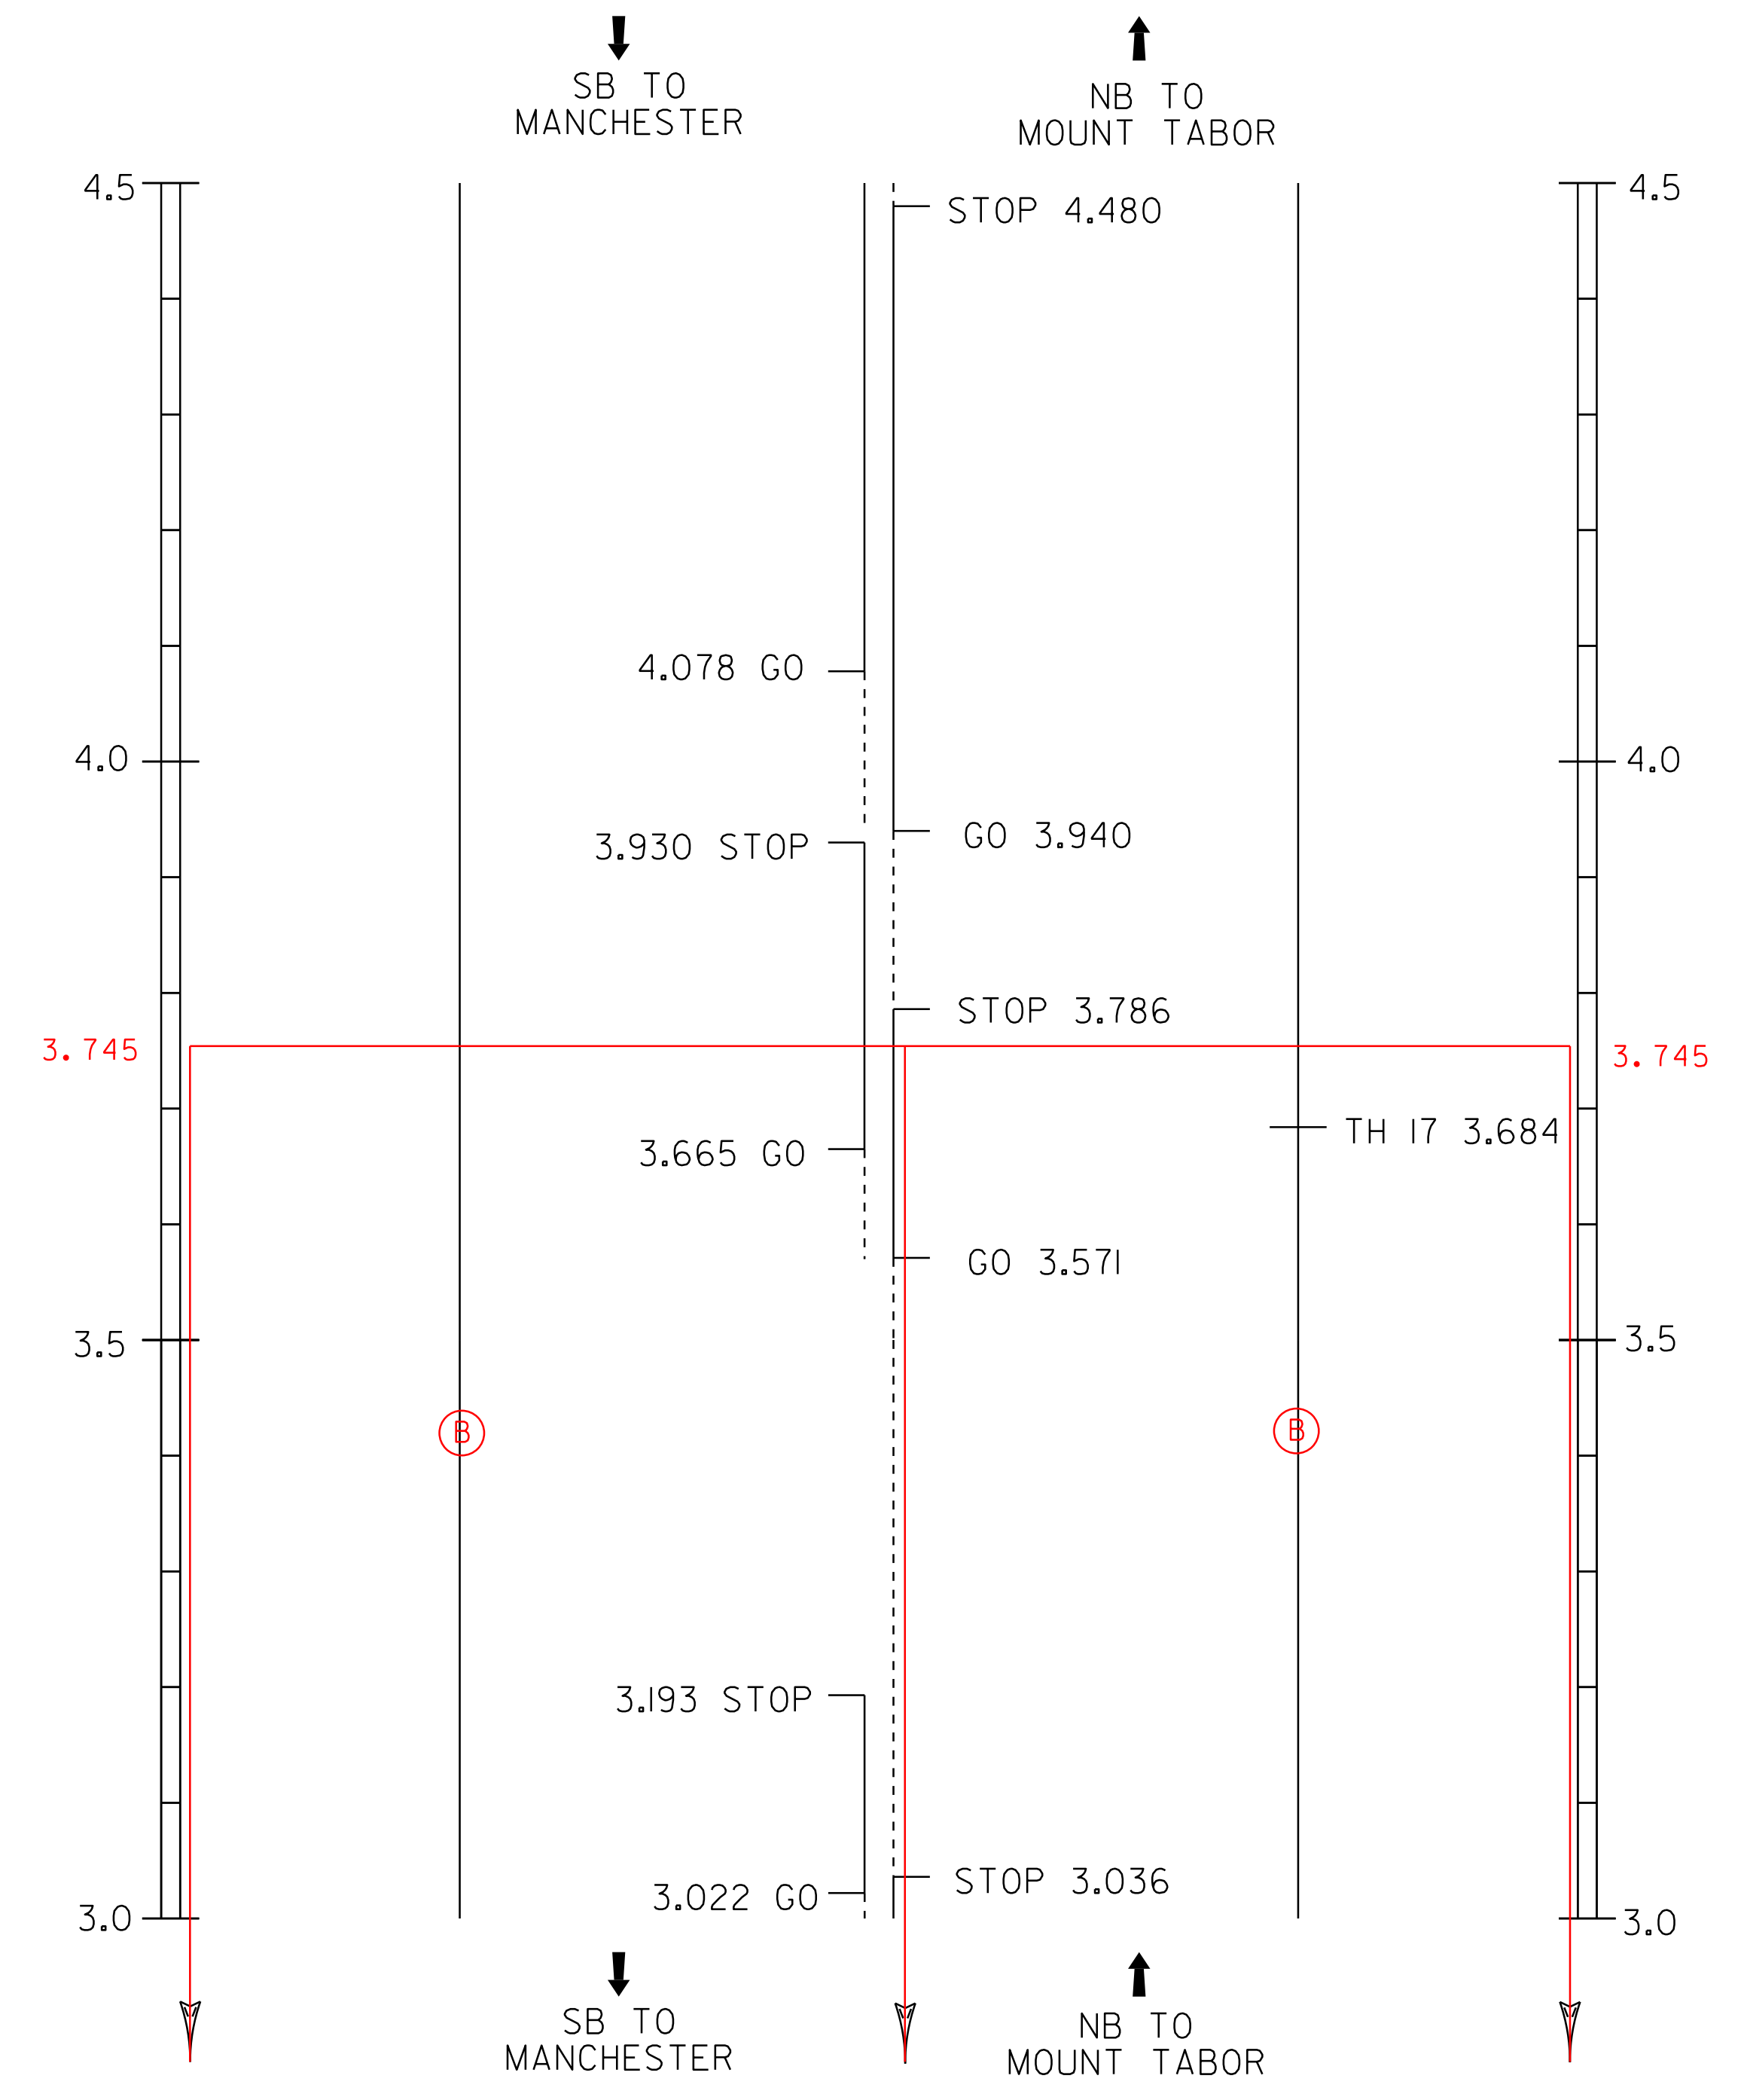

NOT TO SCALE

PROJECT LAYOUT SHEET #1	PROJECT NAME: DORSET - DANBY
	PROJECT NUMBER: NH SURF (24)
	FILE NAME: I0b118\p10b118.dgn
	PLOT DATE: 23-MAY-2012 16:06
PROJECT LEADER: FOWLER	DRAWN BY: HUNT
DESIGNED BY: HUNT	CHECKED BY: PAVT MGMT
IPARM FILE NAME: I0b118_09.i	SHEET 9 OF 16