

**INDEX OF SHEETS**

- 1 TITLE SHEET
- 2 PROJECT NOTES
- 3-5 PROJECT STANDARD DETAILS
- 6-8 QUANTITY SHEETS
- 9-12 TRAFFIC CONTROL SHEETS
- 13-14 REFERENCE SHEETS BRIDGE D4-3
- 15-16 REFERENCE SHEETS BRIDGE D4-4
- 17-18 REFERENCE SHEETS BRIDGE 5E & 5W
- 19-20 REFERENCE SHEETS BRIDGE 7E & 7W
- 21-22 REFERENCE SHEETS BRIDGE 9E & 9W
- 23-24 REFERENCE SHEETS BRIDGE 10E & 10W
- 25-28 REFERENCE SHEETS BRIDGE D11


**STANDARD SHEETS**

- E-100 01-02-2004
- E-100A 01-02-2004
- E-101 05-30-2003
- E-102 06-30-2003
- E-102A 05-01-2004
- E-103 03-01-2004
- E-106 03-01-2004
- E-107 06-30-2003
- E-107A 06-08-2009

# STATE OF VERMONT AGENCY OF TRANSPORTATION



## PROPOSED IMPROVEMENT BRIDGE PROJECT FAIR HAVEN - RUTLAND COUNTY OF RUTLAND ELEVEN BRIDGES ON OR OVER US ROUTE 4

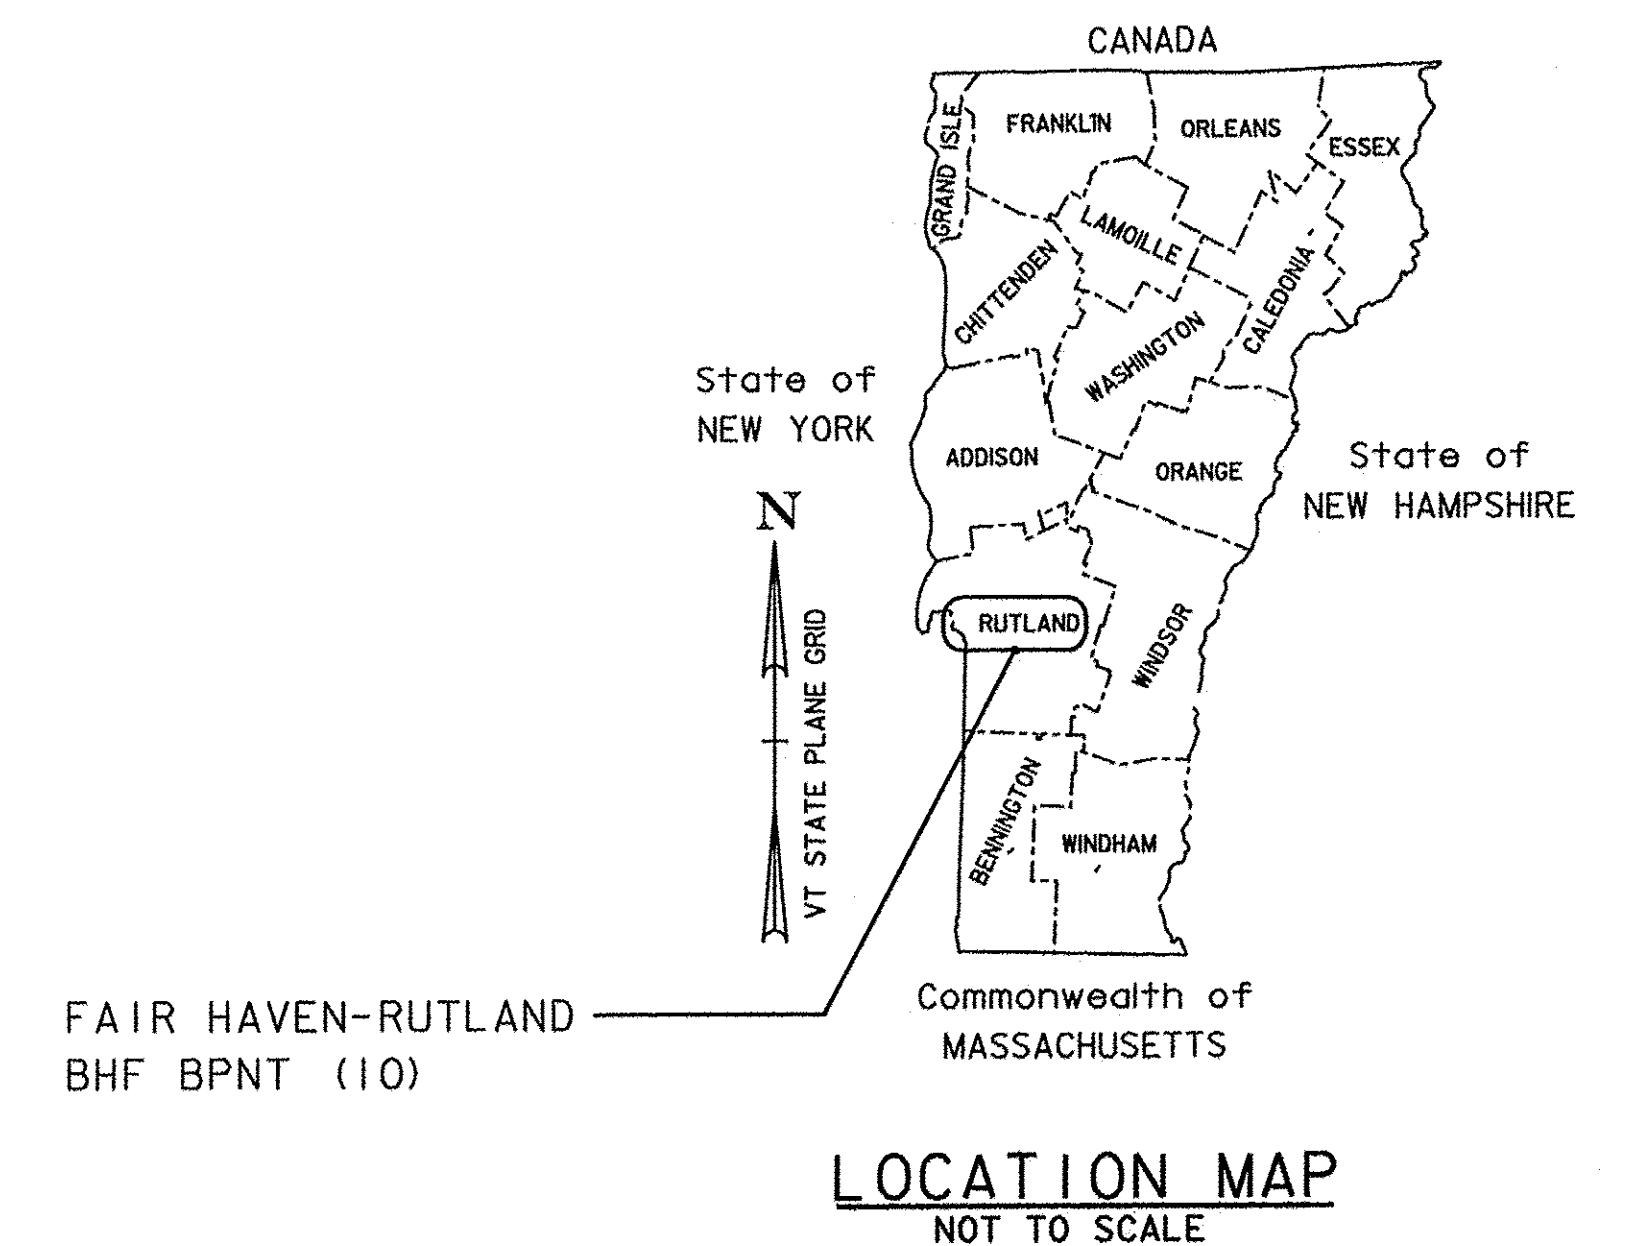

**RECORD PLANS**

CONTRACTOR: ATLAS PAINTING & SHEETING CORP. - AMHURST, NY

RESIDENT ENGINEER: TIM POCKETTE

CONSTRUCTION BEGAN: MAY 8, 2013

CONSTRUCTION COMPLETE: NOVEMBER 14, 2014

RECORD PLANS BY: TIM POCKETTE

I HEREBY CERTIFY THAT ALL THE CONSTRUCTION REQUIRED BY THIS SET OF DRAWINGS HAS BEEN ACCOMPLISHED AS INDICATED HEREIN.


BY [Signature] RESIDENT ENGINEER

DATE 02-19-2015

NOTE: Any further information concerning final quantities, amounts or other details relative to this project may be found at Central Files in the electronic archives.

**PROJECT LOCATION:** RUTLAND BR D4-3 (BUSINESS ROUTE 4 OVER CLARENDON RIVER) (MM 3.19)  
 RUTLAND BR D4-4 (BUSINESS ROUTE 4 OVER OTTER CREEK) (MM 6.28)  
 FAIR HAVEN BR 5E & 5W (US ROUTE 4 OVER VT ROUTE 22A) (MM 16.76)  
 FAIR HAVEN BR 7E & 7W (DUTTON AVE OVER US ROUTE 4) (MM 25.73)  
 CASTLETON BR 9E & 9W (DRAKE ROAD OVER US ROUTE 4) (MM 49.94)  
 CASTLETON BR 10E & 10W (US ROUTE 4 OVER VT ROUTE 30) (MM 54.49)  
 CASTLETON BR D11 (OLD NORTH ROAD OVER US ROUTE 4) (MM 68.96)

**PROJECT DESCRIPTION:** THIS PROJECT INVOLVES CLEANING, LEAD PAINT REMOVAL AND REPAINTING THE EXISTING STEEL SUPERSTRUCTURE MEMBERS AND MINOR ASSOCIATED WORK.

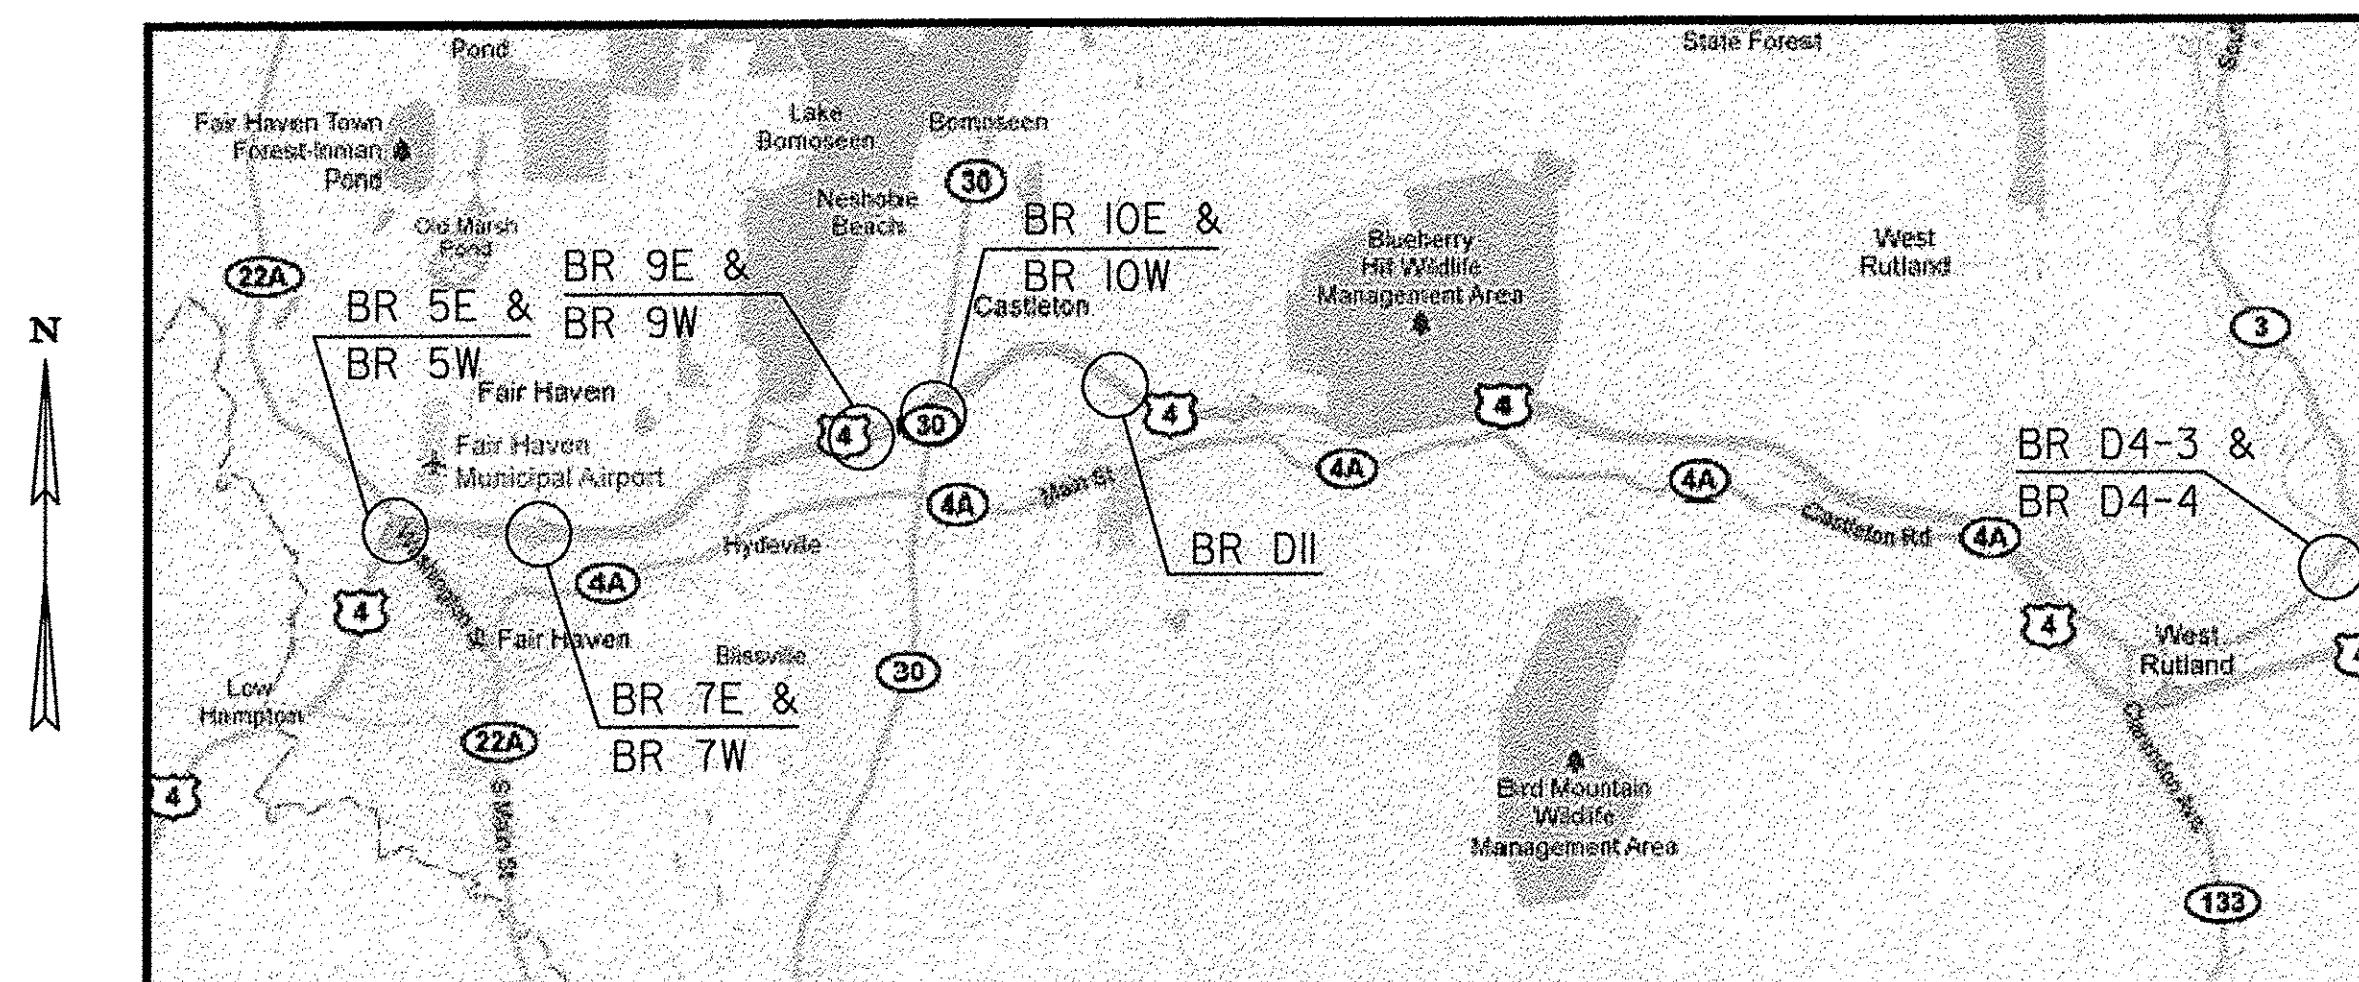

**PROJECT LIMITS PLAN**  
NOT TO SCALE

**CONVENTIONAL SYMBOLS**

COUNTY LINE	
TOWN LINE	
LIMITS OF ACCESS	
POINT OF ACCESS	
FENCE LINE	
STONE WALL	
TRAVELED WAY	
GUARD RAIL	
RAILROAD	
SURVEY LINE	
CULVERT	
POWER POLE	
TELEPHONE POLE	
TREES	
CONTROL OF ACCESS	
PROPERTY LINE	
R.O.W. TAKING LINE	
SLOPE RIGHTS	
TOP OF CUT	
TOE OF SLOPE	

SURVEYED BY : N/A  
 SURVEYED DATE : N/A

DATUM  
 VERTICAL N/A  
 HORIZONTAL N/A

THESE PLANS ARE SUBJECT TO SUCH ENGINEERING CHANGES AS MAY BE REQUIRED BY THE FEDERAL HIGHWAY ADMINISTRATION OR THE DIRECTOR OF PROGRAM DEVELOPMENT.

CONSTRUCTION IS TO BE CARRIED ON IN ACCORDANCE WITH THESE PLANS AND THE STANDARD SPECIFICATIONS FOR CONSTRUCTION DATED 2011, AS APPROVED BY THE FEDERAL HIGHWAY ADMINISTRATION ON JULY 20, 2011 FOR USE ON THIS PROJECT, INCLUDING ALL SUBSEQUENT REVISIONS AND SUCH REVISED SPECIFICATIONS AND SPECIAL PROVISIONS AS ARE INCORPORATED IN THESE PLANS.

DIRECTOR OF PROGRAM DEVELOPMENT  
 APPROVED [Signature] DATE 6-20-12

PROJECT MANAGER : MARK SARGENT

PROJECT NAME : FAIR HAVEN - RUTLAND  
 PROJECT NUMBER : BHF BPNT (10)

SHEET 1 OF 28 SHEETS

