


REVISION
DELETED OPTIONAL GIRDER
SPLICE
INCREASED LATERAL BRACING
TO 6x6x7/8 & RSH 5-21-69

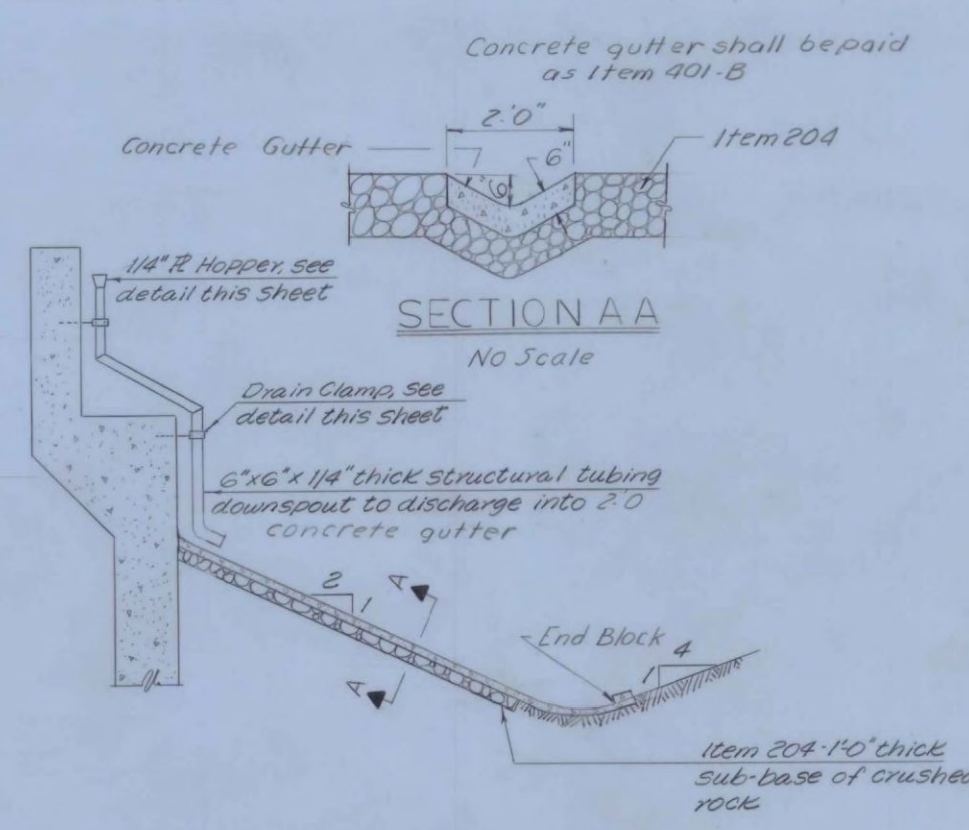

Downspouts to be placed inside of north fascia girders. Downspout is included in the price of the expansion joint. C to be paid for under Item 404-A.

DOWNSPOUT DETAIL AT EXPANSION JOINT
No Scale

- NOTES:
1. For General Notes, see BE-1001.
 2. For Cross Frame Notes, see BE-1007.
 3. All girders are parallel to the Major Chord.

FAIRHAVEN-RUTLAND
BHF BPNT (10)
PROJECT BRIDGE #10E & 10W
SHEET 24 OF 28
FOR INFORMATION ONLY

VERMONT
STATE HIGHWAY DEPARTMENT
TOWN OF CASTLETON
U.S. ROUTE 4
US RTE. 4 RELOCATION
OVER RTE. 30 RELOC.
SUPERSTRUCTURE DETAILS

McFARLAND - JOHNSON
CONSULTING ENGINEERS
BINGHAMTON, NEW YORK

DESIGNED W.D.S. CHECKED REC. DATE 9-16-68
DRAWN L.R.S. IN CHARGE H.G.C. SCALE AS SHOWN
PROJECT NO. AP020(150) SH 159 OF 24

CONTRACT NO. BR 1008