



**TYPICAL BRIDGE SECTION**  
SCALE: 1:40

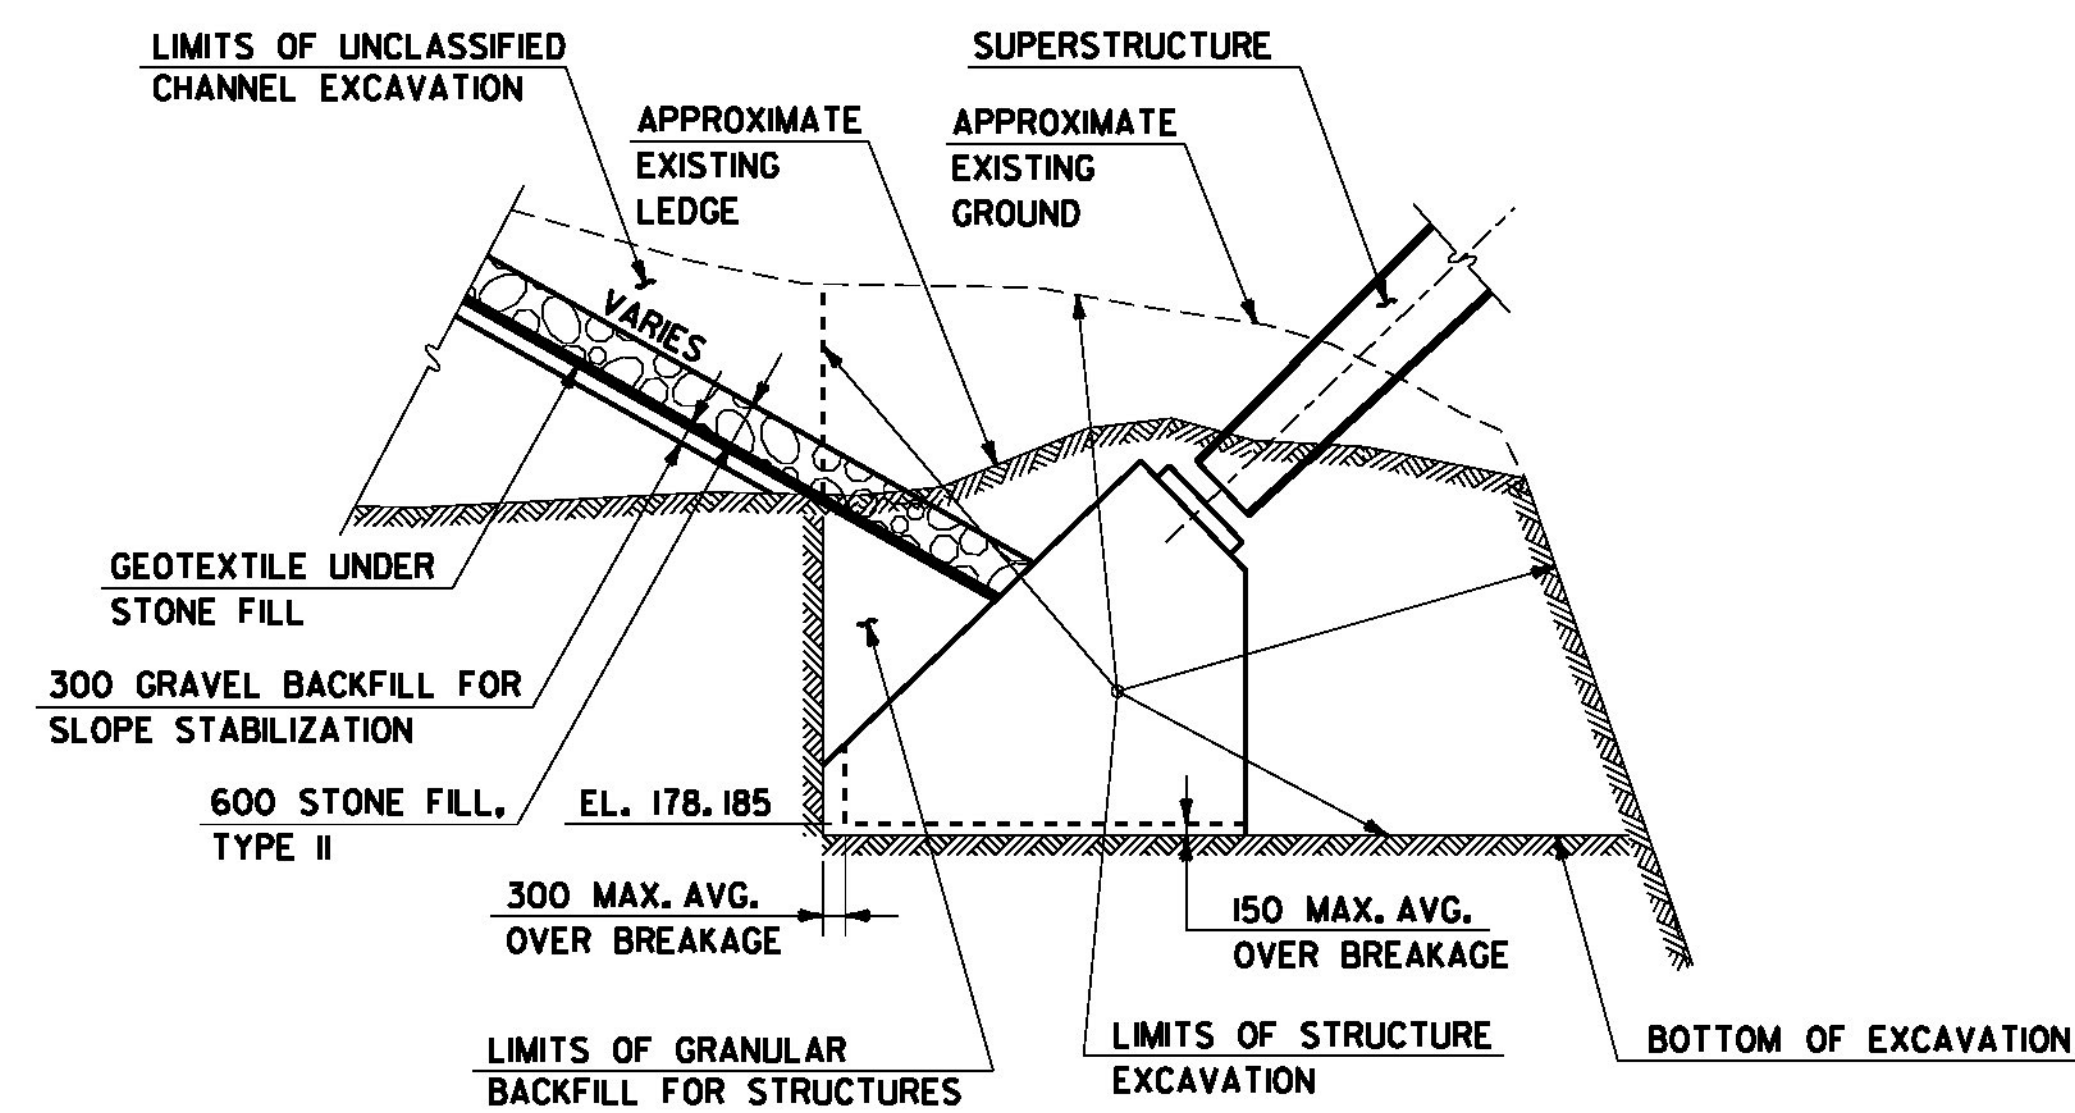



**SOUTH SLANT LEG FOOTING EARTHWORK SECTION**  
SCALE: 1:100

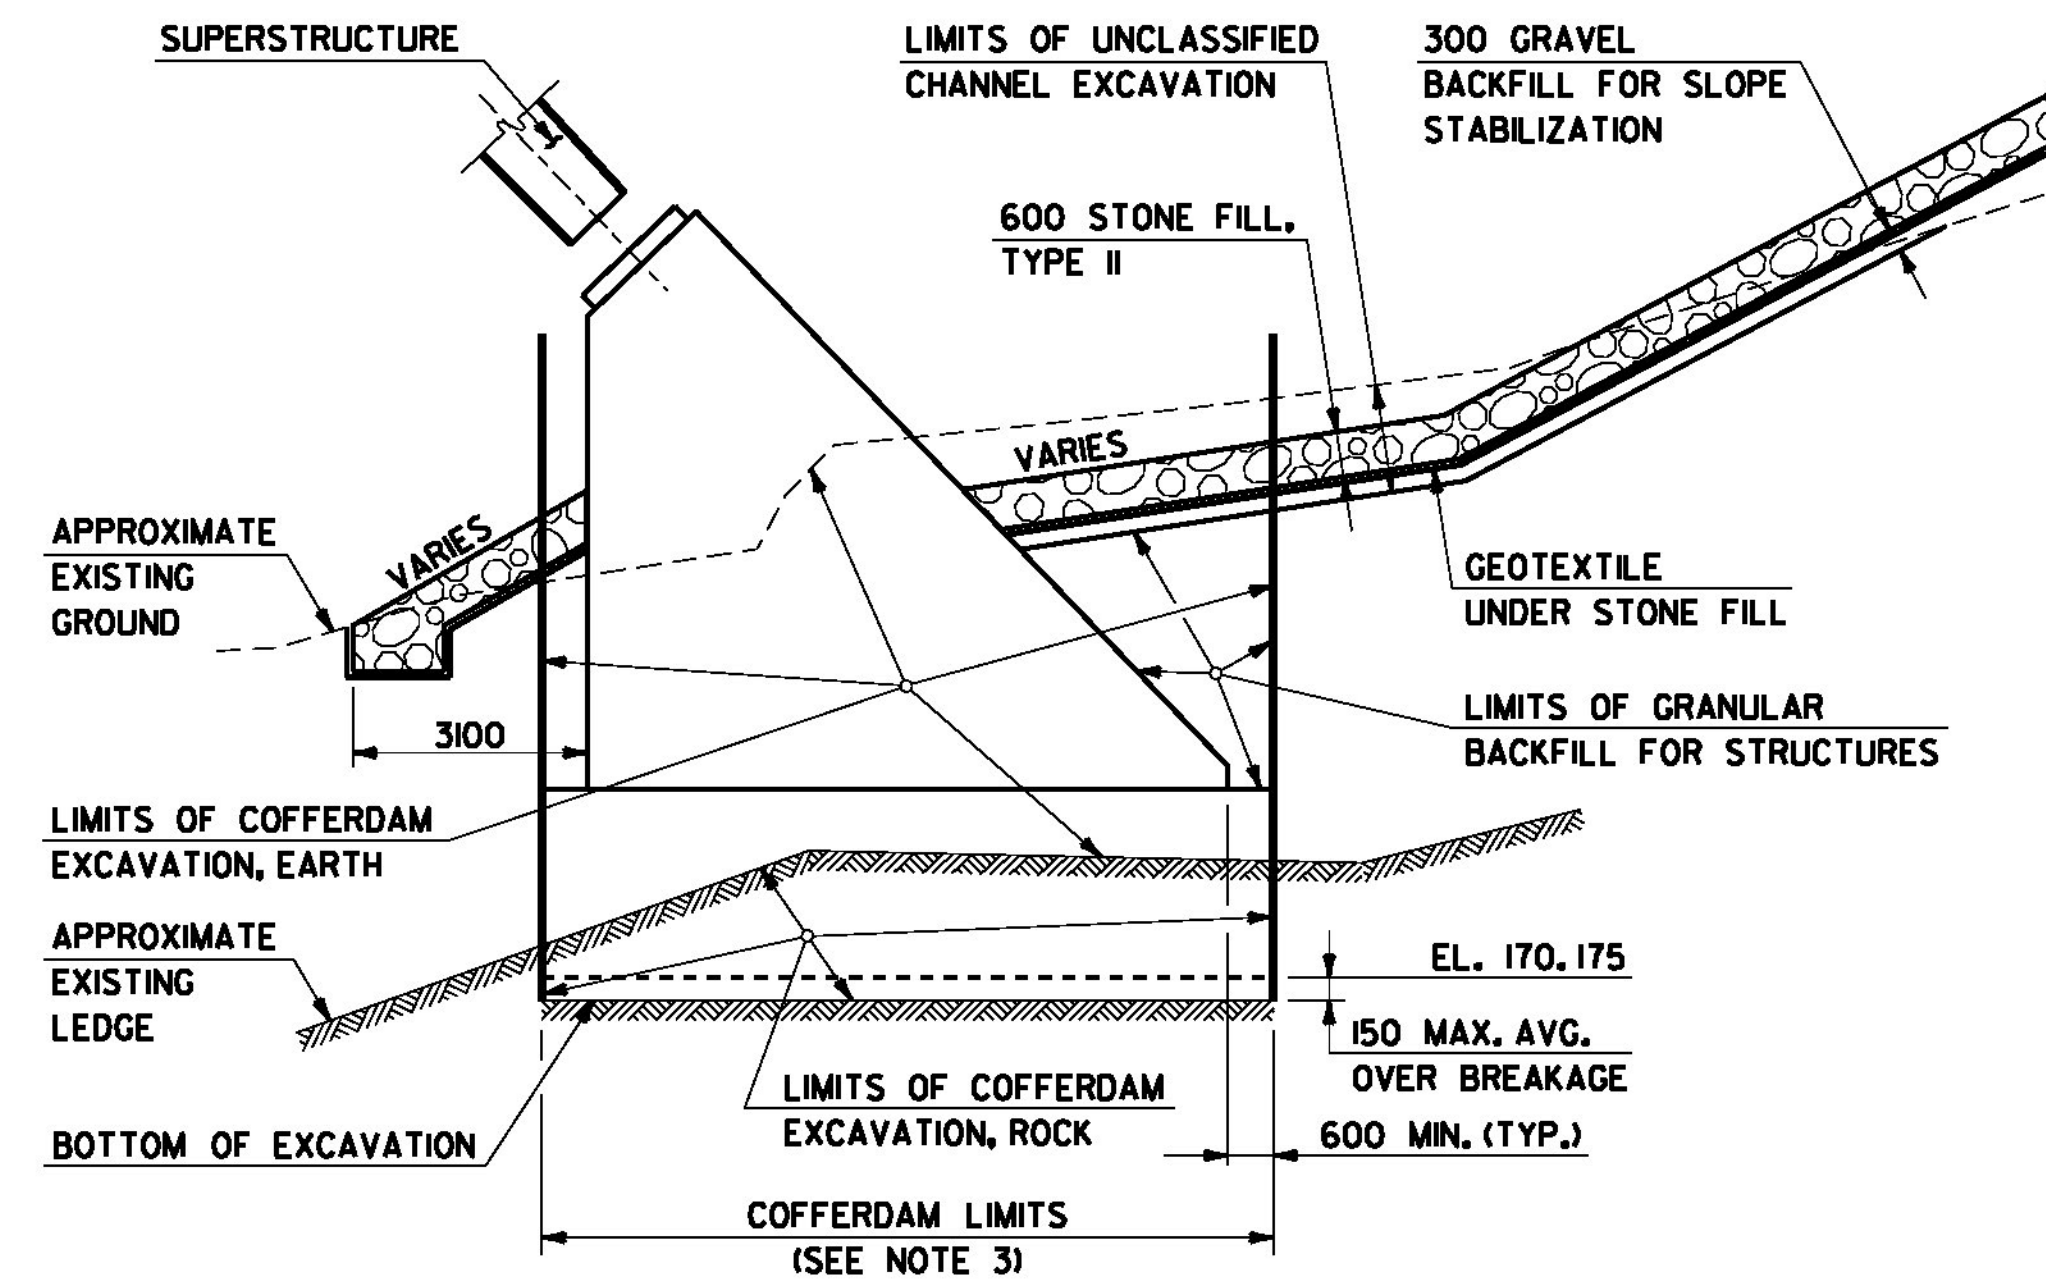

**NORTH SLANT LEG FOOTING EARTHWORK SECTION**  
SCALE: 1:100

**NOTES**

1. FOR ADDITIONAL TYPICAL SECTIONS, SEE SHEETS 5 & 6.
2. SECOND LIFT OF BITUMINOUS CONCRETE PAVEMENT TYPE IIS NOT INCLUDED IN THIS CONTRACT.
3. THE CONTRACTOR MAY CUT OFF TOPS OF COFFERDAM AND LEAVE IN PLACE TO THE SATISFACTION OF THE RESIDENT ENGINEER.

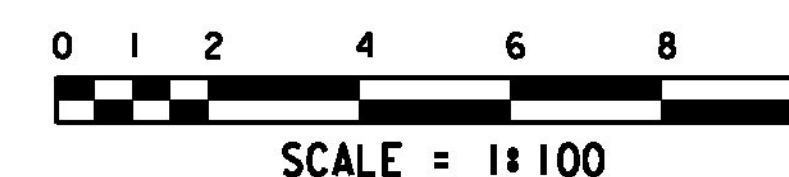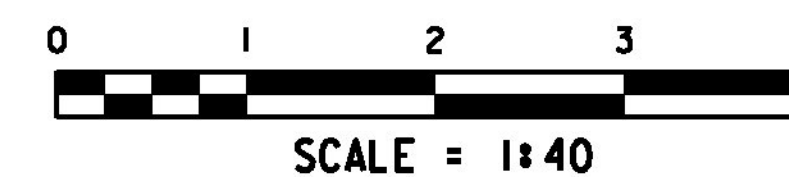

NOTE: ALL DIMENSIONS IN MILLIMETERS (mm) EXCEPT WHERE NOTED.

PROJECT NAME: MORRISTOWN  
PROJECT NUMBER: STP F 029-1(2)C/1

FILE NAME: z10b194ots.dgn PLOT DATE: 11-APR-2012  
PROJECT LEADER: DMB DRAWN BY: S. Merkwon  
DESIGNED BY: D. Kull CHECKED BY: R. Joy  
TYPICAL SECTIONS - 3 SHEET 7 OF 123