 
 
 
 
 
 
 
 
 
 

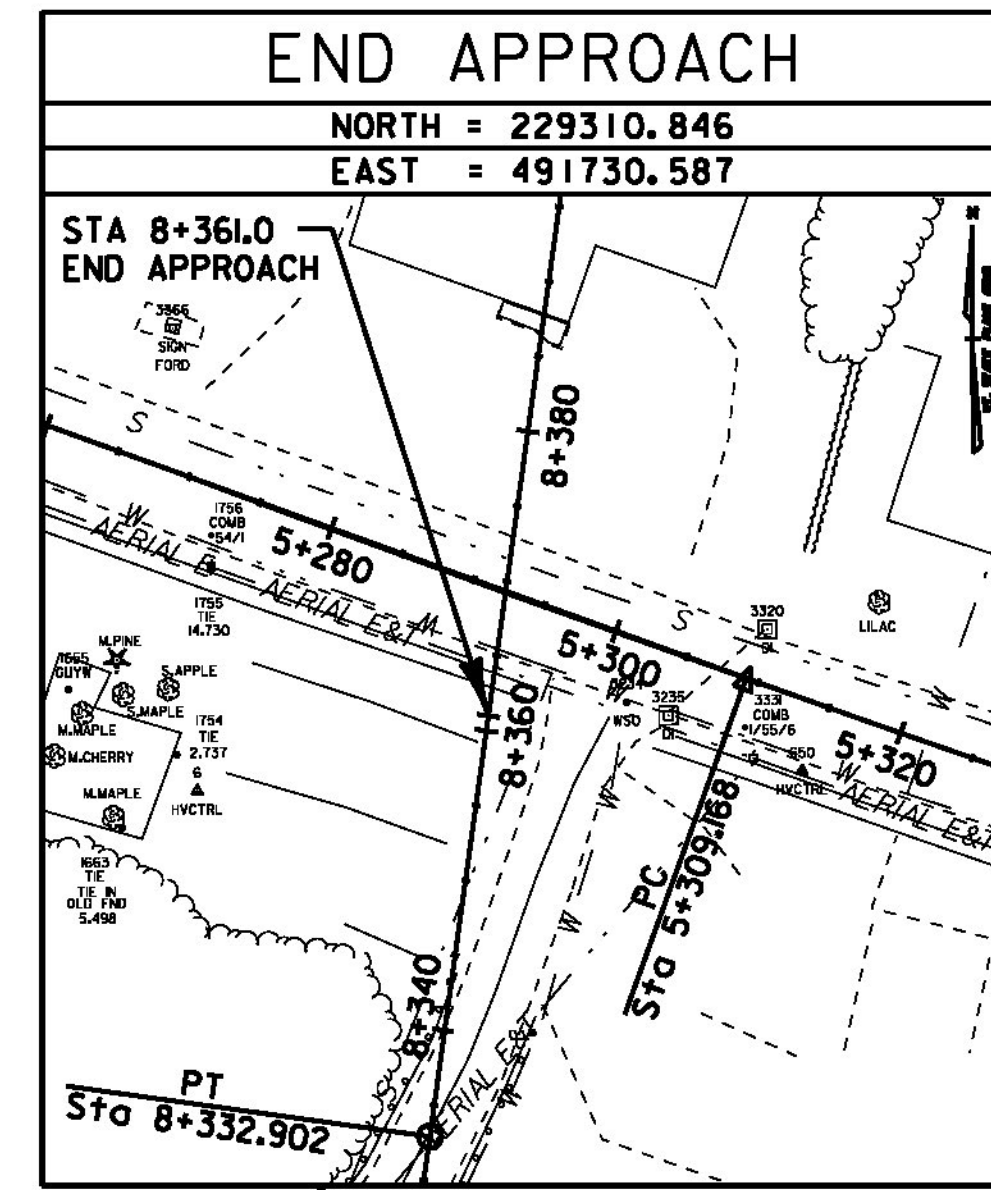
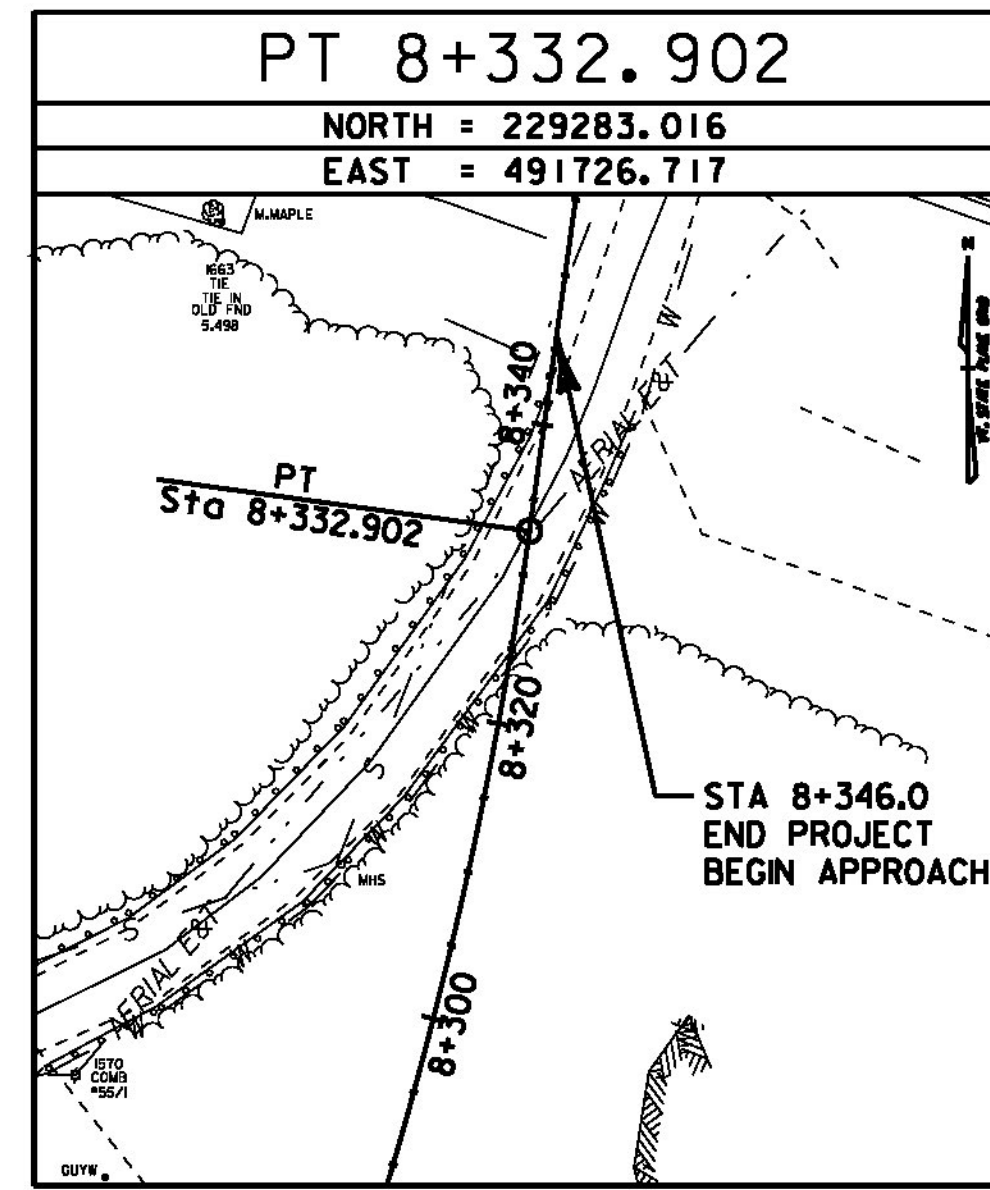
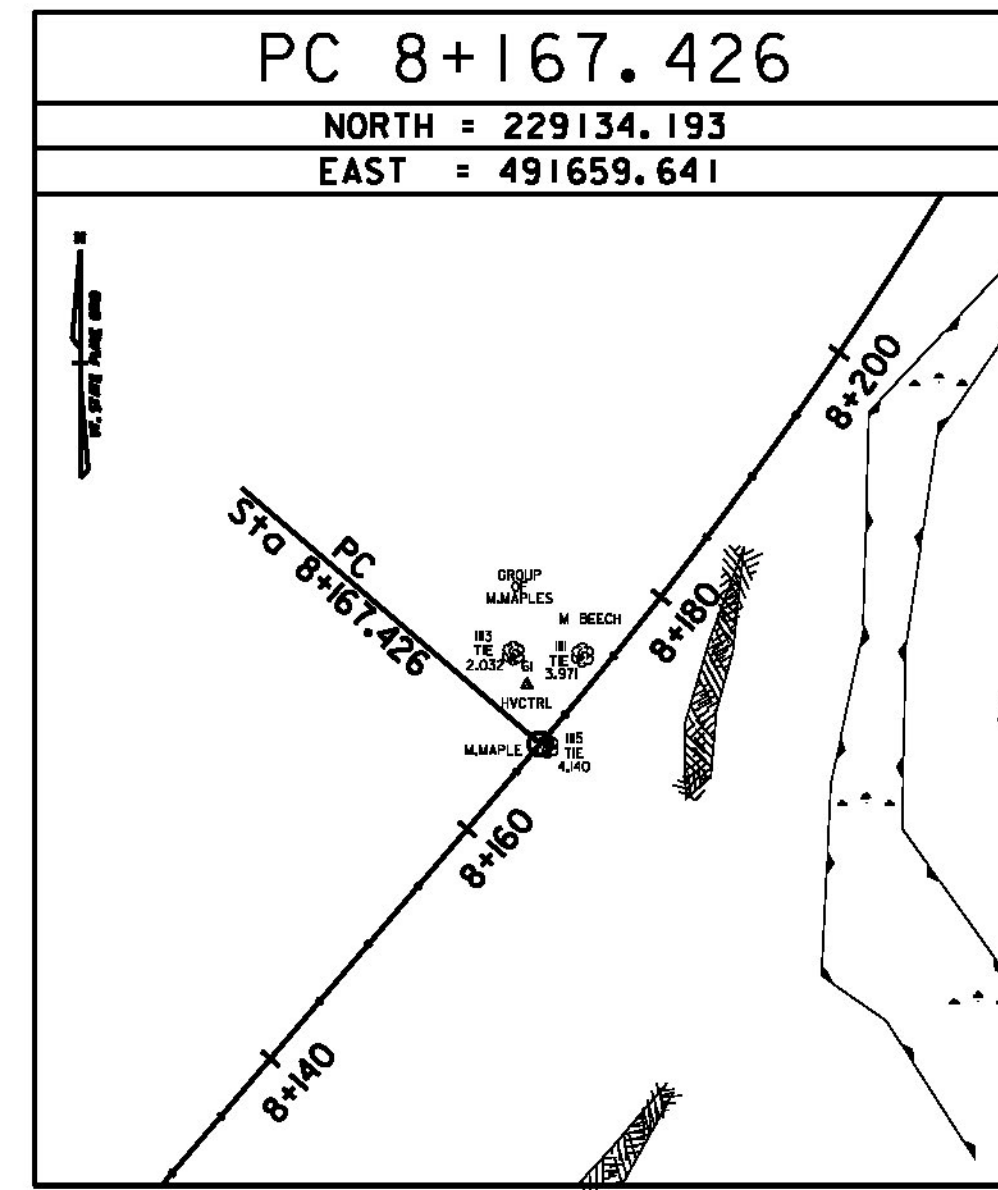


ALIGNMENT TIES

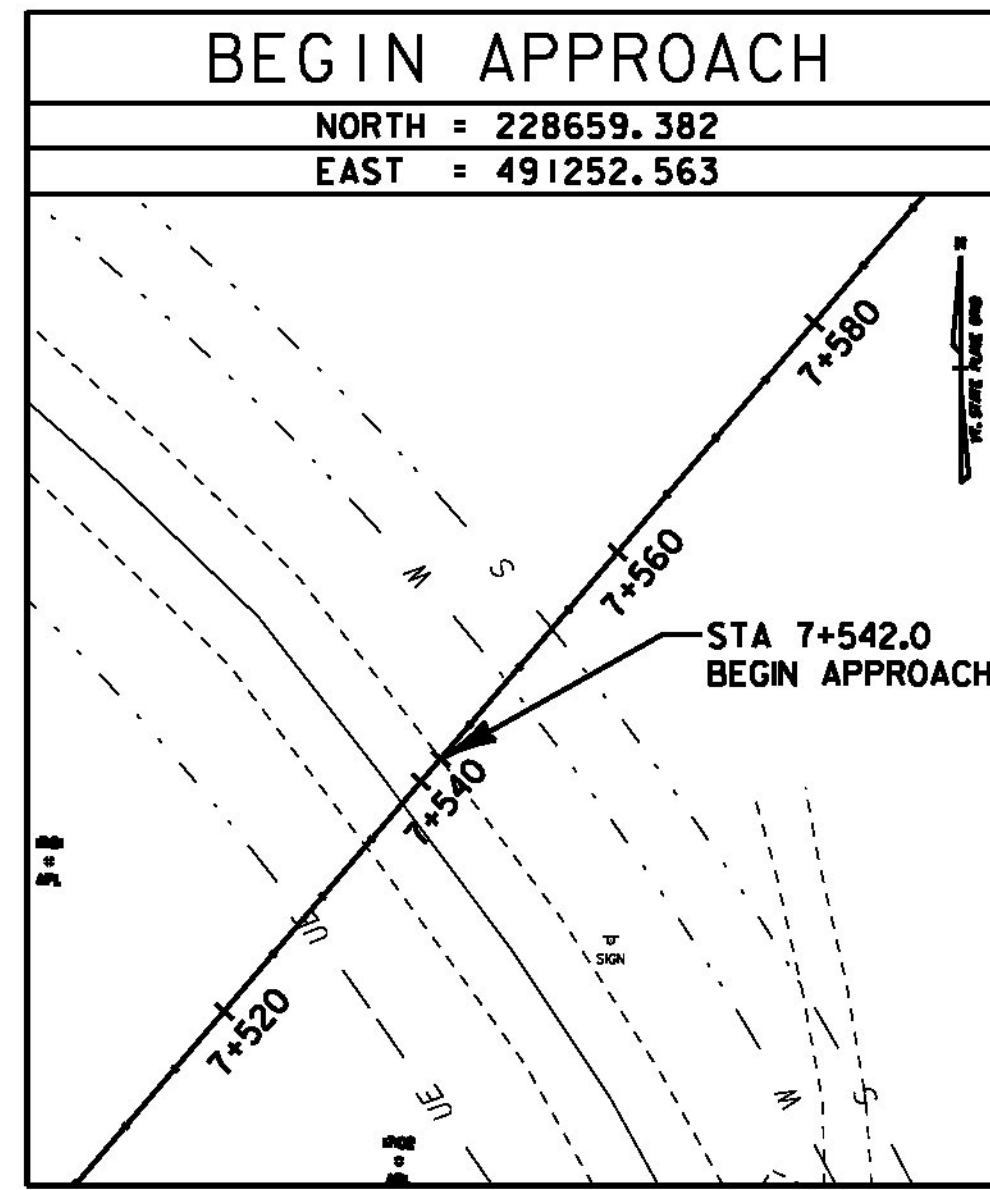

NOTE: ALL DIMENSIONS IN METERS (M) EXCEPT WHERE NOTED.

| | |
|--------------|---------------|
| DATUM | |
| VERTICAL | NAVD 88 |
| HORIZONTAL | NAD 83 (92) |
| ADJUSTMENT | Least Squares |

| | |
|-----------------------------------|------------------------|
| PROJECT NAME: MORRISTOWN | |
| PROJECT NUMBER: STP F 029-1(2)C/1 | |
| FILE NAME: z10b19411e03.dgn | PLOT DATE: 29-MAR-2012 |
| PROJECT LEADER: DMB | DRAWN BY: MJF |
| DESIGNED BY: BRC | CHECKED BY: DMB |
| TIE INFORMATION SHEET - 3 | SHEET 18 OF 123 |

