

DITCH BERM			
STA	W (mm)	H (mm)	L(m)
7+842.0, LT	300	300	2.7
7+842.0, RT	300	300	2.7
7+908.0, LT	300	600	10.0

CHAIN LINK FENCE, 1.8m  
VINYL COATED, GREEN  
7+760.0, LT TO 7+805.9, LT

7 STA 7+840.0, 10.5 LT TO STA 7+860.0, 18.9 LT  
CONSTRUCT 450mm x 21.0m OPTION PIPE  
RCP (CLASS III, CPEP (SL))  
CONSTRUCT PRCDI-A WITH TYPE B GRATE  
AT STA. 7+840.0, 10.5 LT  
CONSTRUCT 450mm END SECTION  
WITH 0.9m x 1.8m x 600mm TYPE II  
STONE PAD AT OUTLET

U5 STA 7+842.0, 7.5 LT TO STA 7+905.0, 7.5 LT  
CONSTRUCT 200mm x 63.0m UNDERDRAIN  
CONSTRUCT FLUSHING BASIN AT STA 7+842.0

STA 7+902.6, 4.125 RT TO STA 7+916.6, 4.125 RT  
450 mm SLEEVE (PVC)  
STA 7+903.6, 4.125 LT TO STA 7+916.6, 4.125 LT  
600 mm SLEEVE (PVC)

9 STA 7+905.0, 5.4 LT TO STA 7+905.0, 5.4 RT  
CONSTRUCT 450mm x 10.2m OPTION PIPE  
RCP (CLASS III, CPEP (SL))  
CONSTRUCT PRCDI-A WITH TYPE E GRATE  
AT STA 7+905.0, 6.0 LT

8 STA 7+905.0, 17.10 LT TO STA 7+944.0, 17.10 LT  
CONSTRUCT 450mm x 38.2m OPTION PIPE  
PCCSP (L6), CAAP (L5), PCCSP WITH  
TWO 45° ELBOWS,  
450mm METAL END SECTION AT INLET,  
AND 450mm METAL END SECTION AT OUTLET

U3 STA 7+752.0, 7.5 LT TO STA 7+840.0, 7.5 LT  
CONSTRUCT 200mm x 89.0m UNDERDRAIN  
CONSTRUCT FLUSHING BASIN AT STA 7+752.0

5 STA 7+750.0, 10.5 LT TO STA 7+840.0, 10.3 LT  
CONSTRUCT 450mm x 89.0m OPTION PIPE  
RCP (CLASS III, CPEP (SL))  
CONSTRUCT PRCDI-A WITH TYPE B  
GRATE, AT STA 7+750.0

6 STA 7+840.0, 11.6 RT TO STA 7+840.0, 10.3 LT  
CONSTRUCT 450mm x 21.0m OPTION PIPE  
RCP (CLASS III, CPEP (SL))  
CONSTRUCT PRCDI-A WITH TYPE B  
GRATE, AT STA 7+840.0, 11.6 RT

CONTRACTOR MAY CONSTRUCT TEMPORARY  
BRIDGE OR CAUSEWAY, MAXIMUM ALLOWABLE  
LIMITS OF IMPACT TO RIVER AND ISLAND ARE  
SHOWN, (PAID UNDER ITEM 900.645 - SPECIAL  
PROVISION (TEMPORARY ACCESS ROAD AND  
STAGING AREAS, BRIDGE))

TEMPORARY BRIDGE  
OR CAUSEWAY


STA 8+079.6, 4.125 LT TO STA 8+091.945, 4.126 LT  
600 mm SLEEVE (PVC)

STA 8+102.0, LT  
CONSTRUCT 1.2m x 33.7m x 300mm  
STONE PAD, TYPE I

OPENING OR PIPE TO BE SIZED  
TO SAFELY CONVEY THE  
02.33YR FLOOD EVENT

MATCHLINE STA 7+760

MATCHLINE STA 8+120

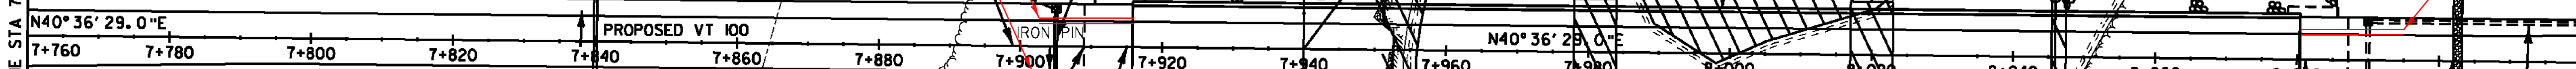

\*SEE DETAILED SKETCH FOR  
ADDED UNDERDRAIN, SHEET 20A

7+865.9, 25.1 RT  
STA 7+796.2, 19.0 RT  
TO STA 7+800.3, 18.8 RT 7+870, 25.1 RT  
APPROACH END TERMINAL  
(SEE STD. G-ID)

STA 7+777.0, 18.2 RT  
TO STA 7+800.3, 18.8 RT  
CONSTRUCT STEEL BEAM  
GUARDRAIL 7+870, 25.1 RT

STA 7+915.00  
END ROADWAY  
BEGIN BRIDGE

10 STA 7+905.0, 6.0 RT TO STA 7+915.0, 9.0 RT  
CONSTRUCT 450mm x 10.0m OPTION PIPE  
RCP (CLASS III, CPEP (SL))  
WITH 450mm END SECTION AT OUTLET  
CONSTRUCT PRCDI-A WITH TYPE E GRATE  
AT STA 7+905.0, 6.0 RT  
OUTLET INTO STONE LINED DITCH (SEE MISCELLANEOUS  
DETAIL SHEET FOR DITCH TYPICAL. SEE SPOT  
ELEVATIONS ON THIS PLAN FOR DITCH PROFILE.)

U6 STA 7+842.0, 7.5 RT TO STA 7+905.0, 7.5 RT  
CONSTRUCT 200mm x 63.0m UNDERDRAIN  
CONSTRUCT FLUSHING BASIN AT STA 7+842.0

U4 STA 7+752.0, 7.5 RT TO STA 7+840.0, 7.5 RT  
CONSTRUCT 200mm x 89.0m UNDERDRAIN  
CONSTRUCT FLUSHING BASIN AT STA 7+752.0

SPECIAL DITCH WITH STONE FILL TYPE II  
7+915.0, RT TO STA 7+939.0, RT  
SEE MISCELLANEOUS DETAIL SHEET

SPECIAL DITCH - VEGETATED SWALE  
7+860.0, LT TO STA 7+905.0, LT  
SEE CROSS SECTIONS FOR SWALE GEOMETRY

RECONSTRUCT GRAVEL DRIVE  
WITHIN THE IMPACTED LIMITS  
WITH SUBBASE OF GRAVEL  
(300mm DEEP) AND 75mm  
AGGREGATE SURFACE COURSE

STA 7+766 RT TO 7+808 RT  
CONSTRUCT RETAINING WALL.  
SEE RETAINING WALL PLAN  
SHEET.

PERMANENT  
IMPACT LINE

STORAGE UNITS

STORAGE UNITS

LEGEND

- DITCH BERM
- STONE CHECK DAM
- DRAINAGE NOTE  
(SEE DRAINAGE DETAIL SHEET)
- UNDERDRAIN NOTE  
(SEE ITEM DETAIL SHEET)



NOTES:

1. SEE RIGHT-OF-WAY PLANS FOR PERMANENT  
AND TEMPORARY RIGHT-OF-WAY INFORMATION.
2. SEE MISCELLANEOUS DETAIL SHEET FOR DITCH  
BERM DETAILS.

NOTE: ALL DIMENSIONS IN METERS (M) EXCEPT WHERE NOTED.

PROJECT NAME:	MORRISTOWN	PLOT DATE:	29-MAR-2012
PROJECT NUMBER:	STP F 029-(K)C/1	DRAWN BY:	MAL
FILE NAME:	z10b194104.dgn	DESIGNED BY:	BRC
LAYOUT SHEET - 2		CHECKED BY:	DMB
		SHEET	20 OF 123