
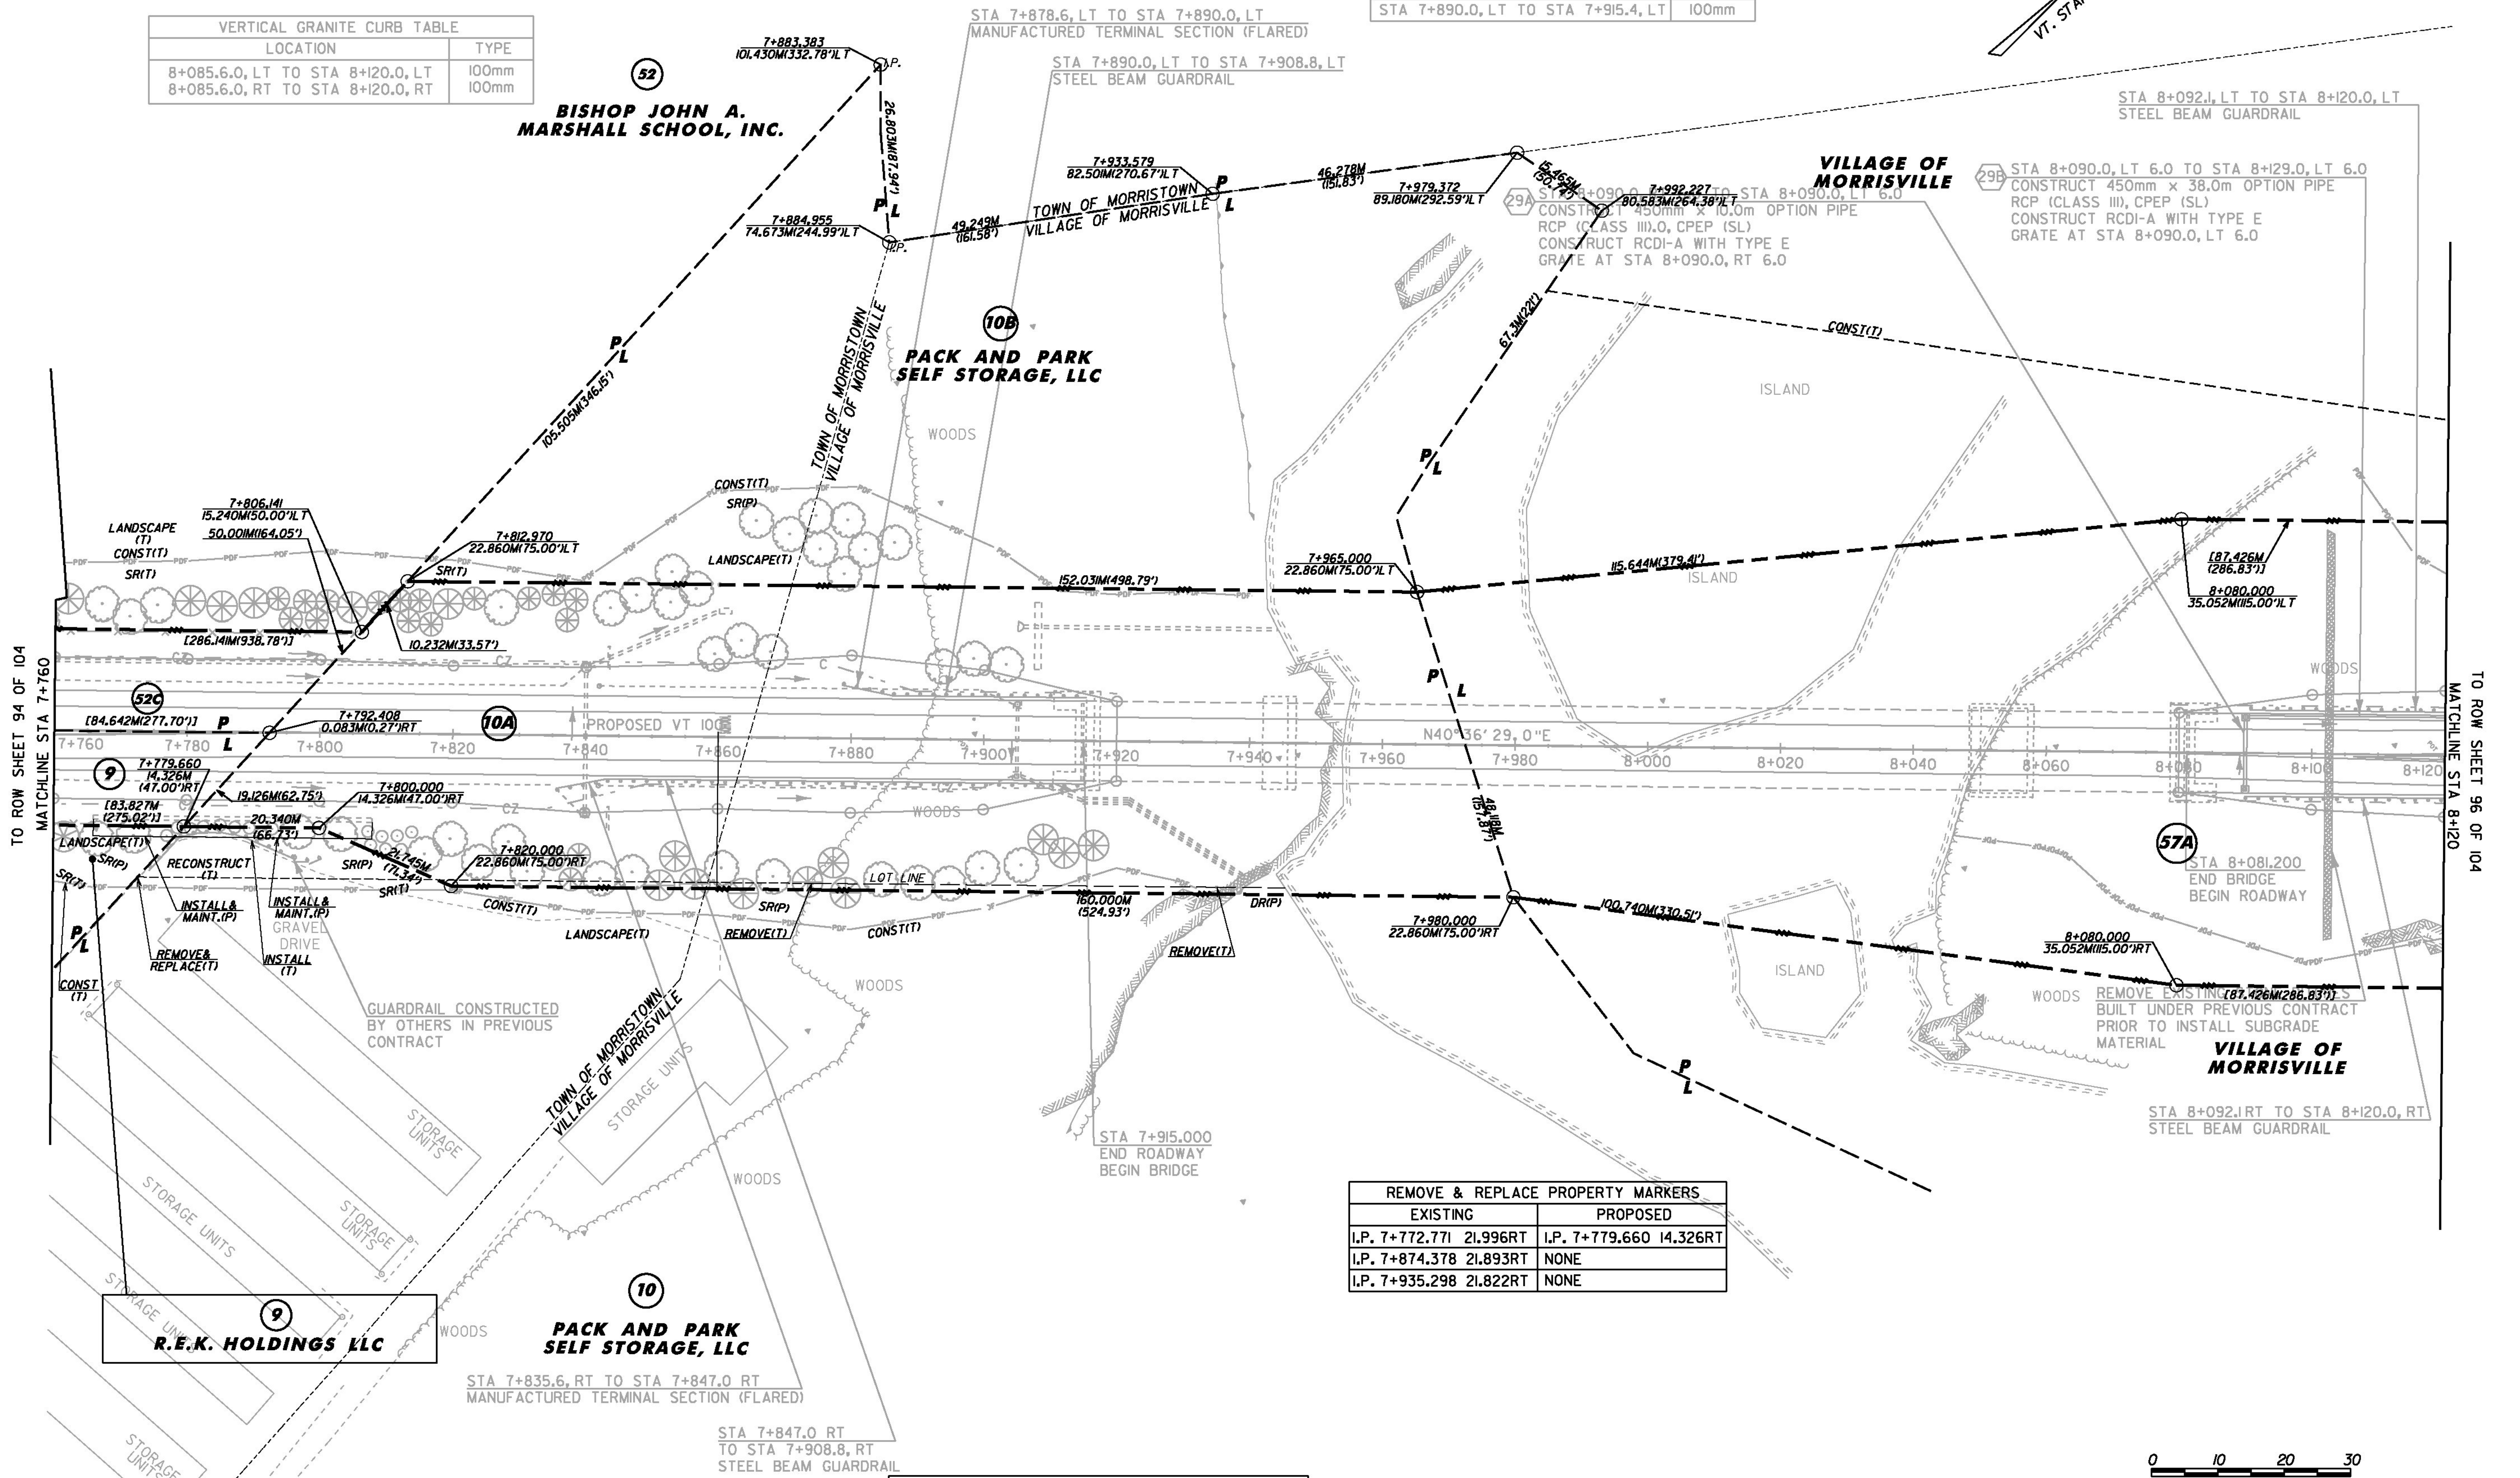


| CHAIN LINK FENCE | |
|----------------------------|--|
| 7+760.0, LT TO 7+805.9, LT | |
| 7+760.0, RT TO 7+766.0, RT | |

| VERTICAL GRANITE CURB TABLE | |
|----------------------------------|-------|
| LOCATION | TYPE |
| 8+085.6,0, LT TO STA 8+120.0, LT | 100mm |
| 8+085.6,0, RT TO STA 8+120.0, RT | 100mm |


| TREATED TIMBER CURB TABLE | |
|------------------------------------|-------|
| LOCATION | TYPE |
| STA 7+847.0, RT TO STA 7+915.4, RT | 100mm |
| STA 7+890.0, LT TO STA 7+915.4, LT | 100mm |

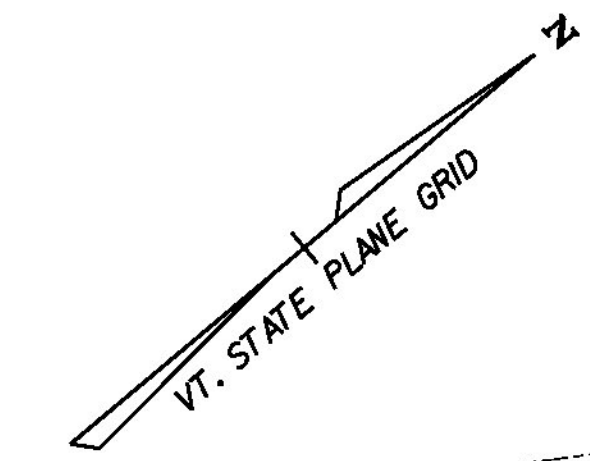

TO ROW SHEET 94 OF 104
MATCHLINE STA 7+760

TO ROW SHEET 96 OF 104
MATCHLINE STA 8+120

| REMOVE & REPLACE PROPERTY MARKERS | | | |
|-----------------------------------|----------|----------------|----------|
| EXISTING | | PROPOSED | |
| I.P. 7+772.771 | 21.996RT | I.P. 7+779.660 | 14.326RT |
| I.P. 7+874.378 | 21.893RT | | NONE |
| I.P. 7+935.298 | 21.822RT | | NONE |

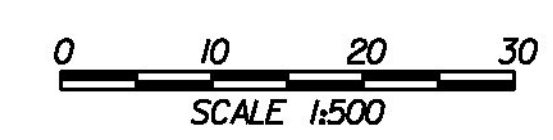

NOTE: ALL DIMENSIONS IN METERS (M) EXCEPT WHERE NOTED.

LINES SHOWN ON THIS PLAN AS EXISTING PROPERTY LINES P/L ARE BELIEVED TO BE ACCURATE BUT SHOULD NOT BE RELIED UPON FOR PURPOSES UNRELATED TO THE STATE OF VERMONT'S ACQUISITION OF LAND AND RIGHTS FOR THIS PROJECT.

NOTE: ACQUISITIONS SHOWN ON THIS SHEET PERTAIN TO BRIDGE CONSTRUCTION (CONTRACT 1) AND ASSOCIATED HIGHWAY CONSTRUCTION; SEE ACCOMPANYING SHEET FOR ADDITIONAL INFORMATION.

R.E.K. HOLDINGS LLC

PACK AND PARK SELF STORAGE, LLC

BISHOP JOHN A. MARSHALL SCHOOL, INC.

VILLAGE OF MORRISVILLE

PACK AND PARK SELF STORAGE, LLC

VILLAGE OF MORRISVILLE

FOR R.O.W. USE ONLY

ROW LAYOUT PLAN #4A

| | | | |
|-----------------|-------------------|-------------|-------------|
| PROJECT NAME: | MORRISTOWN | PLOT DATE: | 12-MAR-2012 |
| PROJECT NUMBER: | STP F 029-(K2)C/1 | DRAWN BY: | E. PIERCE |
| FILE NAME: | 78d082L04A.dgn | CHECKED BY: | E. PIERCE |
| DESIGNED BY: | BRC | SHEET | 25 OF 123 |
| ROW SHEET | 95A OF 104 | | |