



**LEGEND**

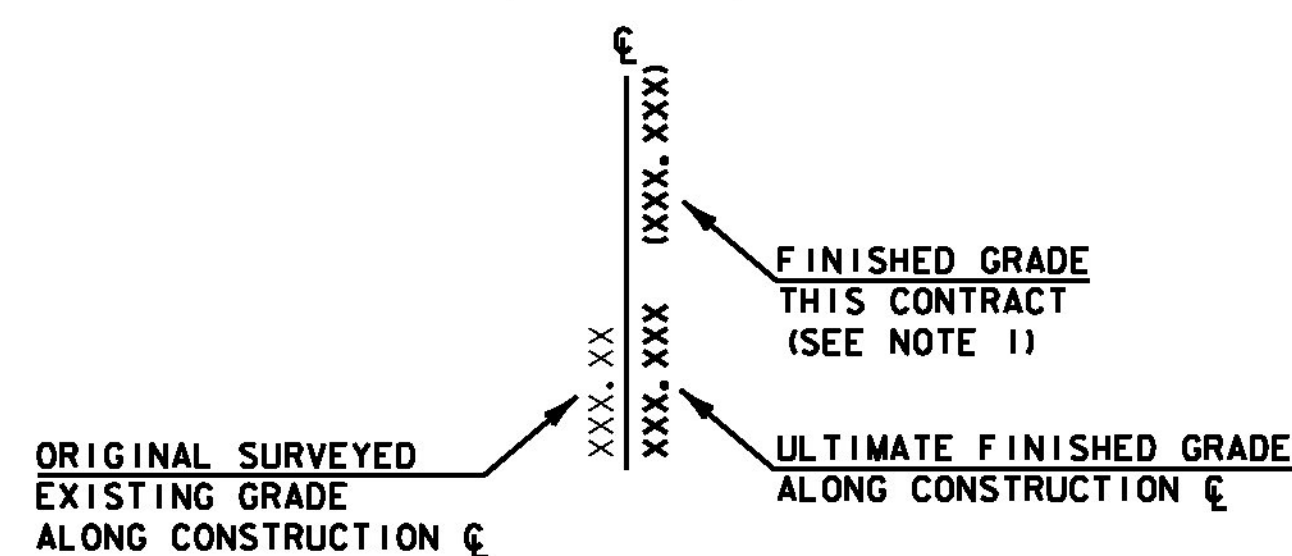

**NOTE:**

- NO SELECT MATERIALS OR PAVEMENT WILL BE PLACED FOR THIS CONTRACT OUTSIDE THE LIMITS OF THE BRIDGE AS NOTED. SEE DETAILS AND CROSS SECTIONS FOR LIMITS OF CONSTRUCTION.
- GRADES SHOWN ARE FOR FINAL GRADE AT THE END OF THE CONTRACT. INTERIM GRADING REQUIRED FOR DELIVERY OF STEEL OR OTHER PURPOSES ARE AT THE DISCRETION OF THE CONTRACTOR WITH APPROVAL BY THE ENGINEER.

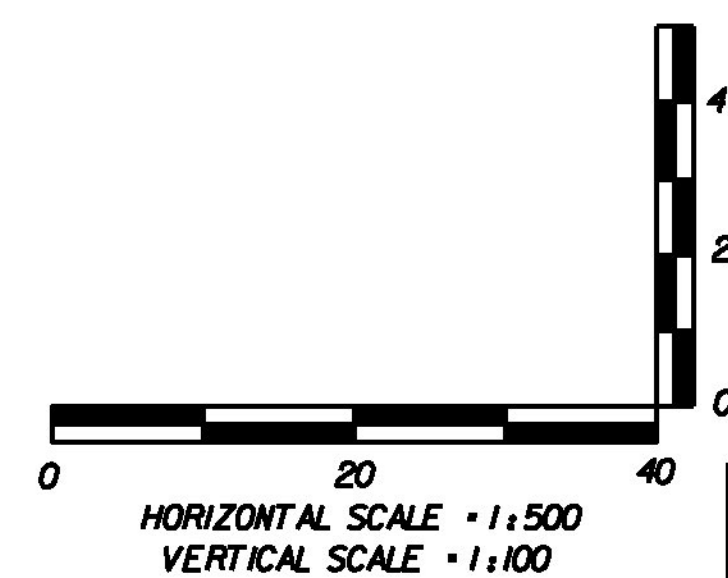

PROJECT NAME:	MORRISTOWN
PROJECT NUMBER:	STP F 029-1(2)C/1
FILE NAME:	z10b194prosh10.dgn
PLOT DATE:	29-MAR-2012
PROJECT LEADER:	DMB
DRAWN BY:	MAL
DESIGNED BY:	BRC
CHECKED BY:	DMB
PROFILE SHEET - 3	SHEET 30 OF 123