


MATCHLINE STA 7+760

MATCHLINE STA 8+120

**LEGEND**  
 ———> EXISTING DRAINAGE PATTERN

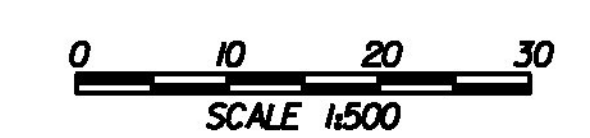

PROJECT NAME: MORRISTOWN	
PROJECT NUMBER: STP F 029-1(2)C/1	
FILE NAME: z10b194ec04.dgn	PLOT DATE: 29-MAR-2012
PROJECT LEADER: DMB	DRAWN BY: MAL
DESIGNED BY: BRC	CHECKED BY: DMB
EXISTING CONDITIONS SITE PLAN - 2	SHEET 41 OF 123

