


PLAN
 SCALE: 1:400
 SCALE IN METERS

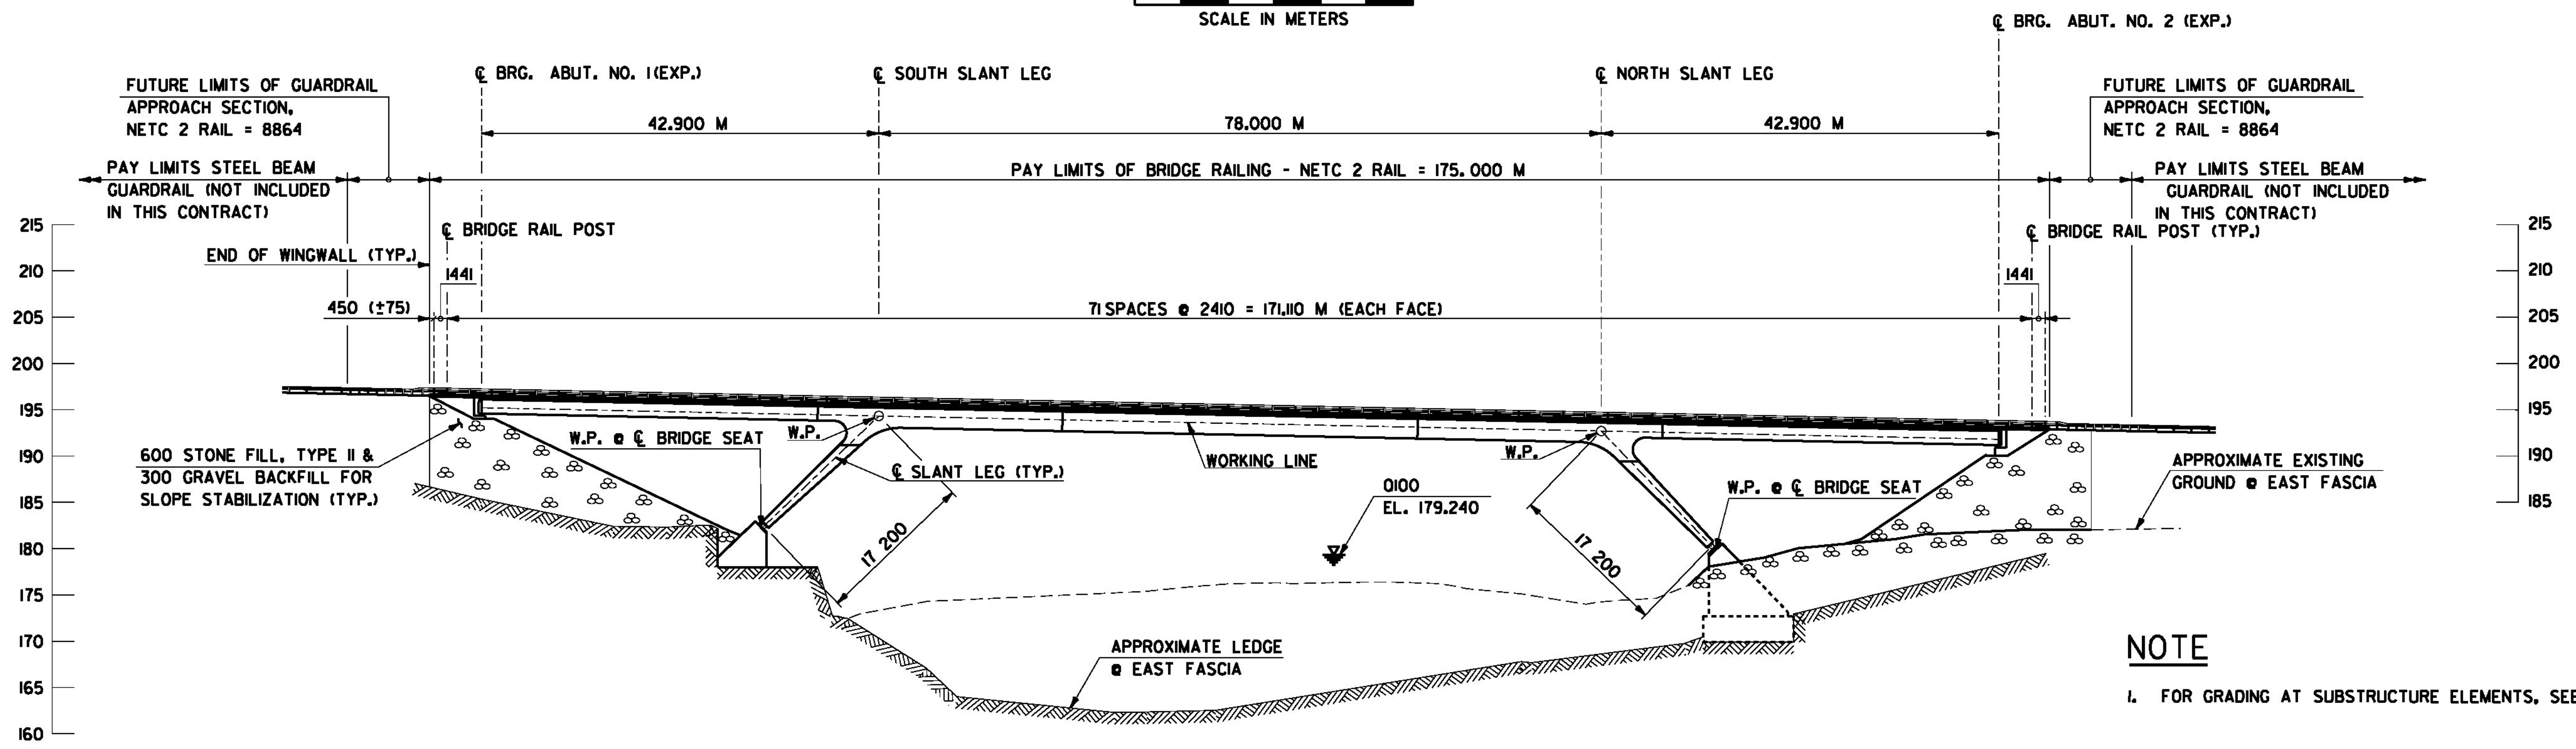

ELEVATION
 SCALE: 1:400
 SCALE IN METERS

NOTE
 1. FOR GRADING AT SUBSTRUCTURE ELEMENTS, SEE SHEET 70.

NOTE: ALL DIMENSIONS IN MILLIMETERS (mm) EXCEPT WHERE NOTED.
 ALL ELEVATIONS SHOWN IN METERS (M).

PROJECT NAME:	MORRISTOWN
PROJECT NUMBER:	STP F 029-1(2)C/1
FILE NAME:	z10b194ape.dgn
PROJECT LEADER:	DMB
DESIGNED BY:	D. Kull
PLAN AND ELEVATION	
PLOT DATE:	29-MAR-2012
DRAWN BY:	P. Dustin
CHECKED BY:	R. Joy
SHEET	69 OF 123

