


- LEGEND**
- STONE FILL, TYPE II
  - FILL LIMITS
  - CUT LIMITS
  - EXISTING CONTOURS
  - PROPOSED CONTOURS

**GRADING PLAN**  
SCALE: 1:200

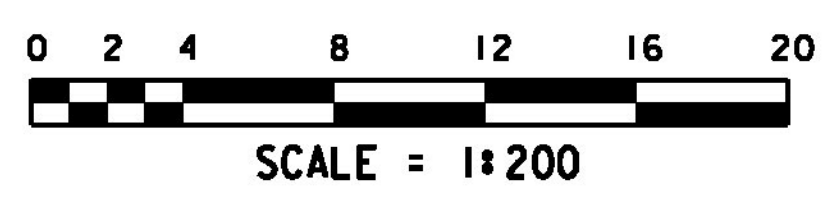

NOTE: ALL DIMENSIONS IN METERS (M) EXCEPT WHERE NOTED.

PROJECT NAME:	MORRISTOWN	PLOT DATE:	30-MAR-2012
PROJECT NUMBER:	STP F 029-1(2)C/1	DRAWN BY:	P. Dustin
FILE NAME:	z10b194agp.dgn	CHECKED BY:	R. Joy
PROJECT LEADER:	DMB	SHEET	70 OF 123
DESIGNED BY:	S. Della		
GRADING PLAN			

