



FRAME ELEVATION
SCALE: 1:125

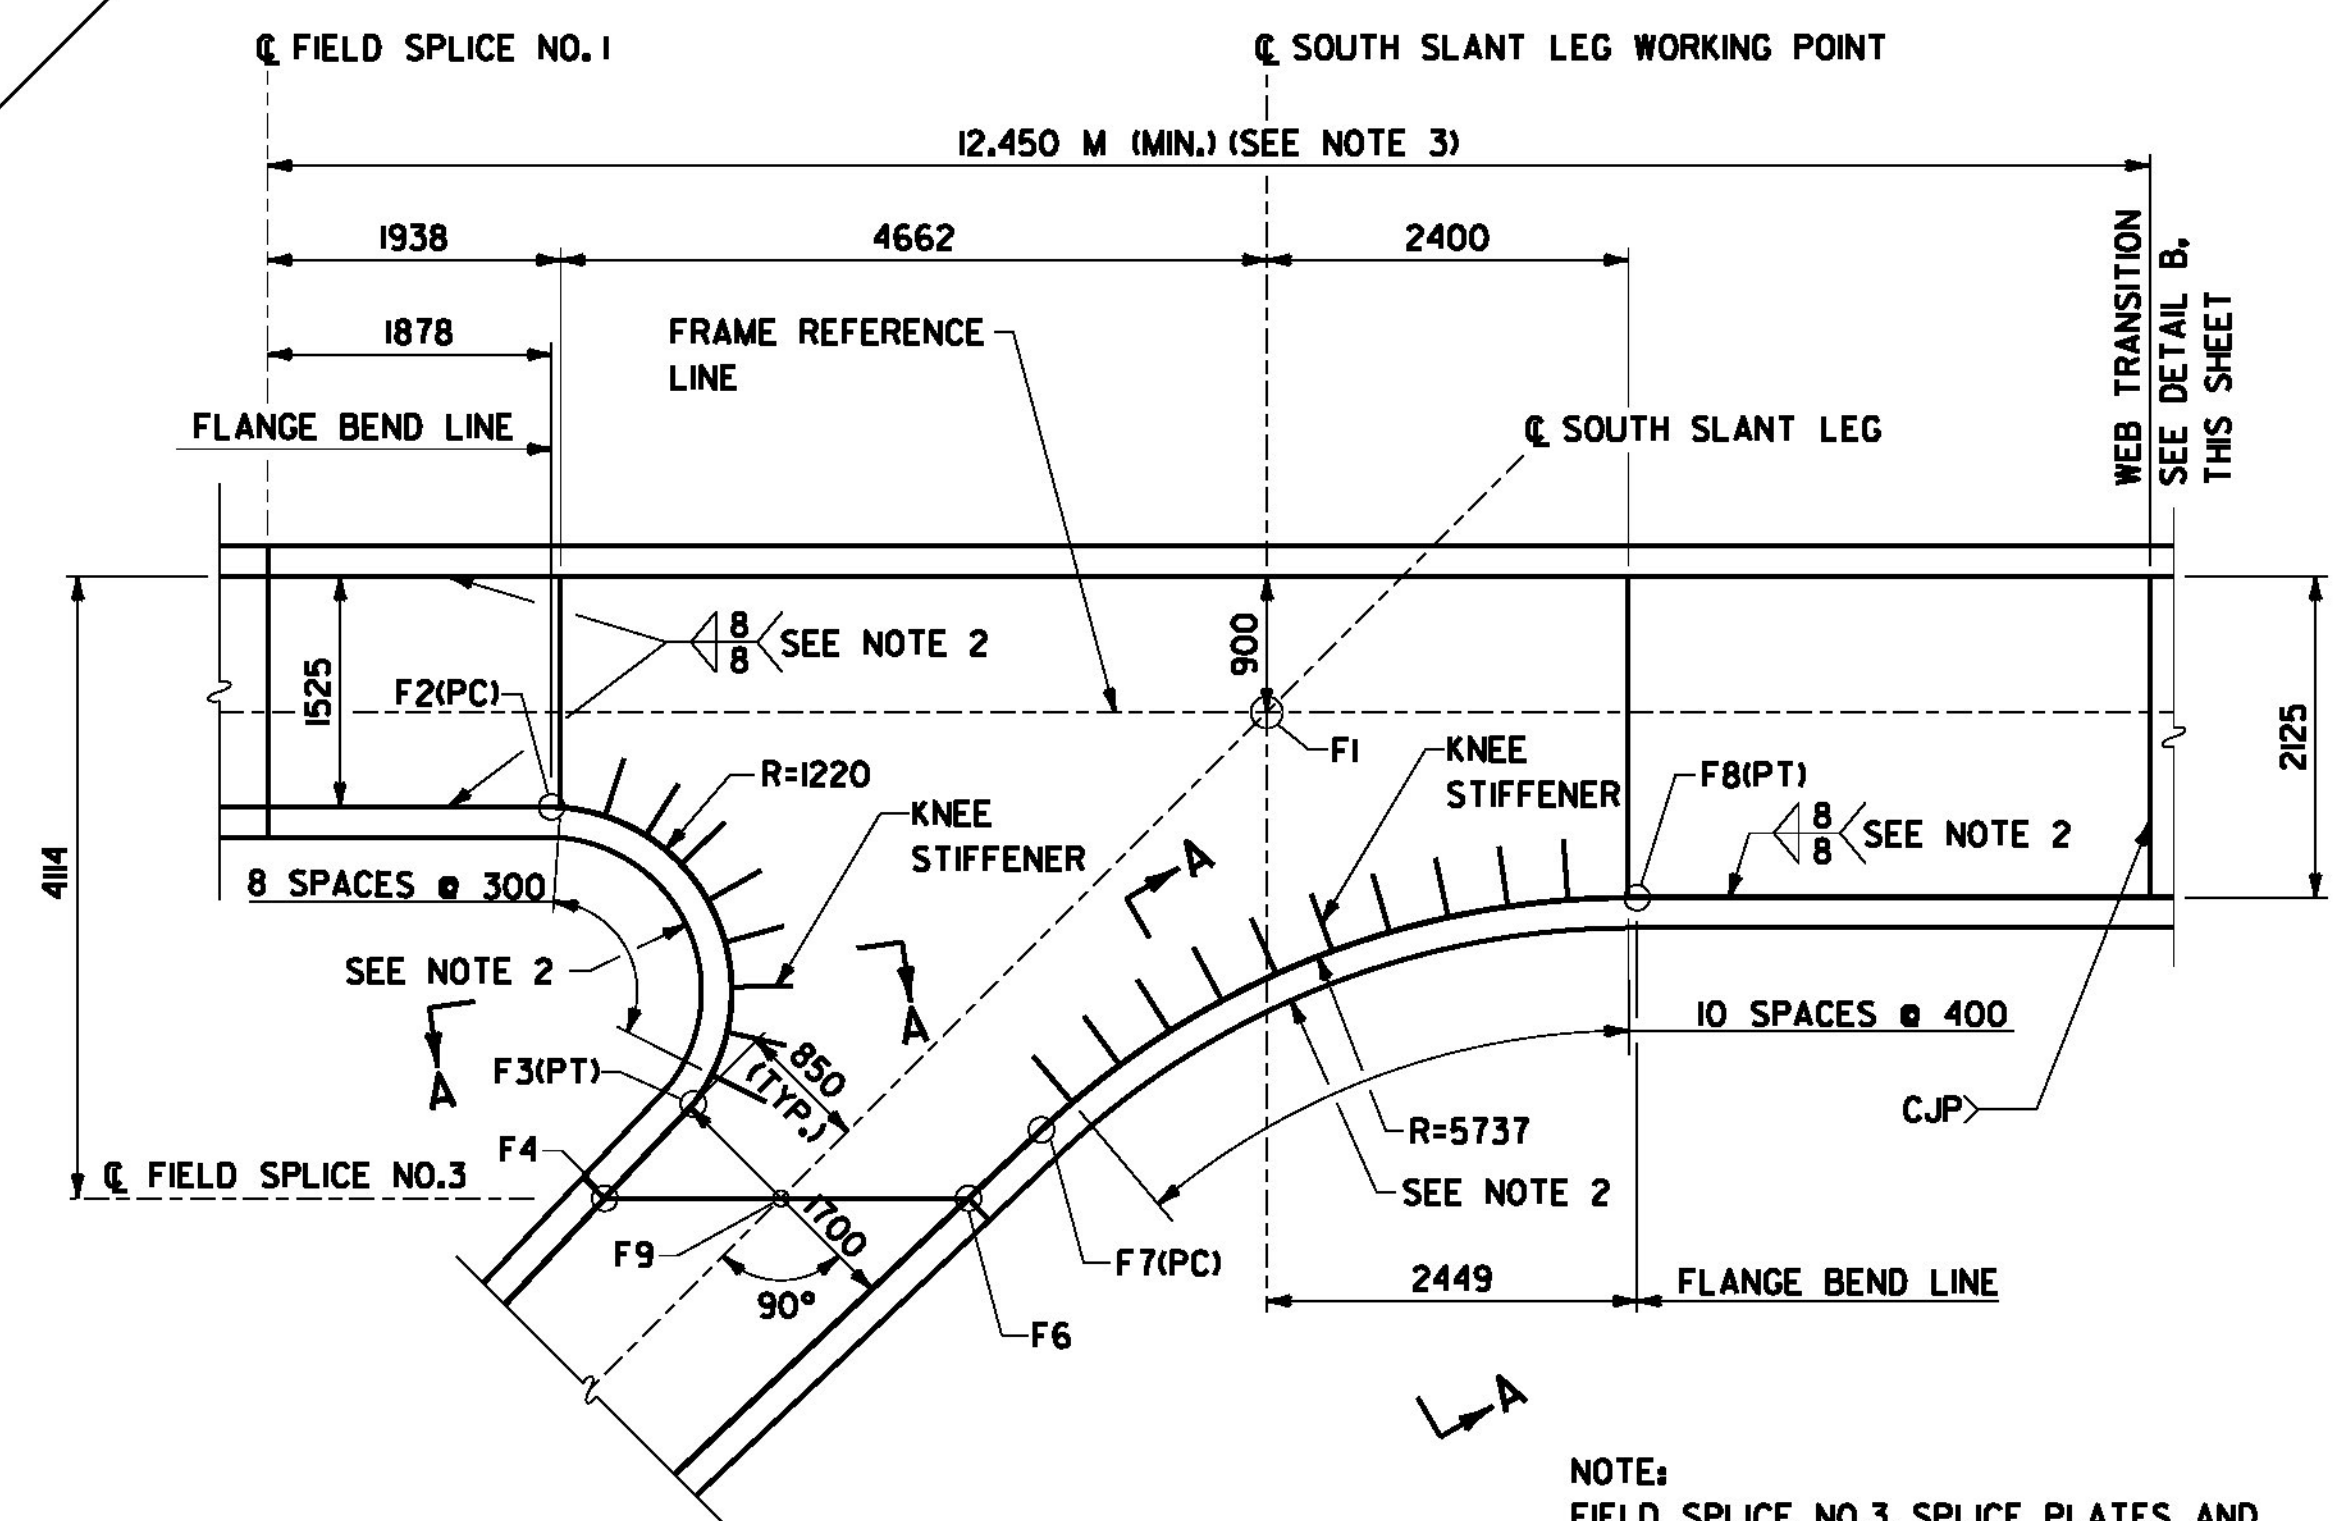

DETAIL A
SOUTH SLANT LEG SHOWN, NORTH SLANT LEG OPPOSITE HAND
SCALE: NOT TO SCALE

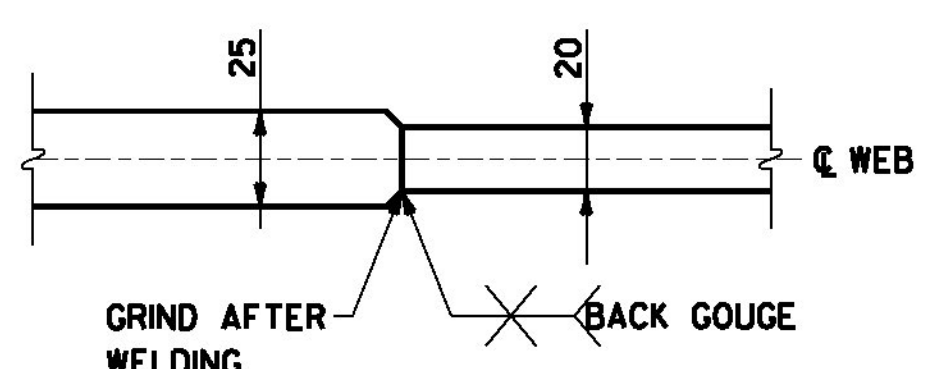


DETAIL B
NOT TO SCALE
WEB SPLICE DETAIL. LIMITS OF WEB PLATE SIZES INDICATED ON FRAME ELEVATION.

NOTES

1. ALL FRAME DIMENSIONS ARE HORIZONTAL AND ARE MEASURED ALONG FRAME REFERENCE LINE OR CENTERLINE SLANT LEG. ALL RADII ARE MEASURED ALONG OUTSIDE FACE OF FLANGE.
2. ULTRASONIC TESTING (UT) SHALL BE CONDUCTED ON ALL CURVED FLANGE ELEMENTS IN THE KNEE AREA. COST SHALL BE INCLUDED IN ITEM 900.635, SPECIAL PROVISION (HIGH PERFORMANCE STEEL, GRADE 485W).
3. COMPLETE JOINT PENETRATION (CJP) WEB WELDS NOT PERMITTED IN THIS LENGTH.
4. FOR SECTIONS A-A AND B-B, SEE SHEET 75.

NOTE: ALL DIMENSIONS IN MILLIMETERS (mm) EXCEPT WHERE NOTED.

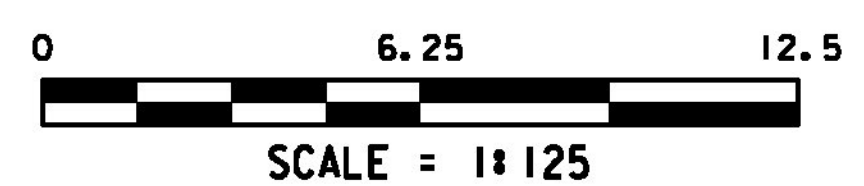

PROJECT NAME:	MORRISTOWN
PROJECT NUMBER:	STP F 029-1(2)C/1
FILE NAME:	zd082afe.dgn
PROJECT LEADER:	DMB
DESIGNED BY:	D. Kull
SLANT LEG FRAME ELEVATION (1 OF 2)	
PLOT DATE:	29-MAR-2012
DRAWN BY:	P. Dustin
CHECKED BY:	R. Joy
SHEET	74 OF 123