


**NOTES**

- 1. ALL DIMENSIONS MEASURED ALONG FRAME REFERENCE LINE UNLESS OTHERWISE NOTED.

NOTE: ALL DIMENSIONS IN MILLIMETERS (mm) EXCEPT WHERE NOTED.

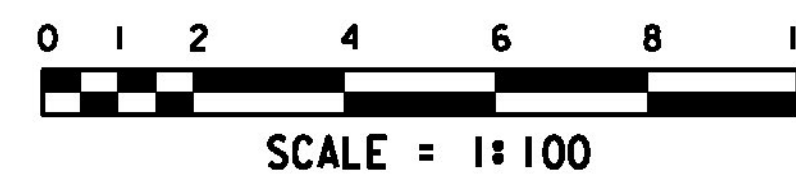

PROJECT NAME:	MORRISTOWN	PLOT DATE:	29-MAR-2012
PROJECT NUMBER:	STP F 029-1(2)C/1	DRAWN BY:	P. Dustin
FILE NAME:	z10b194ofg.dgn	CHECKED BY:	R. Joy
PROJECT LEADER:	DMB	SHEET	76 OF 123
DESIGNED BY:	D. Kull	SLANT LEG FRAME DETAILS	