


CAMBER DIAGRAM
NOT TO SCALE
INCLUDES SELF WEIGHT, SLAB AND CURBS

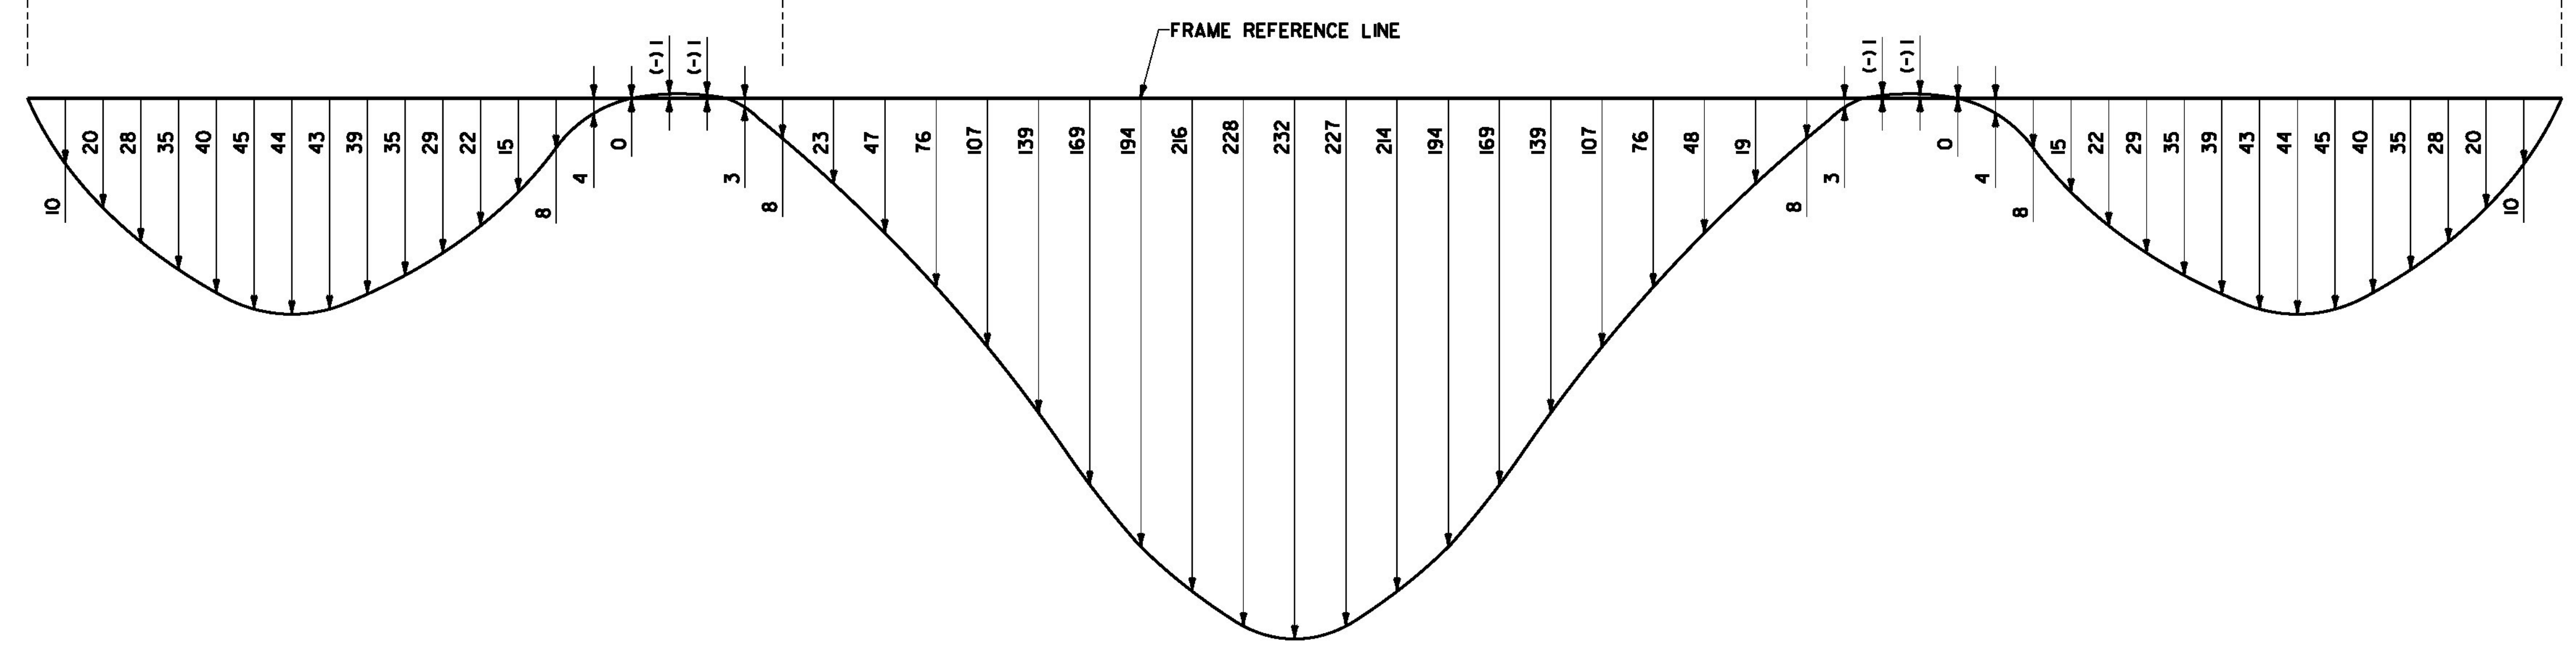

DEFLECTION DIAGRAM
NOT TO SCALE

NOTE: ALL DIMENSIONS IN MILLIMETERS (mm) EXCEPT WHERE NOTED.

PROJECT NAME:	MORRISTOWN	PLOT DATE:	29-MAR-2012
PROJECT NUMBER:	STP F 029-1(2)C/1	DRAWN BY:	P. Dustin
FILE NAME:	z10b194ofg.dgn	DESIGNED BY:	D. Kull
PROJECT LEADER:	DMB	CHECKED BY:	R. Joy
CAMBER DIAGRAM		SHEET	77 OF 123

