


NOTES

1. ALL SPLICE PLATES AND FILL PLATES TO BE AASHTO M270M GRADE 345W STEEL. ALL COSTS SHALL BE INCLUDED IN ITEM 506.55 STRUCTURAL STEEL - PLATE GIRDER.
2. ALL SPLICE AND FILL PLATES TO CONFORM TO THE CHARPY V NOTCH REQUIREMENTS.
3. ALL SPLICE CONNECTIONS SHALL BE MADE USING M22 DIAMETER, AASHTO M 164M, BOLTS IN 24 DIAMETER HOLES.
4. EXCLUDE BOLT THREADS FROM SHEAR PLANES.

NOTE: ALL DIMENSIONS IN MILLIMETERS (mm) EXCEPT WHERE NOTED.

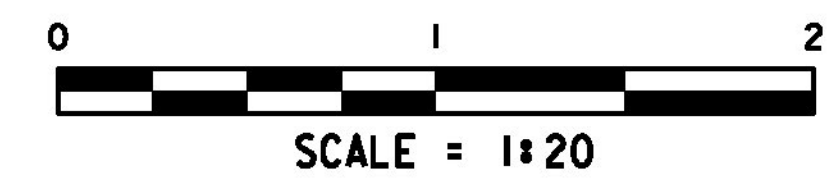

PROJECT NAME:	MORRISTOWN
PROJECT NUMBER:	STP F 029-1(2)C/1
FILE NAME:	z10b194afs.dgn
PROJECT LEADER:	DMB
DESIGNED BY:	D. Kull
FIELD SPLICE DETAILS - 1	
PLOT DATE:	29-MAR-2012
DRAWN BY:	D. Kull
CHECKED BY:	R. Joy
SHEET	78 OF 123