



WEB ELEVATION
SCALE: 1:10

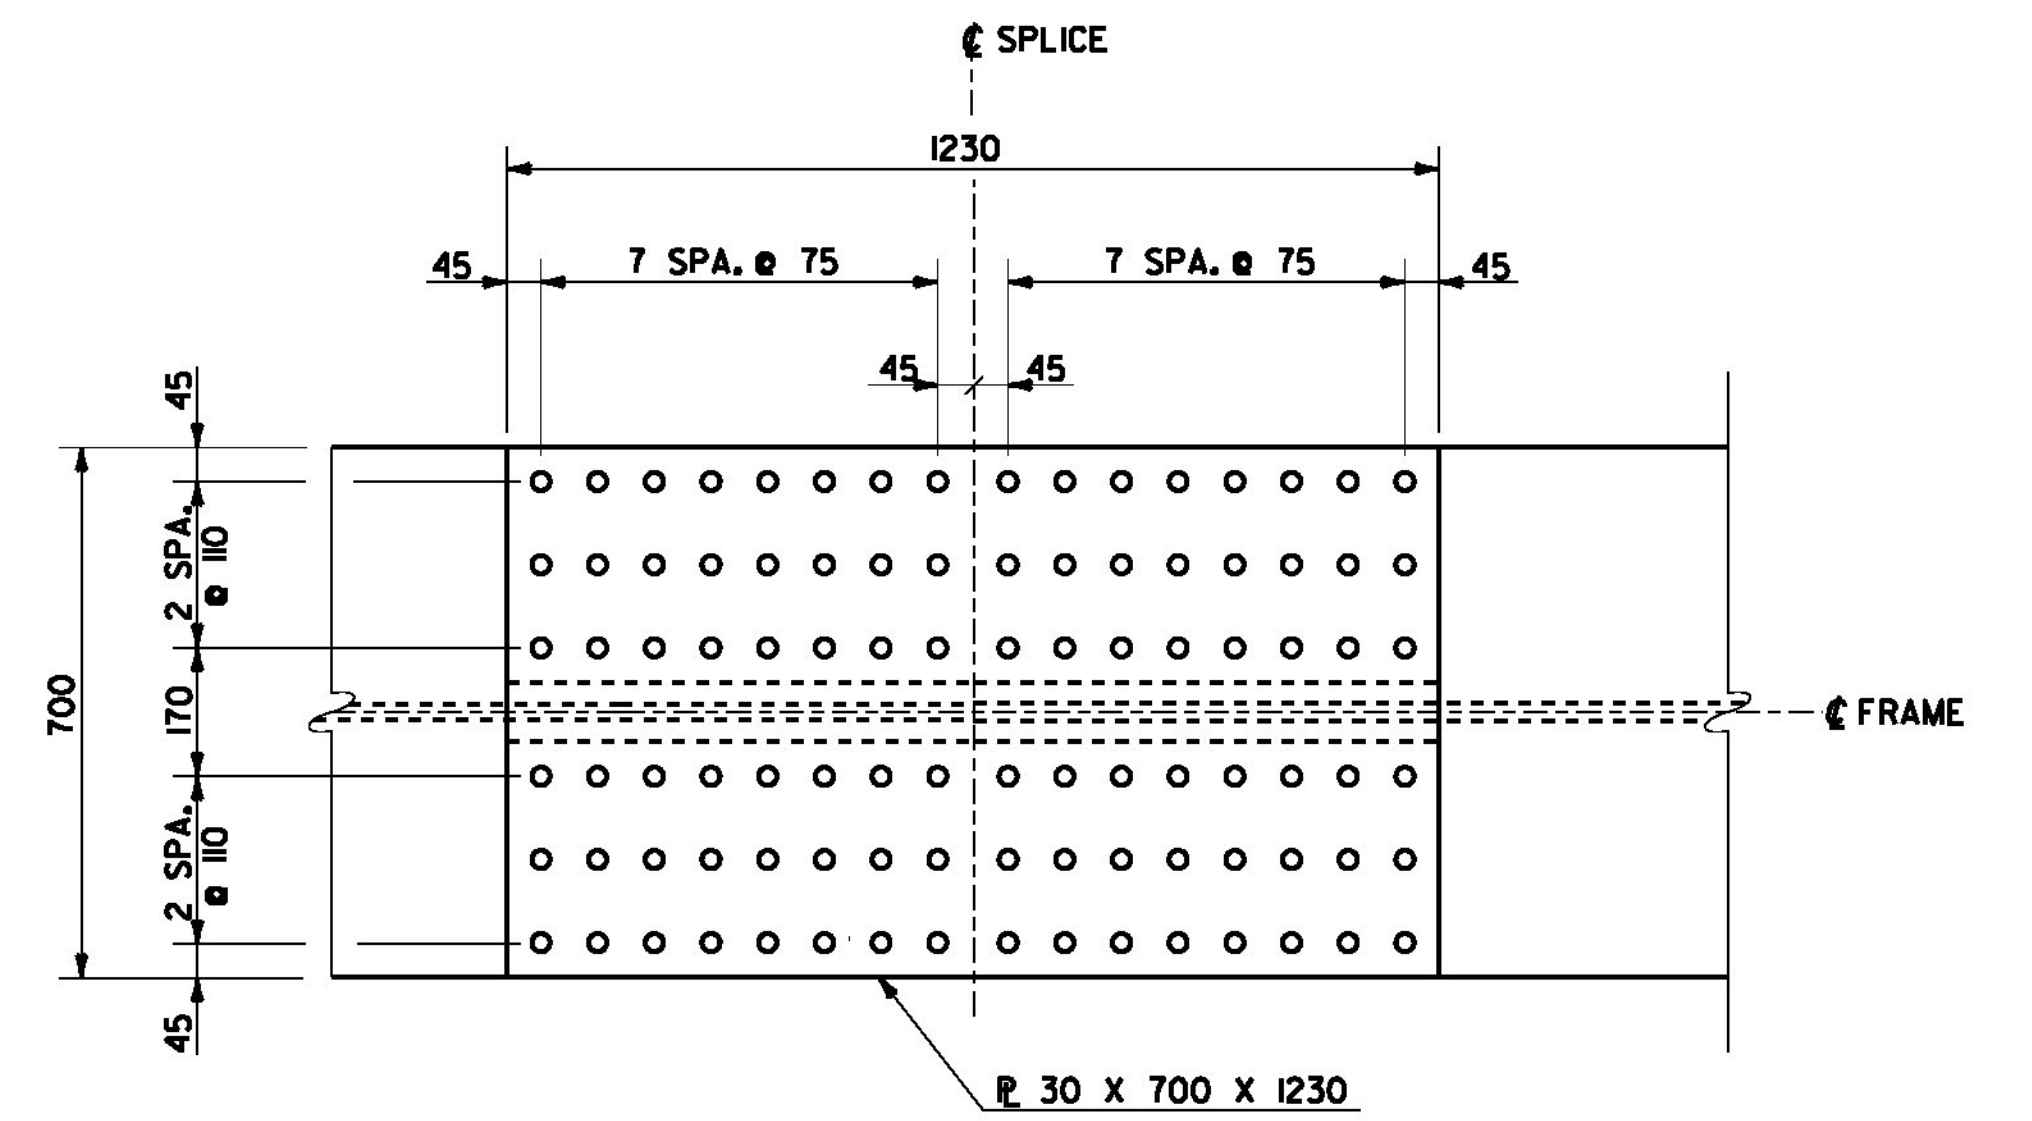

TOP FLANGE
SCALE: 1:10

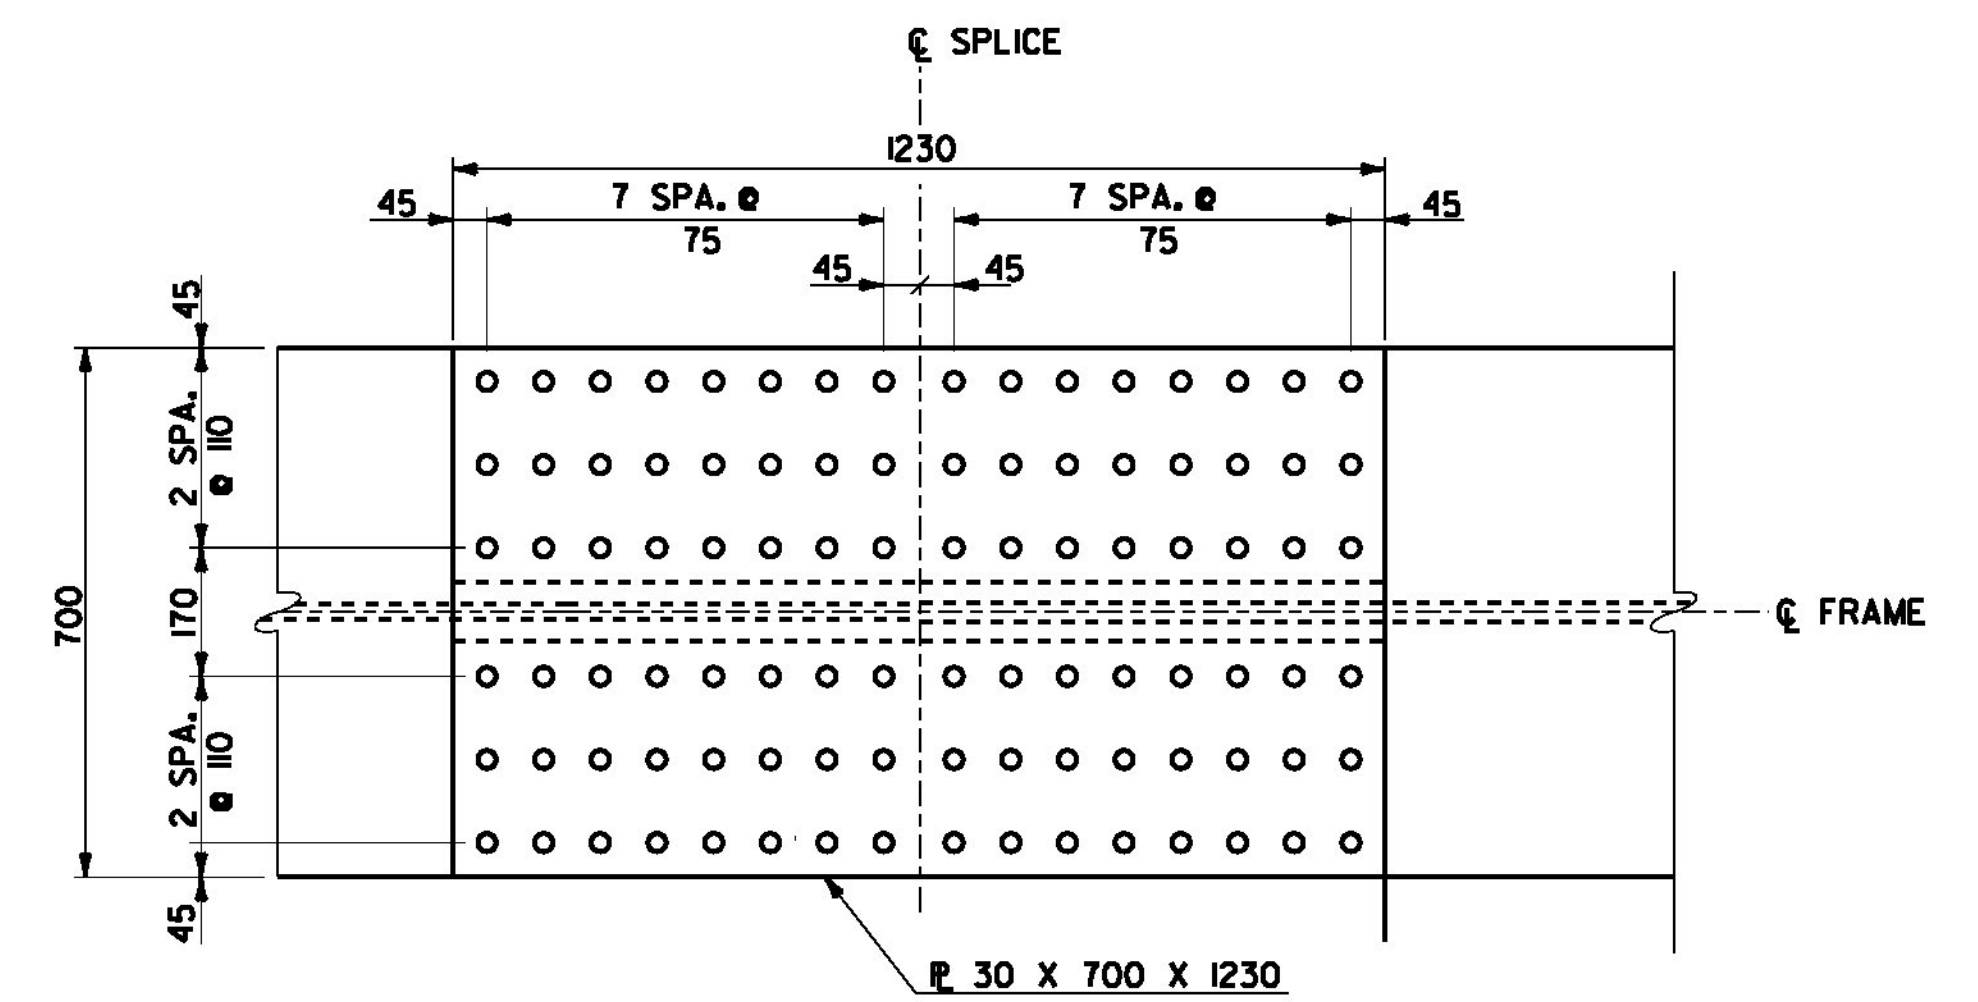


BOTTOM FLANGE PLAN
SCALE: 1:10

FIELD SPLICE NO. 3

NOTE

I. FOR FIELD SPLICE NOTES, SEE SHEET 78.

NOTE: ALL DIMENSIONS IN MILLIMETERS (mm) EXCEPT WHERE NOTED.

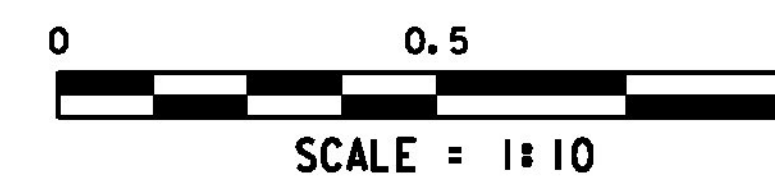

PROJECT NAME:	MORRISTOWN	PLOT DATE:	29-MAR-2012
PROJECT NUMBER:	STP F 029-1(2)C/1	DRAWN BY:	D. Kull
FILE NAME:	z10b194afs.dgn	CHECKED BY:	R. Joy
PROJECT LEADER:	DMB	FIELD SPLICE DETAILS - 2	SHEET 79 OF 123
DESIGNED BY:	D. Kull		