



SECTION D-D (TYPICAL SECTION AT ARMORED BRUSH CURB)  
SCALE: 1:5

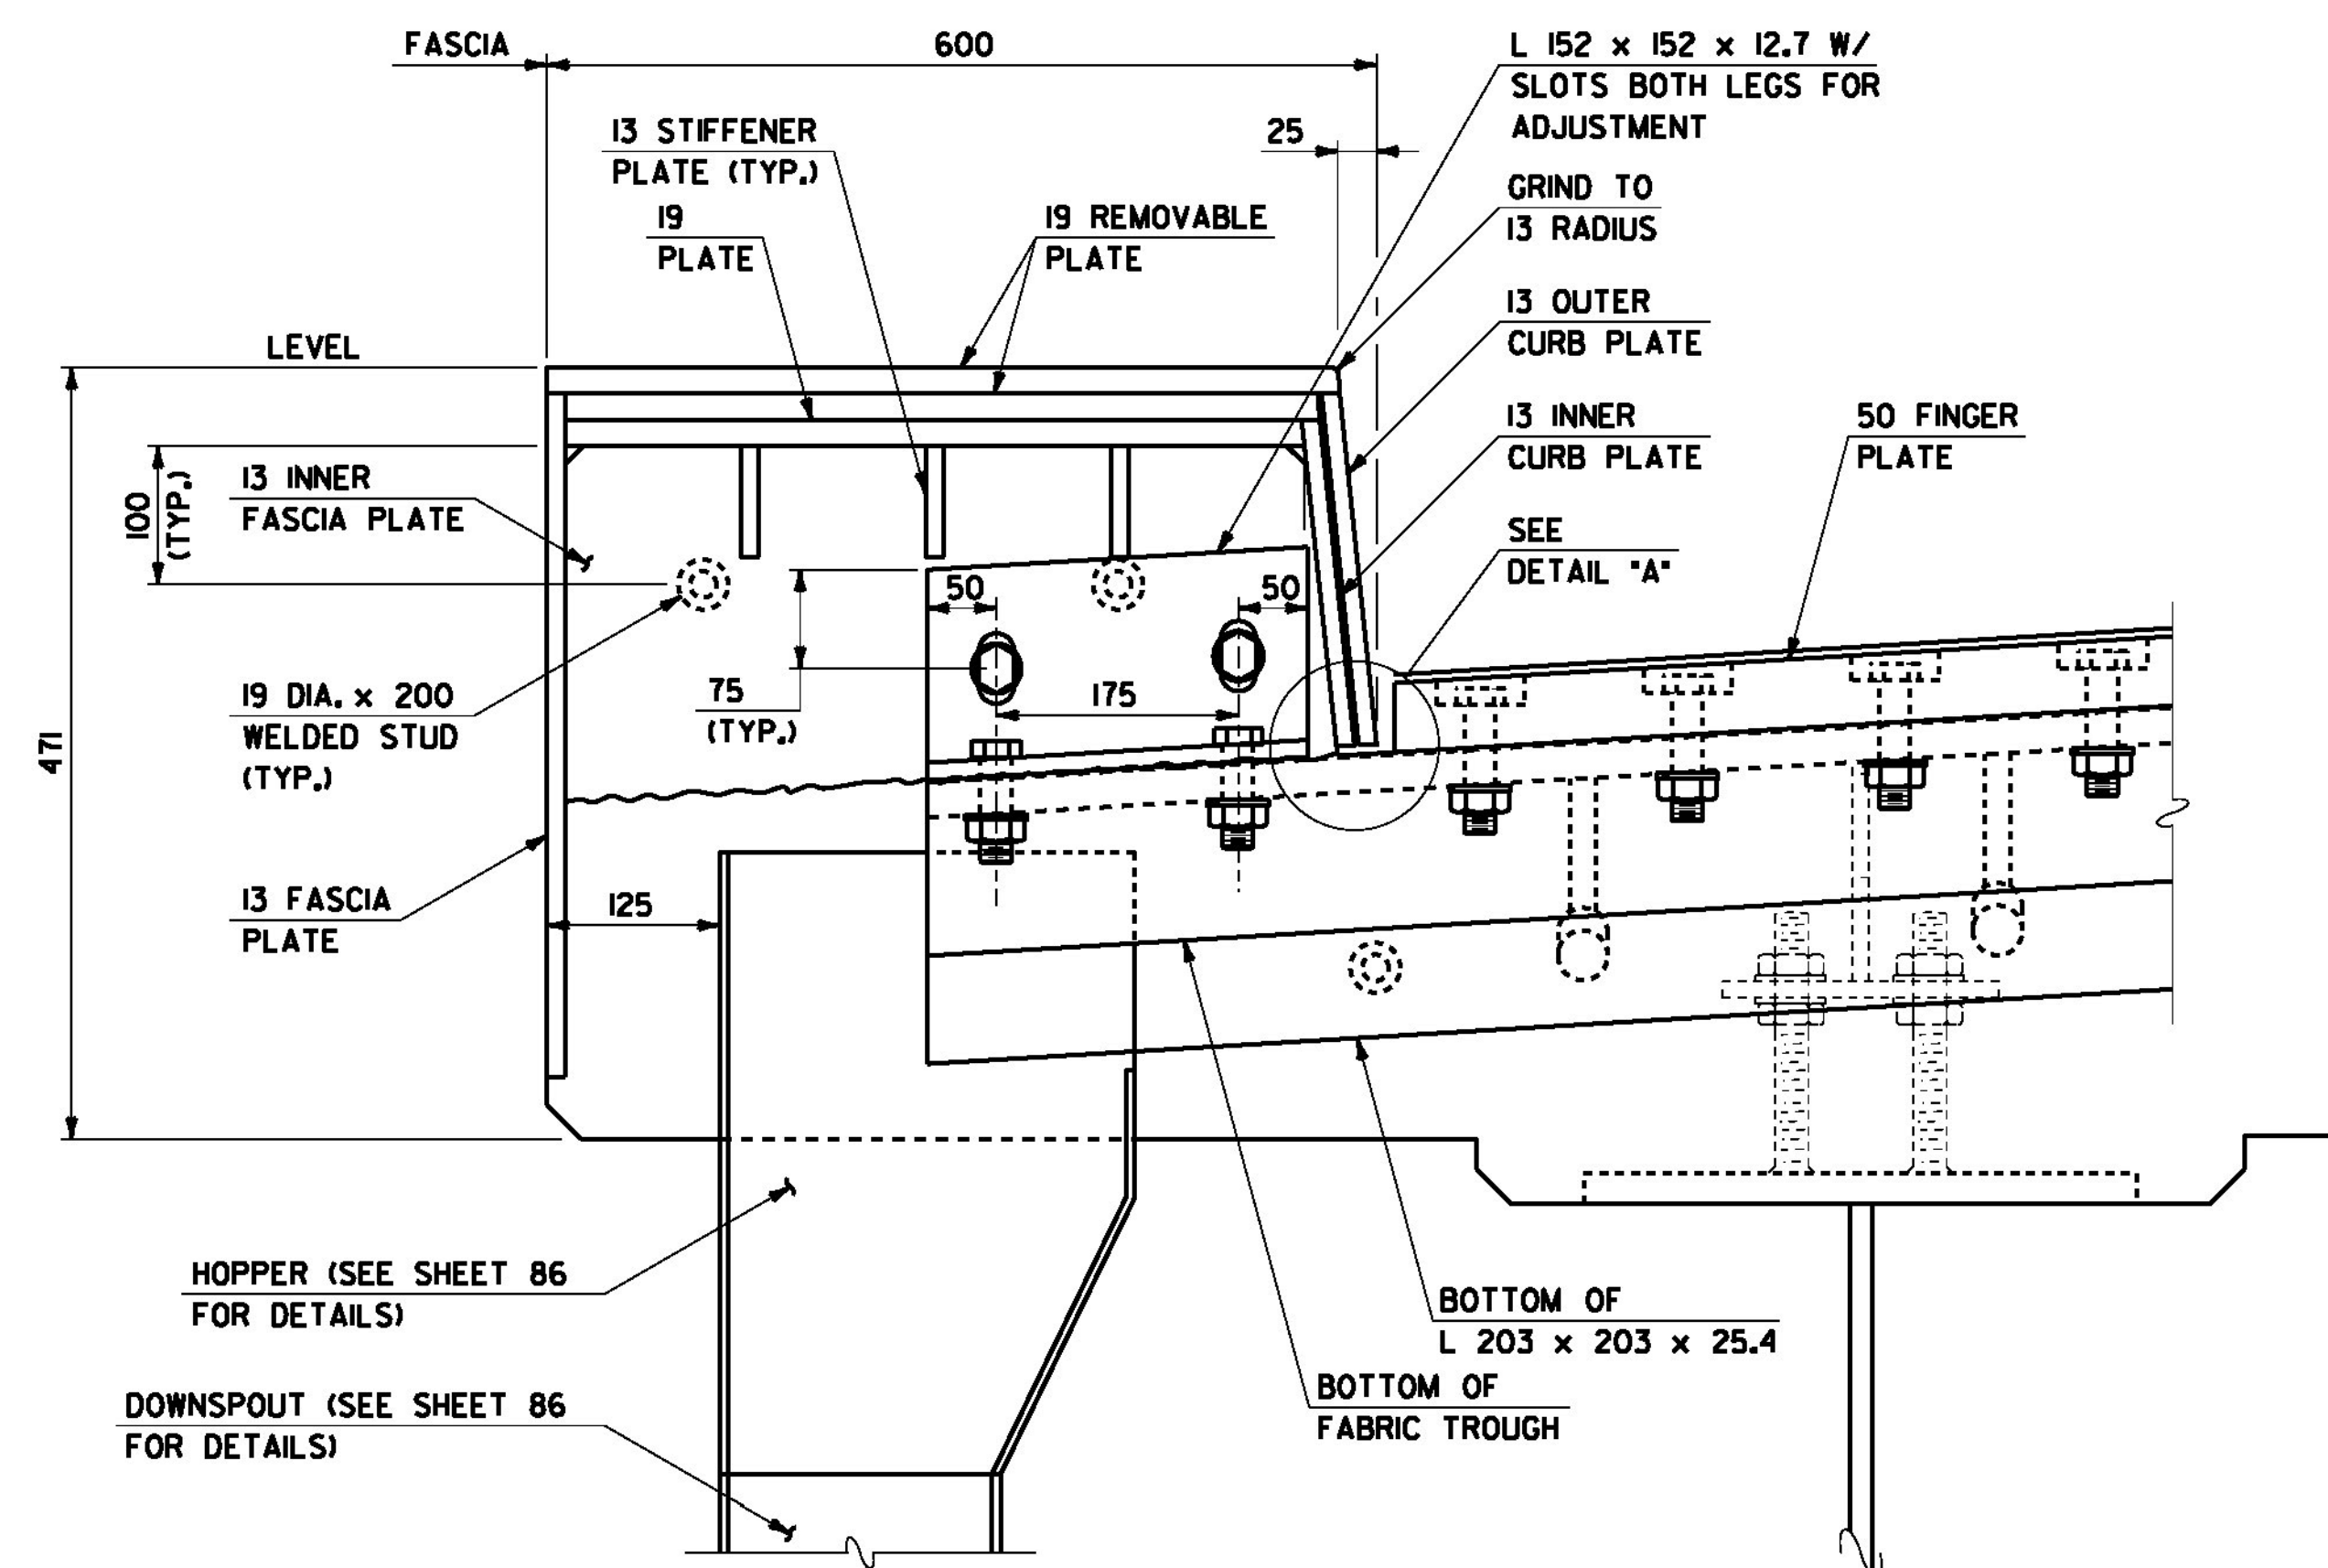

SECTION C-C  
SCALE: 1:5

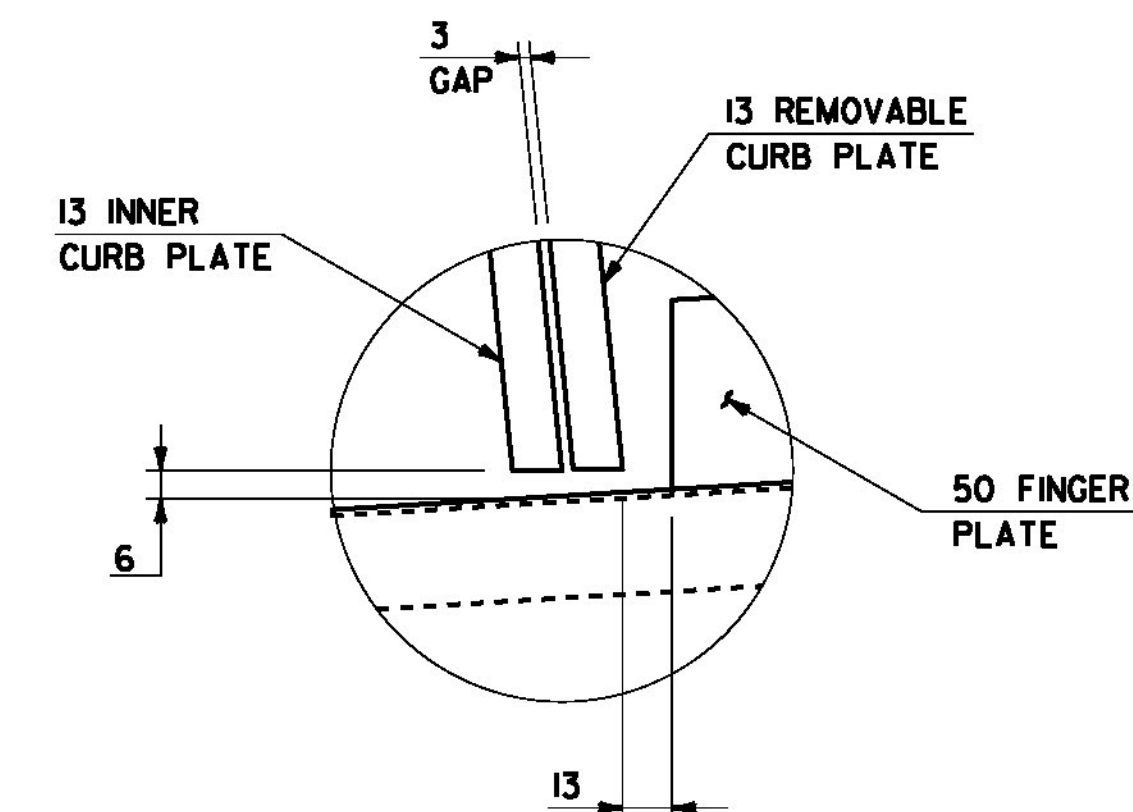

DETAIL "A"  
SCALE: 1:2

NOTE

1. FOR ADDITIONAL EXPANSION JOINT NOTES, SEE SHEET 4.

NOTE: ALL DIMENSIONS IN MILLIMETERS (mm) EXCEPT WHERE NOTED.

PROJECT NAME: MORRISTOWN  
PROJECT NUMBER: STP F 029-1(2)C/1

FILE NAME: z10b1940j3.DGN PLOT DATE: 29-MAR-2012  
PROJECT LEADER: DMB DRAWN BY: P. Dustin  
DESIGNED BY: S. Della CHECKED BY: R. Joy  
FINGER JOINT DETAILS - 3 SHEET 85 OF 123

