



APPROACH SLAB NO. 1 PLAN

SCALE: 1:50

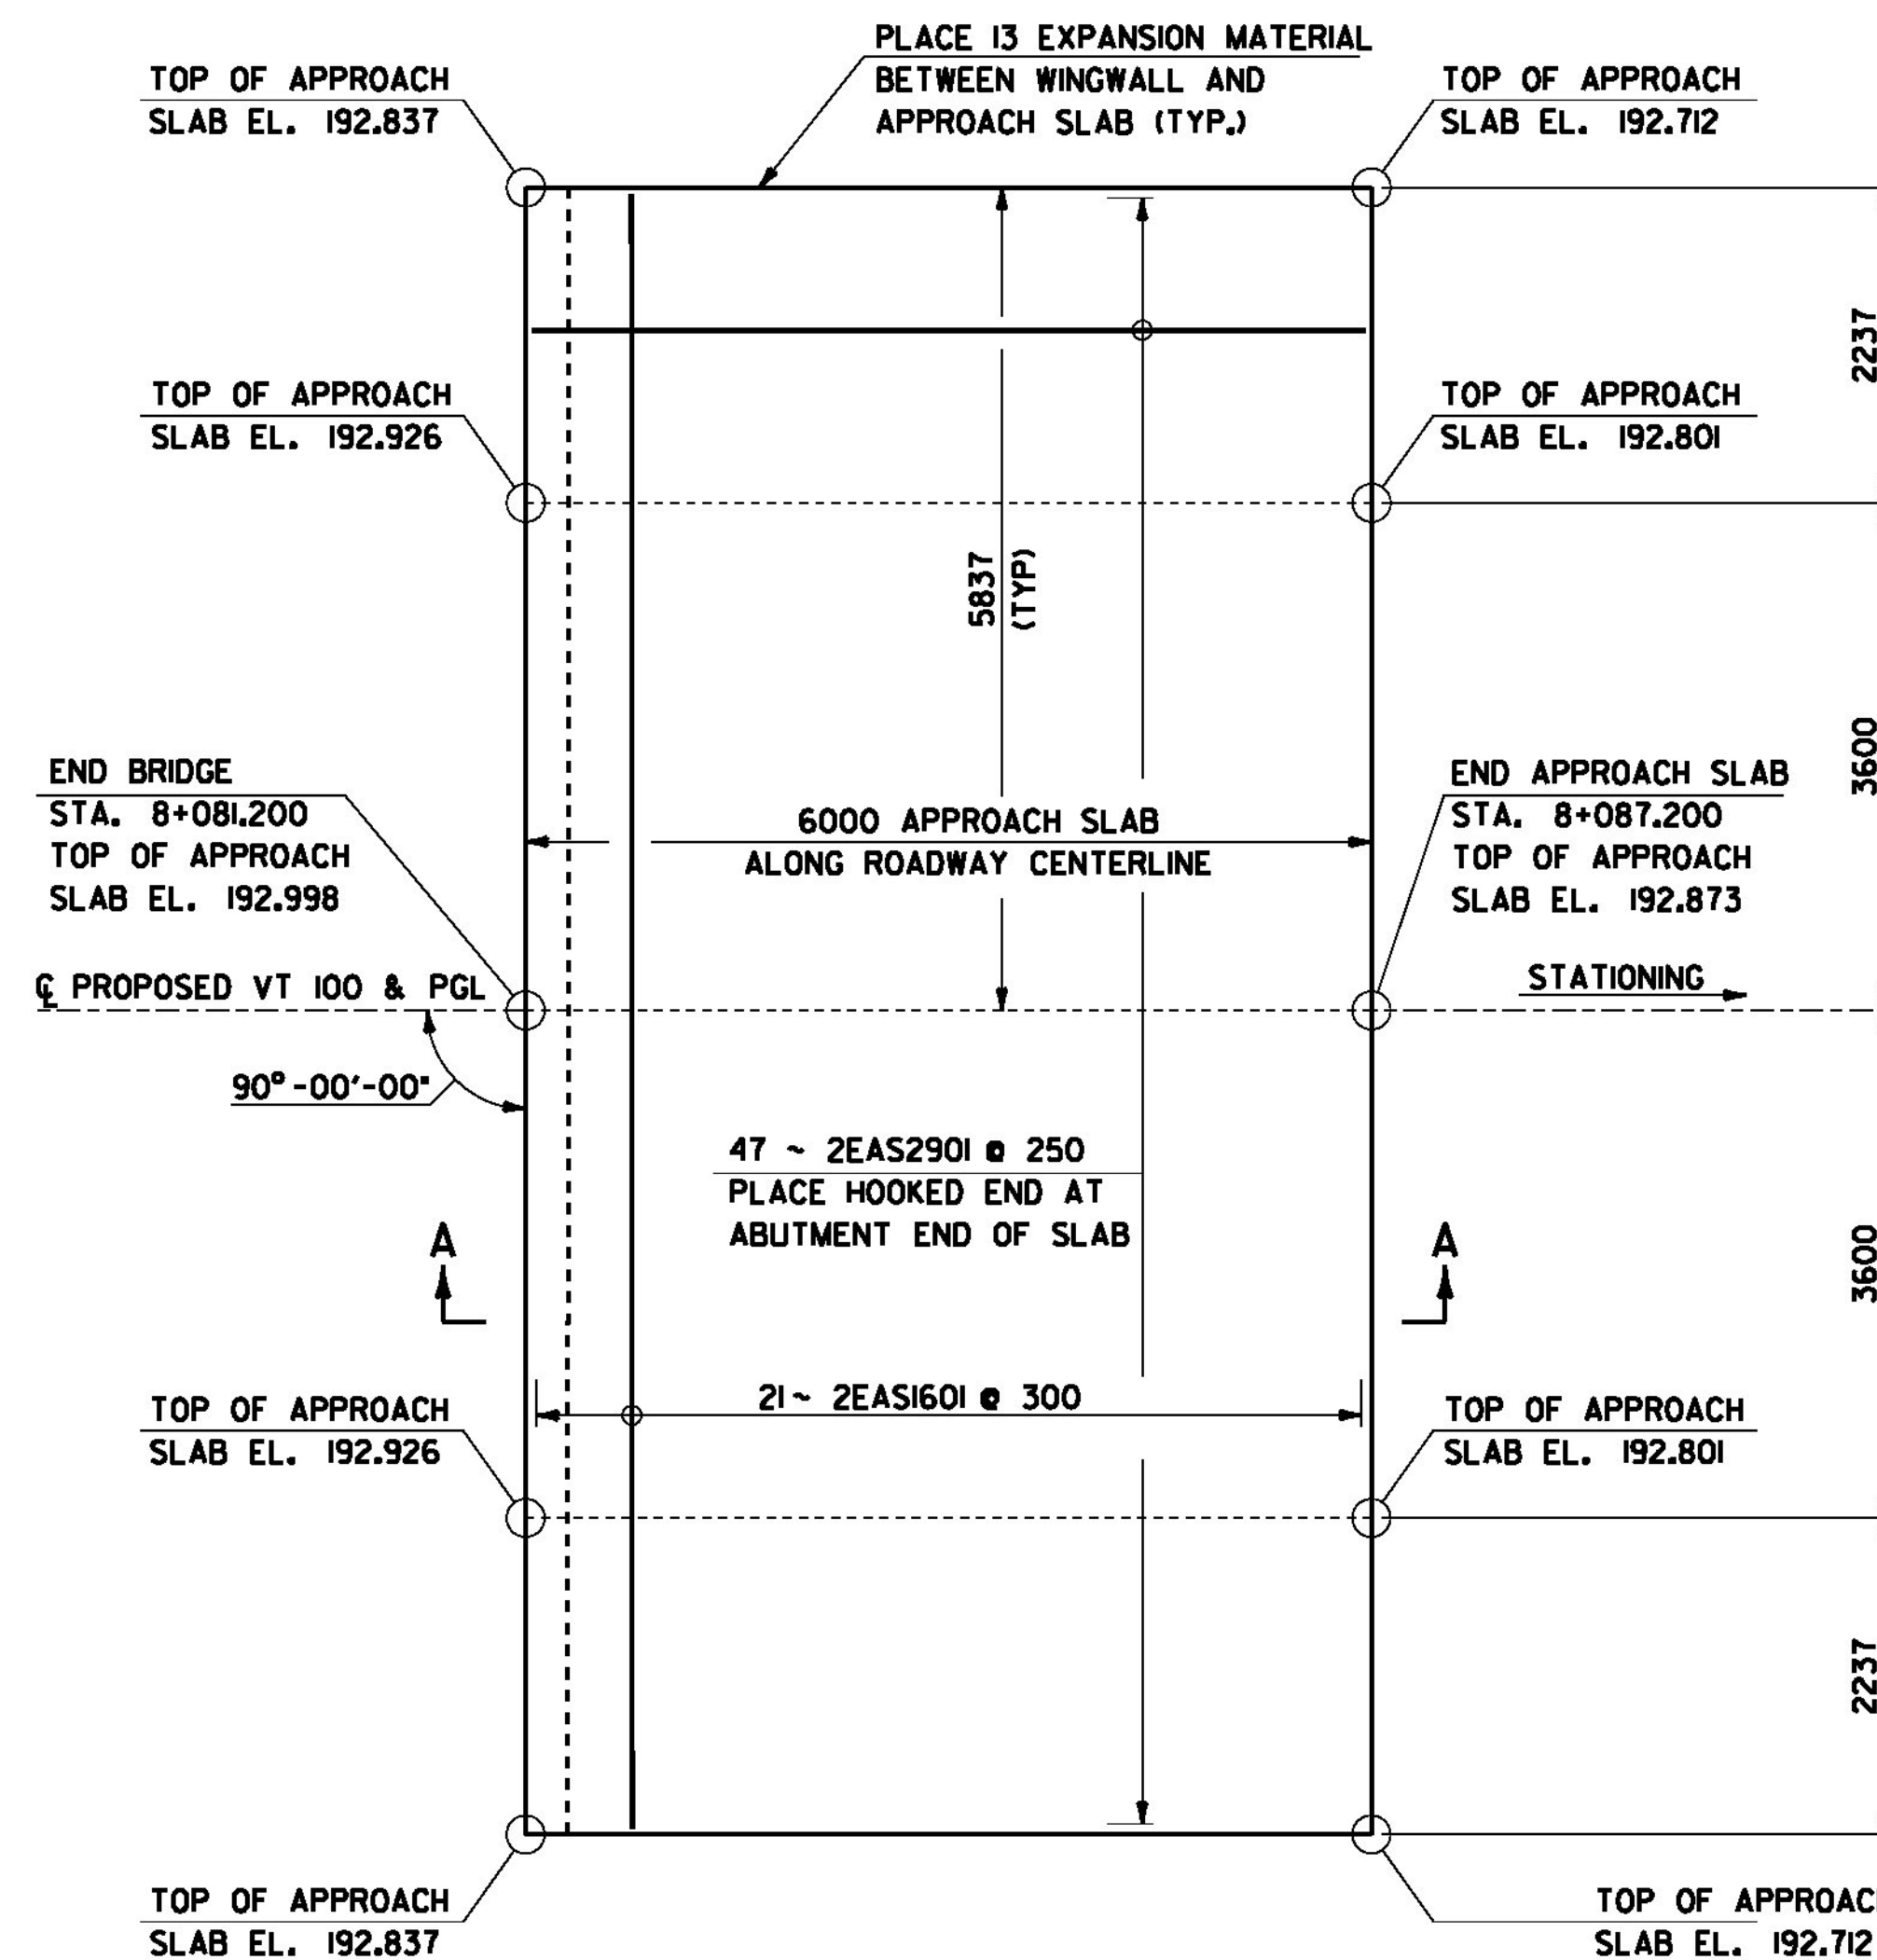


APPROACH SLAB NO. 2 PLAN

SCALE: 1:50

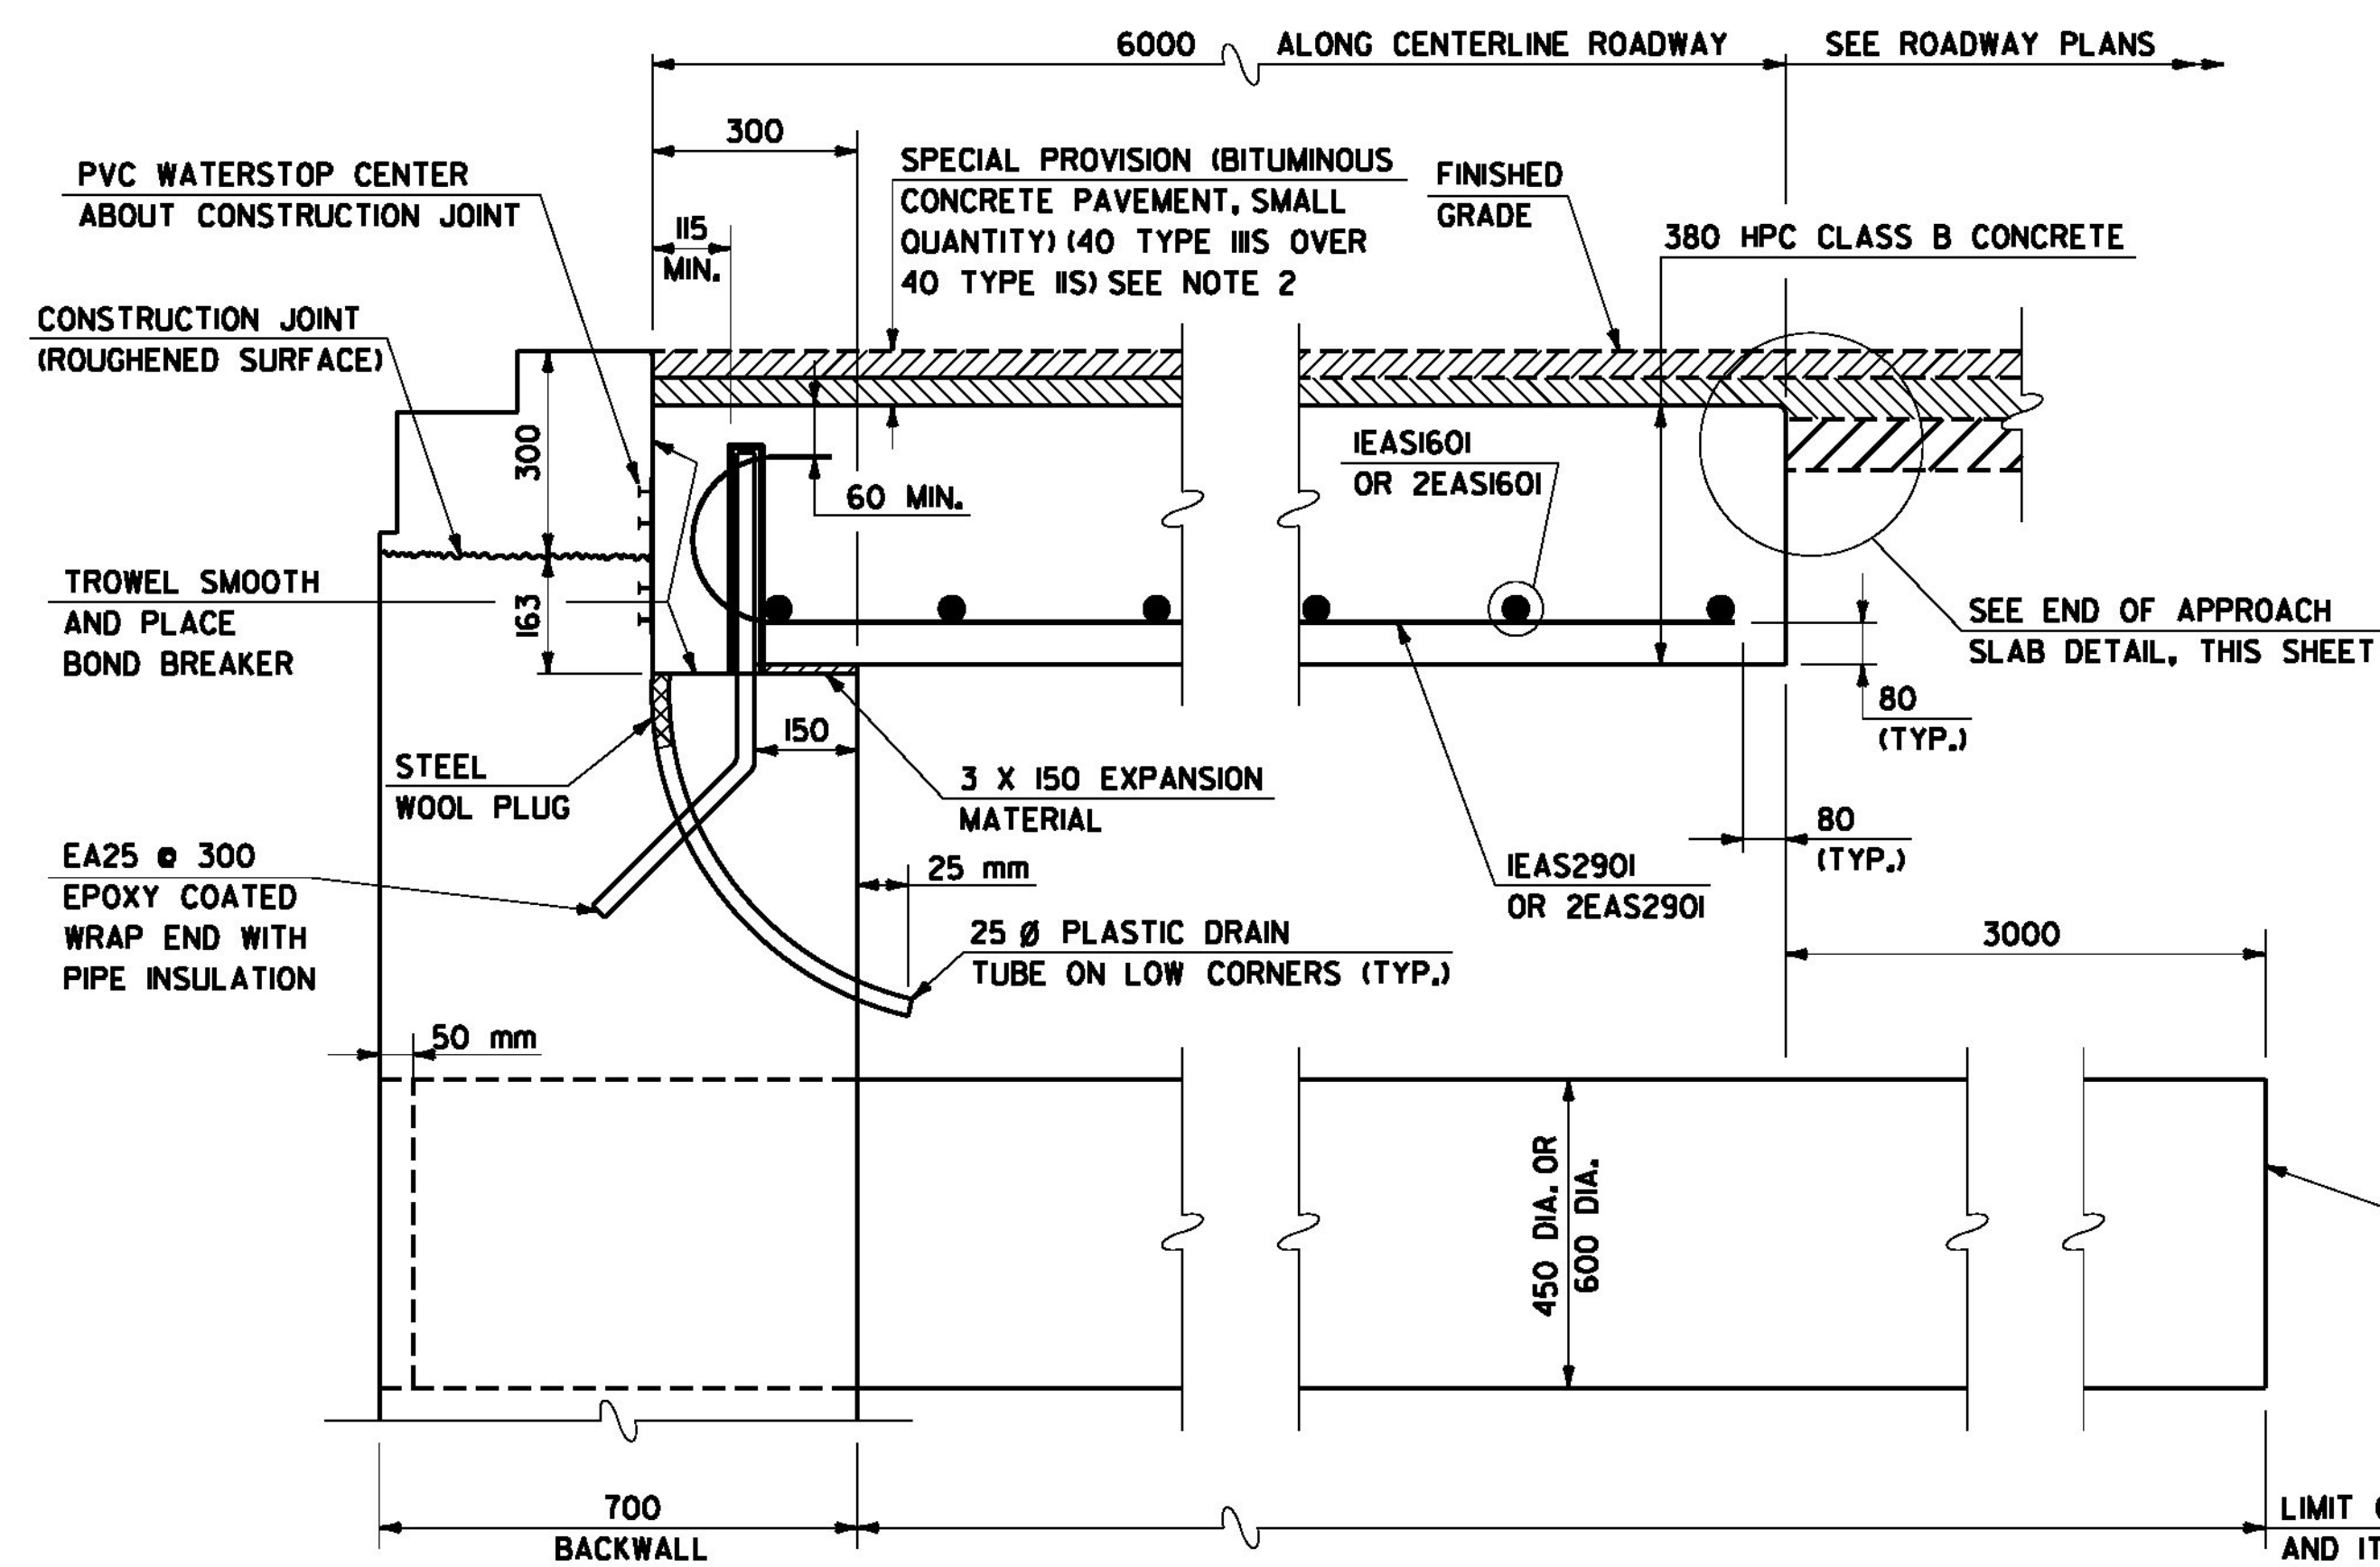

SECTION A-A

SCALE: 1:10

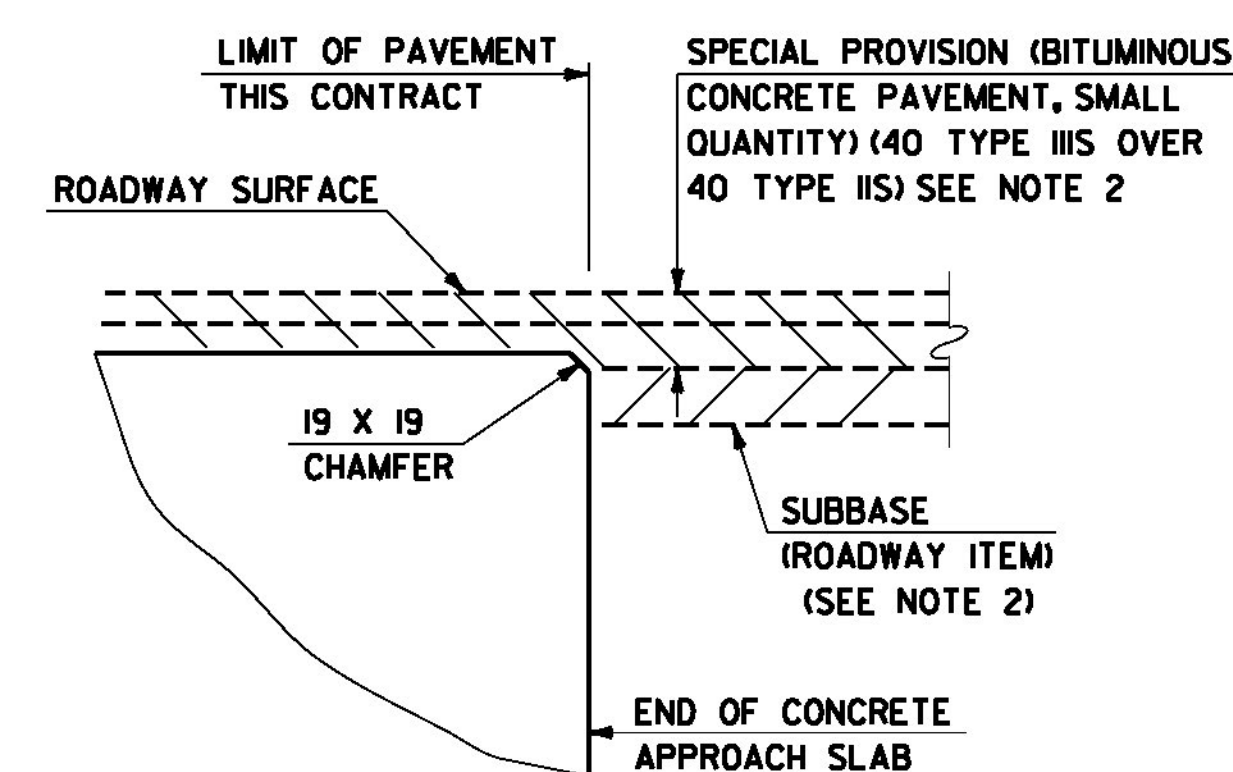


END OF APPROACH SLAB DETAIL


NOT TO SCALE

NOTES

1. REINFORCING STEEL COVER SHALL BE 80 CLR, UNLESS OTHERWISE SPECIFIED.
2. SECOND LIFT OF BITUMINOUS CONCRETE PAVEMENT TYPE IIS, SUBBASE AND ROADWAY BITUMINOUS PAVEMENT IS NOT INCLUDED IN THIS CONTRACT.

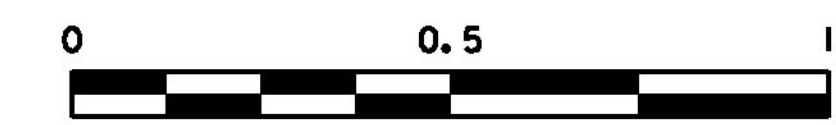

SCALE = 1:10

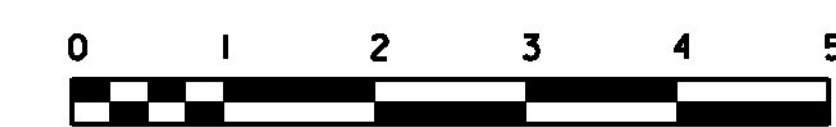

SCALE = 1:50

NOTE: ALL DIMENSIONS IN MILLIMETERS (mm) EXCEPT WHERE NOTED.

PROJECT NAME: MORRISTOWN
PROJECT NUMBER: STP F 029-1(2)C/1

FILE NAME: z10b194aas.dgn PLOT DATE: 29-MAR-2012
PROJECT LEADER: DMB DRAWN BY: S. Merkwon
DESIGNED BY: D. Kull CHECKED BY: R. Joy
APPROACH SLAB DETAILS SHEET 87 OF 123