



WINGWALL NOS. 1 & 2 ELEVATION

SCALE: 1:40
NOTE: OUTSIDE (NEAR) FACE OF WINGWALL SHOWN. APPROACH SLAB RAIL NOT SHOWN FOR CLARITY. PILES NOT SHOWN FOR CLARITY.

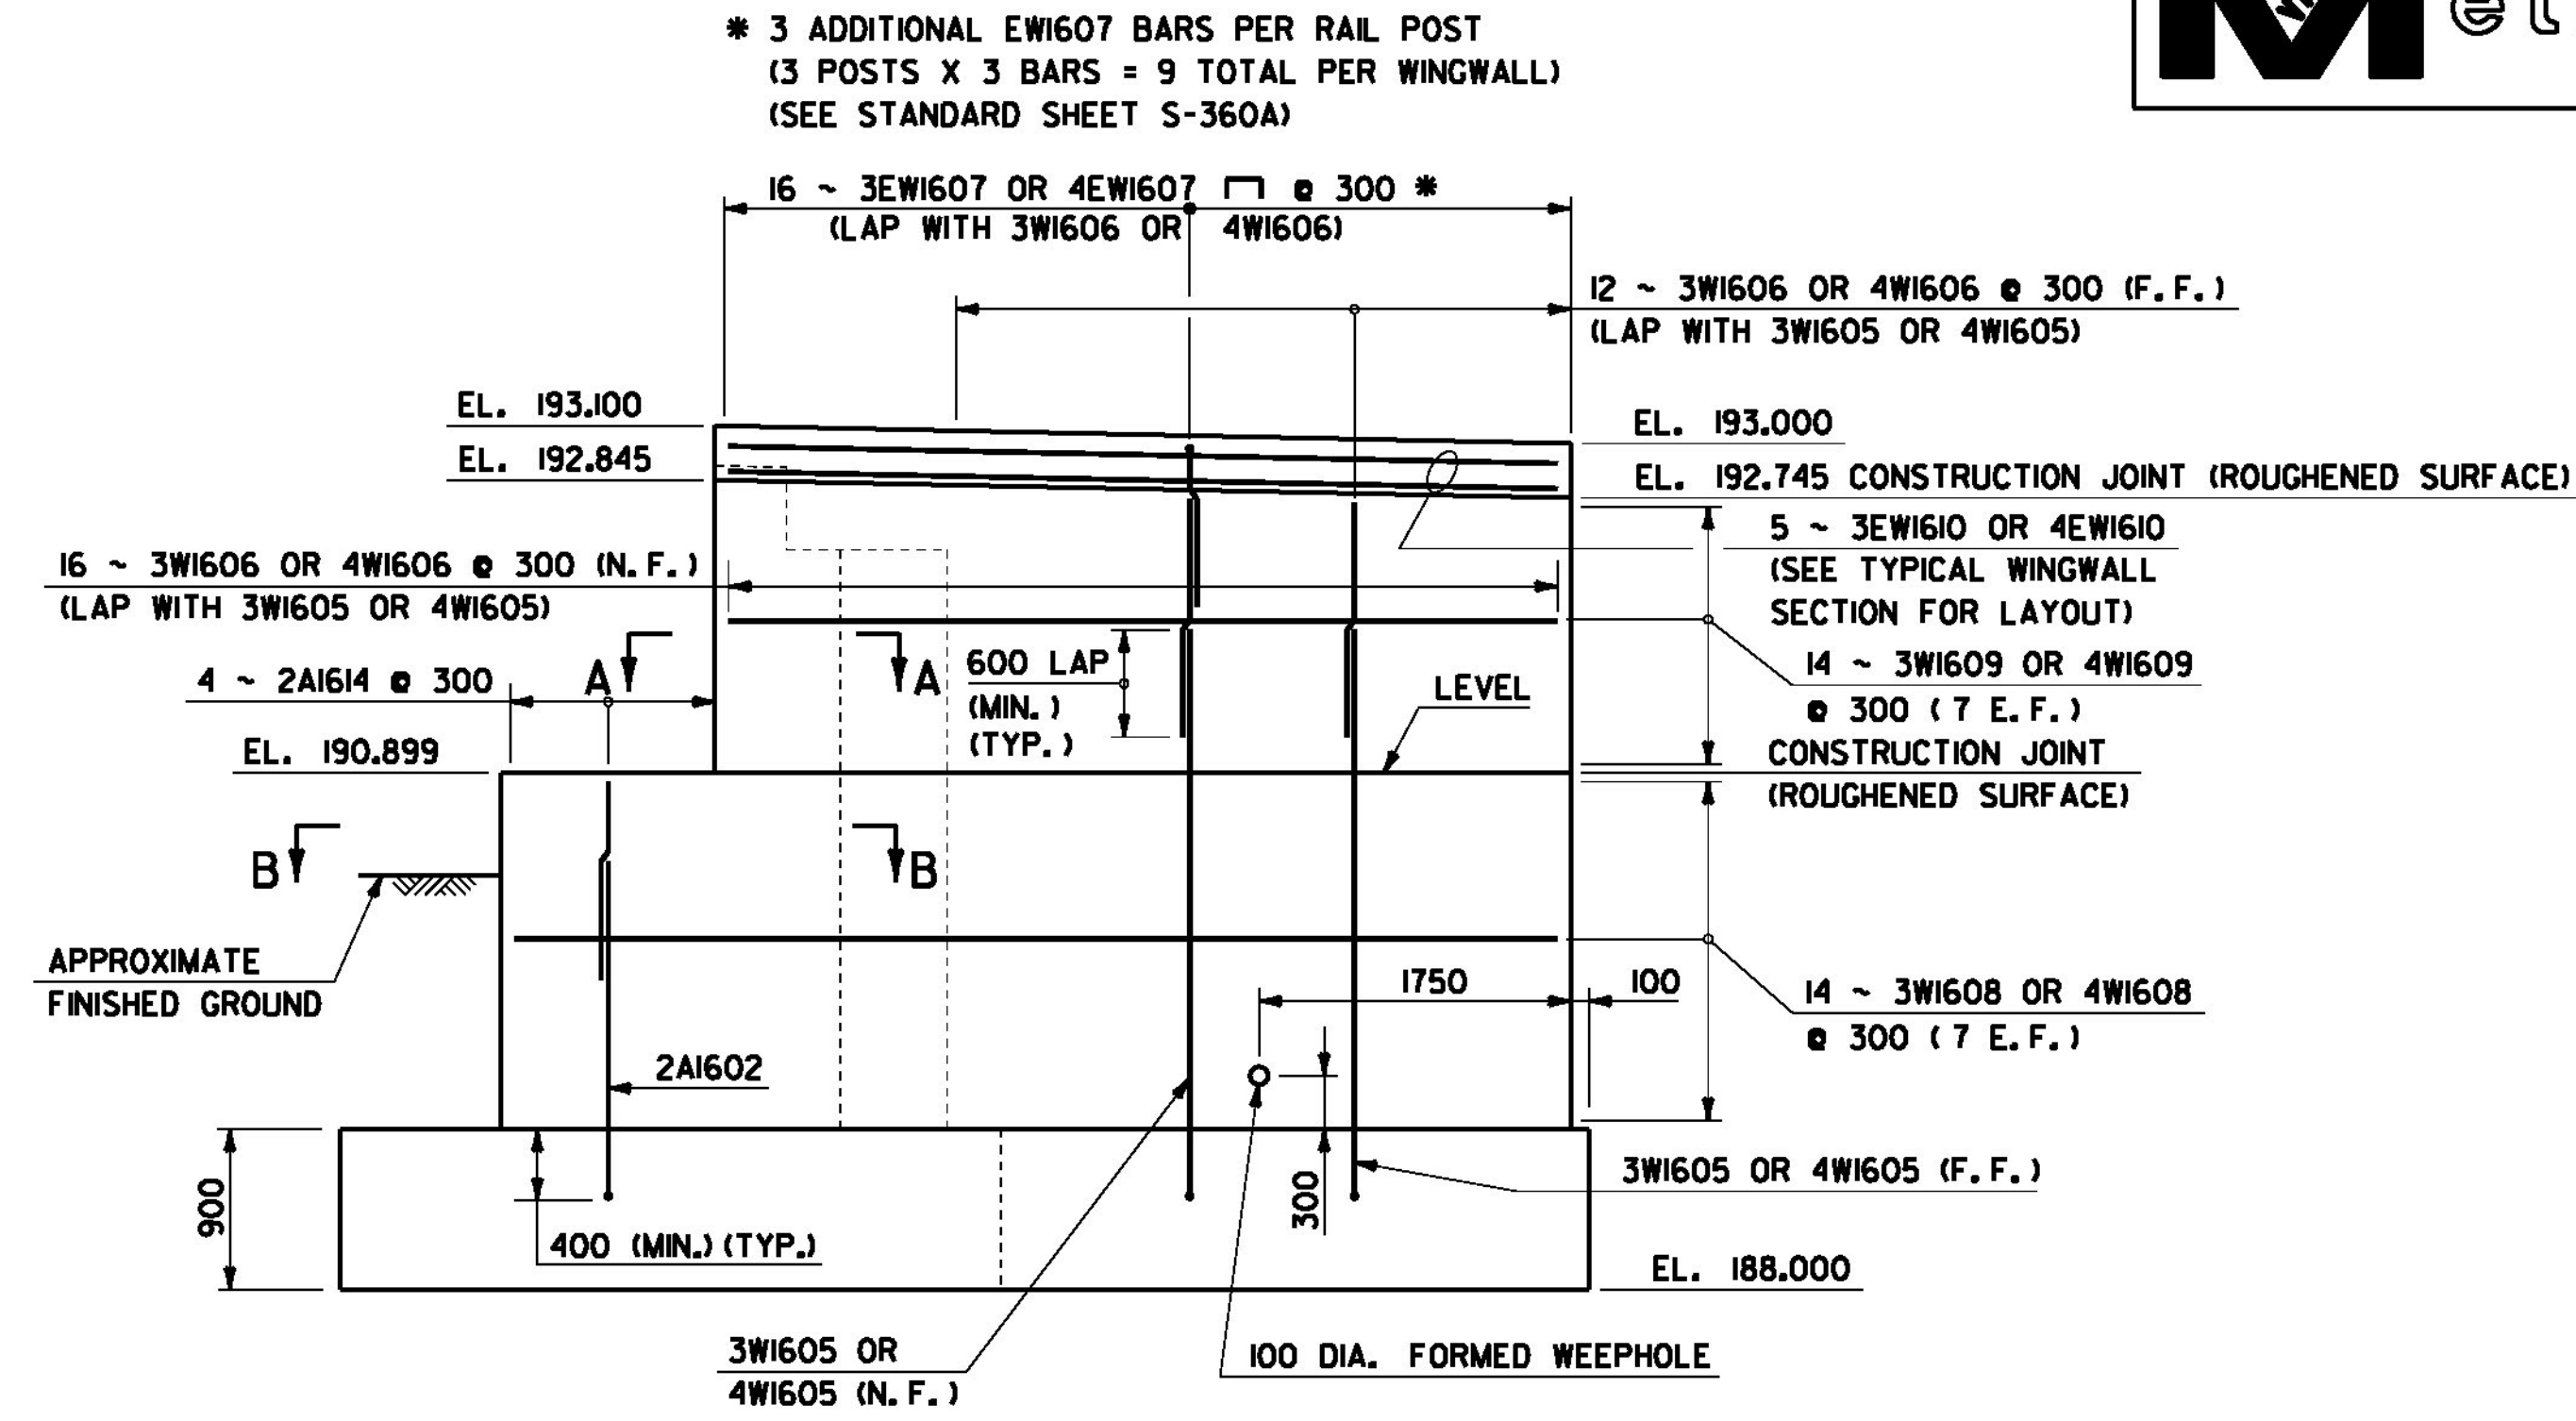


WINGWALL NOS. 3 & 4 ELEVATION

SCALE: 1:40
NOTE: OUTSIDE (NEAR) FACE OF WINGWALL SHOWN. APPROACH SLAB RAIL NOT SHOWN FOR CLARITY. PILES NOT SHOWN FOR CLARITY.

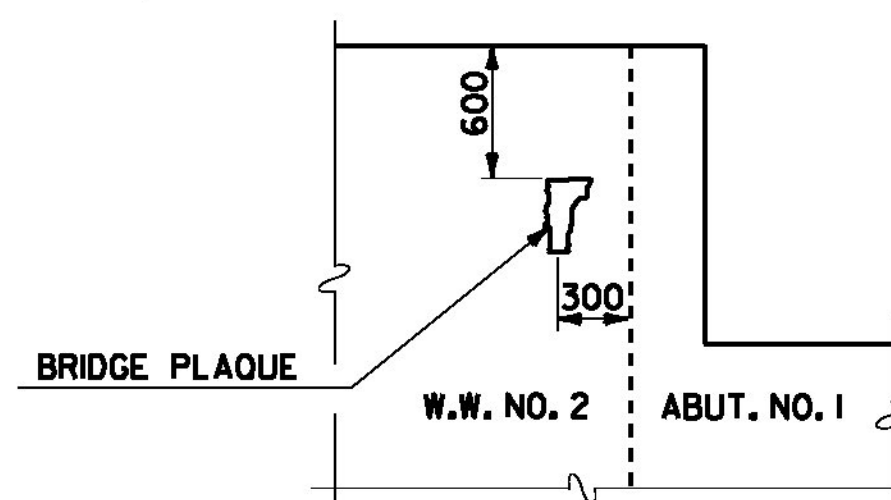


BRIDGE PLAQUE LOCATION DETAIL

NOT TO SCALE
THE BRIDGE PLAQUE WILL BE SUPPLIED BY THE AGENCY OF TRANSPORTATION AND SHALL BE INSTALLED BY THE CONTRACTOR AT ABUTMENT NO. 1 ON THE RIGHT SIDE AS SHOWN OR AS DIRECTED BY THE ENGINEER.

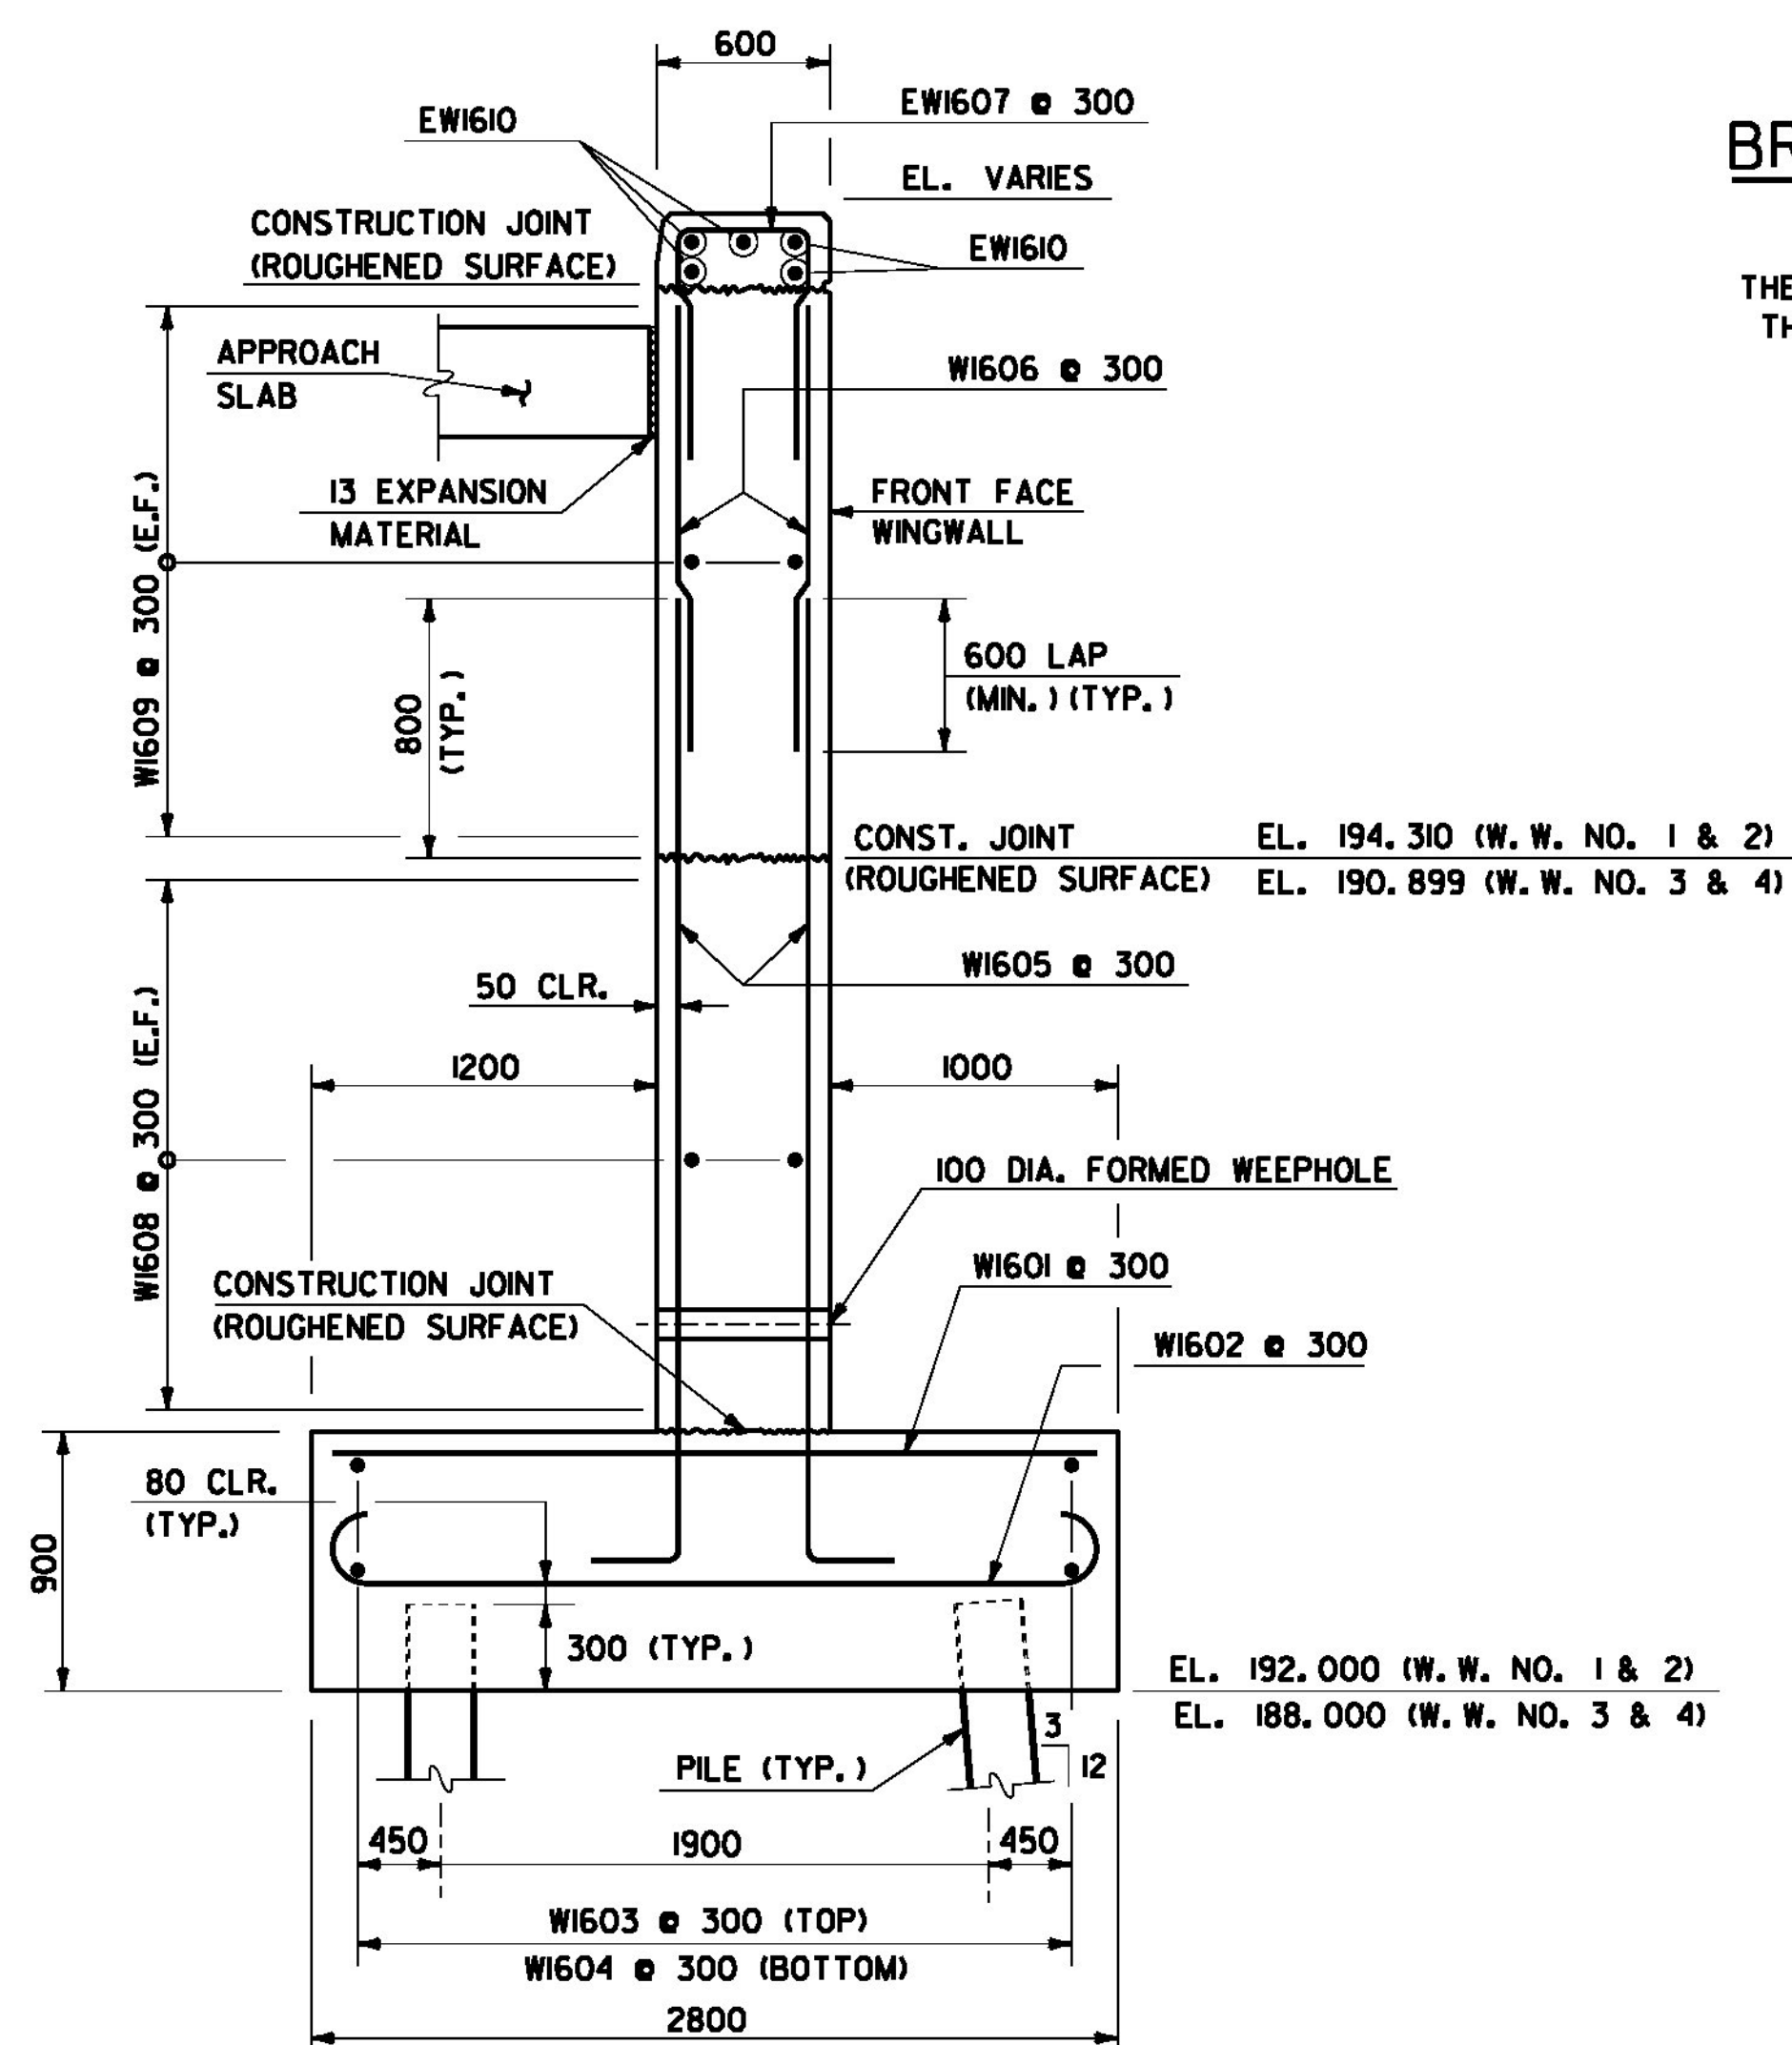


TYPICAL WINGWALL SECTION

SCALE: 1:25
NOTE: APPROACH SLAB RAIL NOT SHOWN FOR CLARITY.

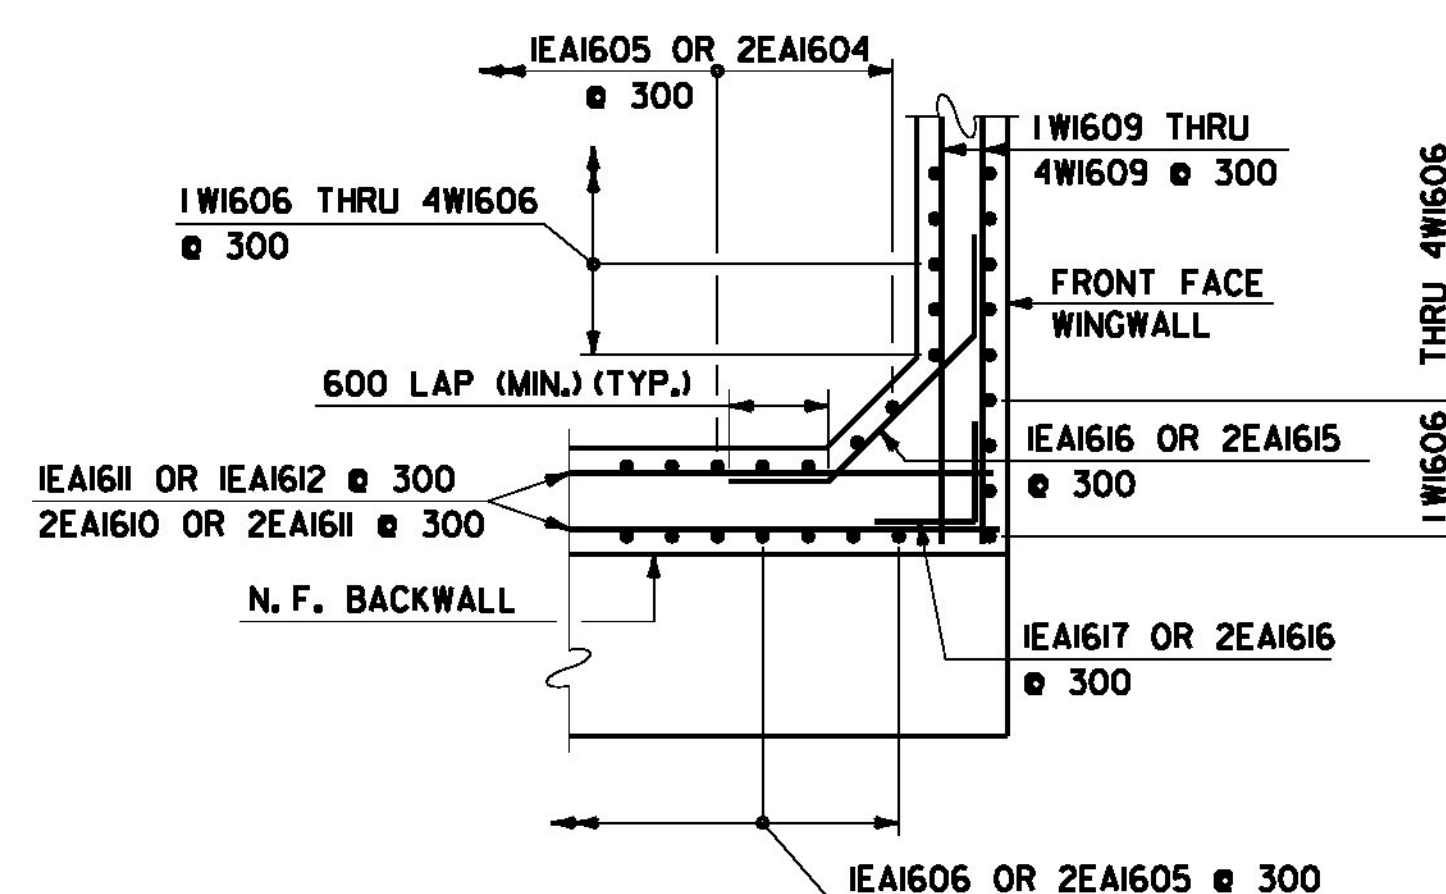

SECTION A-A (CORNER DETAIL ABOVE BRIDGE SEAT)

SCALE: 1:50

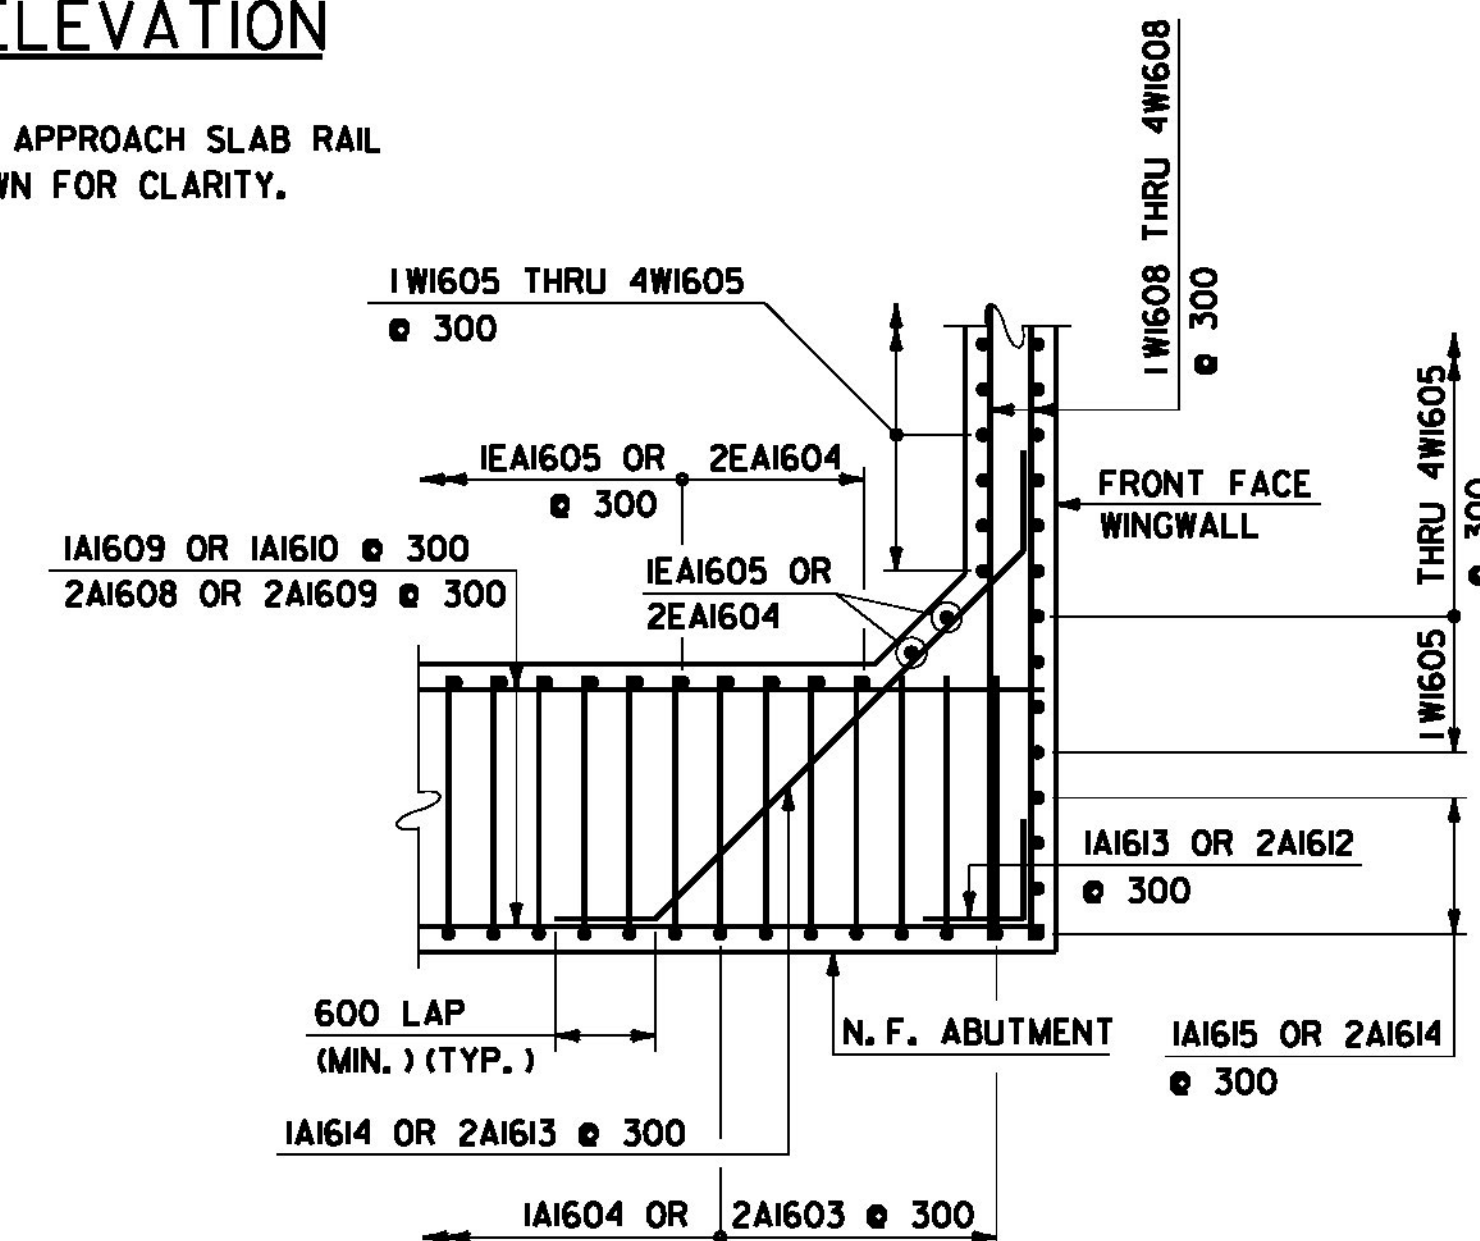

SECTION B-B (CORNER DETAIL BELOW BRIDGE SEAT)

SCALE: 1:50


NOTES

1. REINFORCING STEEL COVER SHALL BE 80 CLR. UNLESS OTHERWISE SPECIFIED.
2. FOR BRIDGE RAIL LAYOUT ON WINGWALLS, SEE SHEET 69.


NOTE: ALL DIMENSIONS IN MILLIMETERS (mm) EXCEPT WHERE NOTED.

PROJECT NAME: MORRISTOWN
PROJECT NUMBER: STP F 029-1(K)C/1


FILE NAME: z10b194awd.dgn PLOT DATE: 29-MAR-2012
PROJECT LEADER: DMB DRAWN BY: S. Merkwon
DESIGNED BY: S. Delta / D. Kull CHECKED BY: R. Joy
SUBSTRUCTURE DETAILS SHEET 91 OF 123

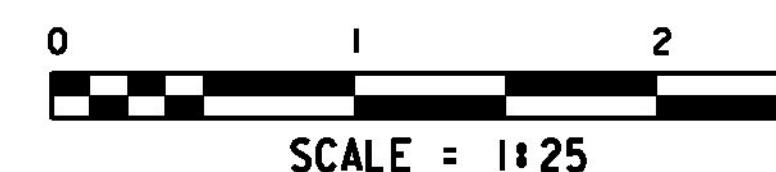

SCALE = 1:25

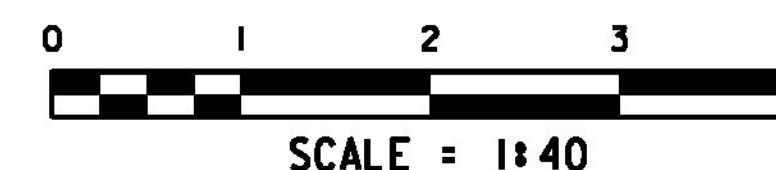

SCALE = 1:40

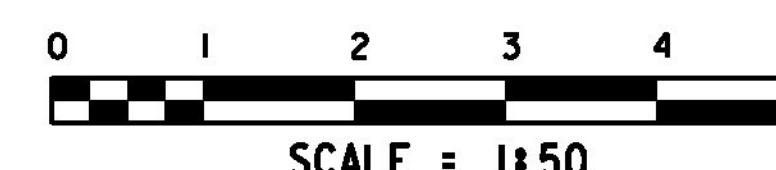

SCALE = 1:50

LEGEND

- N. F. - NEAR FACE
- F. F. - FAR FACE
- E. F. - EACH FACE
- ▲ - CUT TO FIT IN FIELD