



7+540

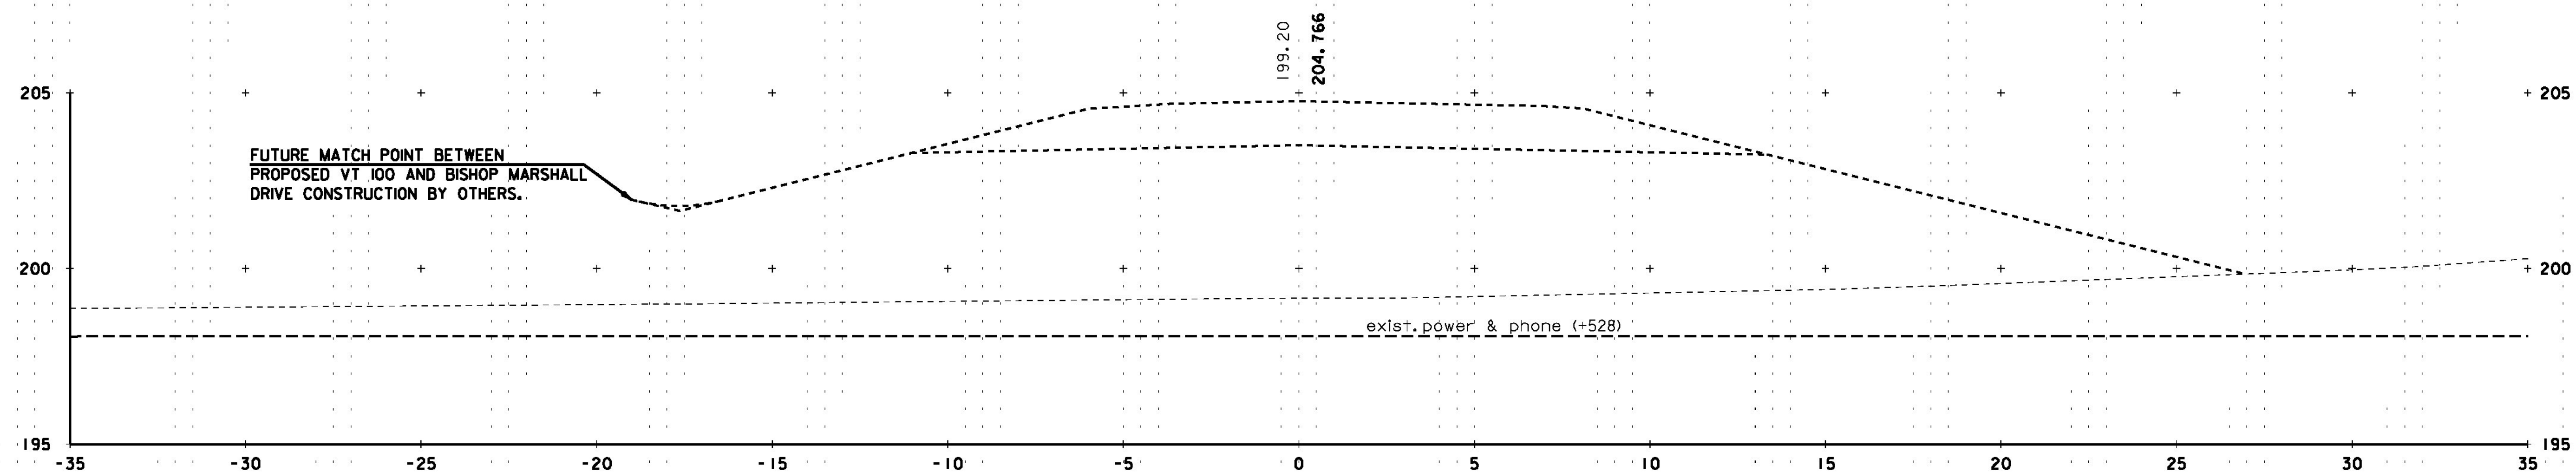

7+520

LEGEND

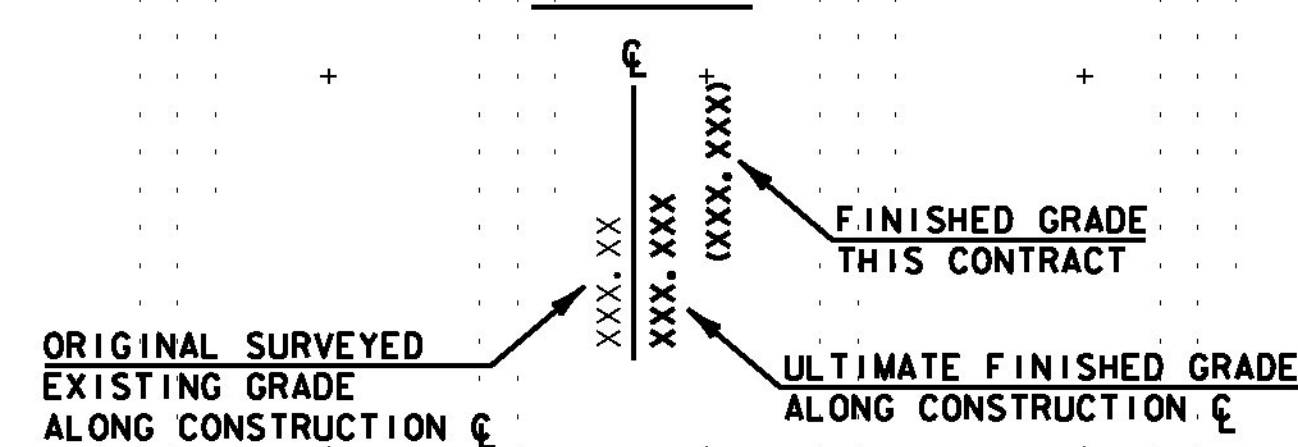

NOTE: ALL DIMENSIONS IN METERS (M) EXCEPT WHERE NOTED.



PROJECT NAME: MORRISTOWN	PLOT DATE: 30-MAR-2012
PROJECT NUMBER: STP F 029-I(2)C/1	DRAWN BY: MAL
FILE NAME: z10b194xs.dgn	CHECKED BY: DMB
PROJECT LEADER: DMB	SHEET 96 OF 123
DESIGNED BY: BRC	
ROADWAY CROSS SECTIONS: 7+520 TO 7+540	