


LEGEND

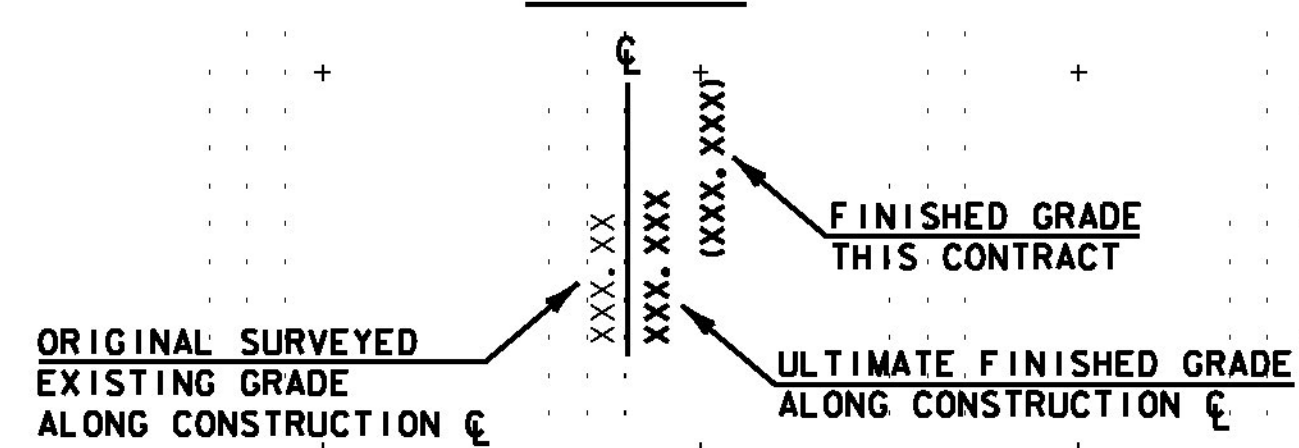

NOTE: ALL DIMENSIONS IN METERS (M) EXCEPT WHERE NOTED.



PROJECT NAME:	MORRISTOWN	PLOT DATE:	30-MAR-2012
PROJECT NUMBER:	STP F 029-I(2)C/I	DRAWN BY:	MAL
FILE NAME:	z10b194xs.dgn	DESIGNED BY:	BRC
PROJECT LEADER:	DMB	CHECKED BY:	DMB
ROADWAY CROSS SECTIONS:	7+700 TO 7+740	SHEET	100 OF 123