


LEGEND

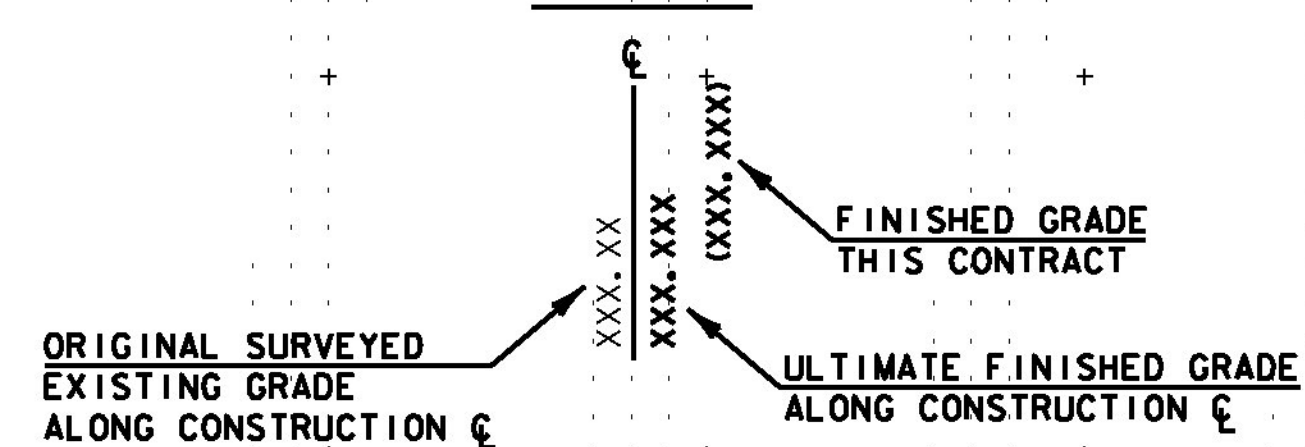

NOTE: ALL DIMENSIONS IN METERS (M) EXCEPT WHERE NOTED.



PROJECT NAME: MORRISTOWN
PROJECT NUMBER: STP F 029-1(2)C/1

FILE NAME: z10b194xs.dgn
PROJECT LEADER: DMB
DESIGNED BY: BRC
ROADWAY CROSS SECTIONS: 7+760 TO 7+800

PLOT DATE: 30-MAR-2012
DRAWN BY: MAL
CHECKED BY: DMB
SHEET 101 OF 123