


**LEGEND**

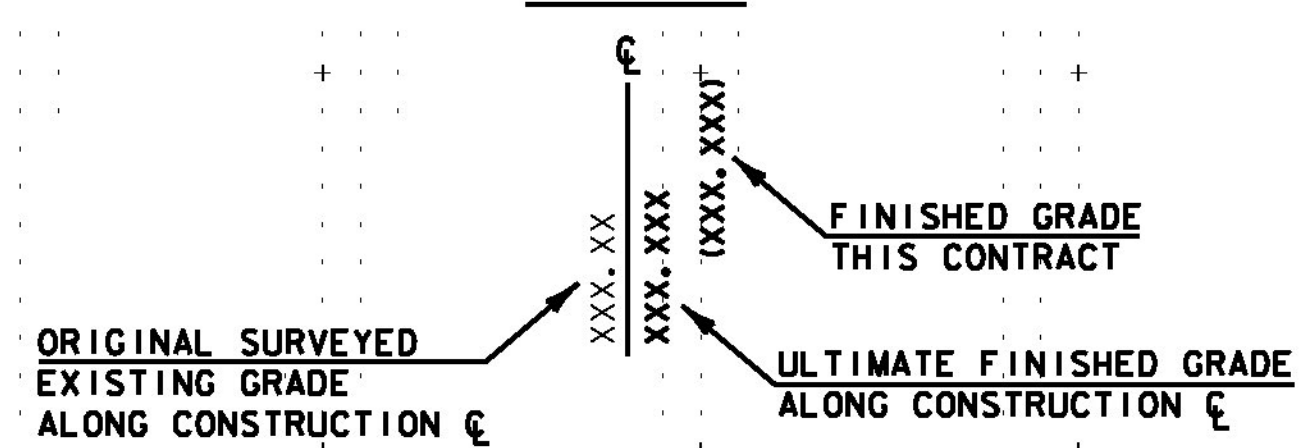

NOTE: ALL DIMENSIONS IN METERS (M) EXCEPT WHERE NOTED.

PROJECT NAME:	MORRISTOWN	FILE NAME:	z10b194xs.dgn	PLOT DATE:	30-MAR-2012
PROJECT NUMBER:	STP F 029-I(2)C/1	PROJECT LEADER:	DMB	DRAWN BY:	MAL
		DESIGNED BY:	BRC	CHECKED BY:	DMB
		ROADWAY CROSS SECTIONS:	7+860 TO 7+880	SHEET	103 OF 123