



STA 7+915
BEGIN BRIDGE

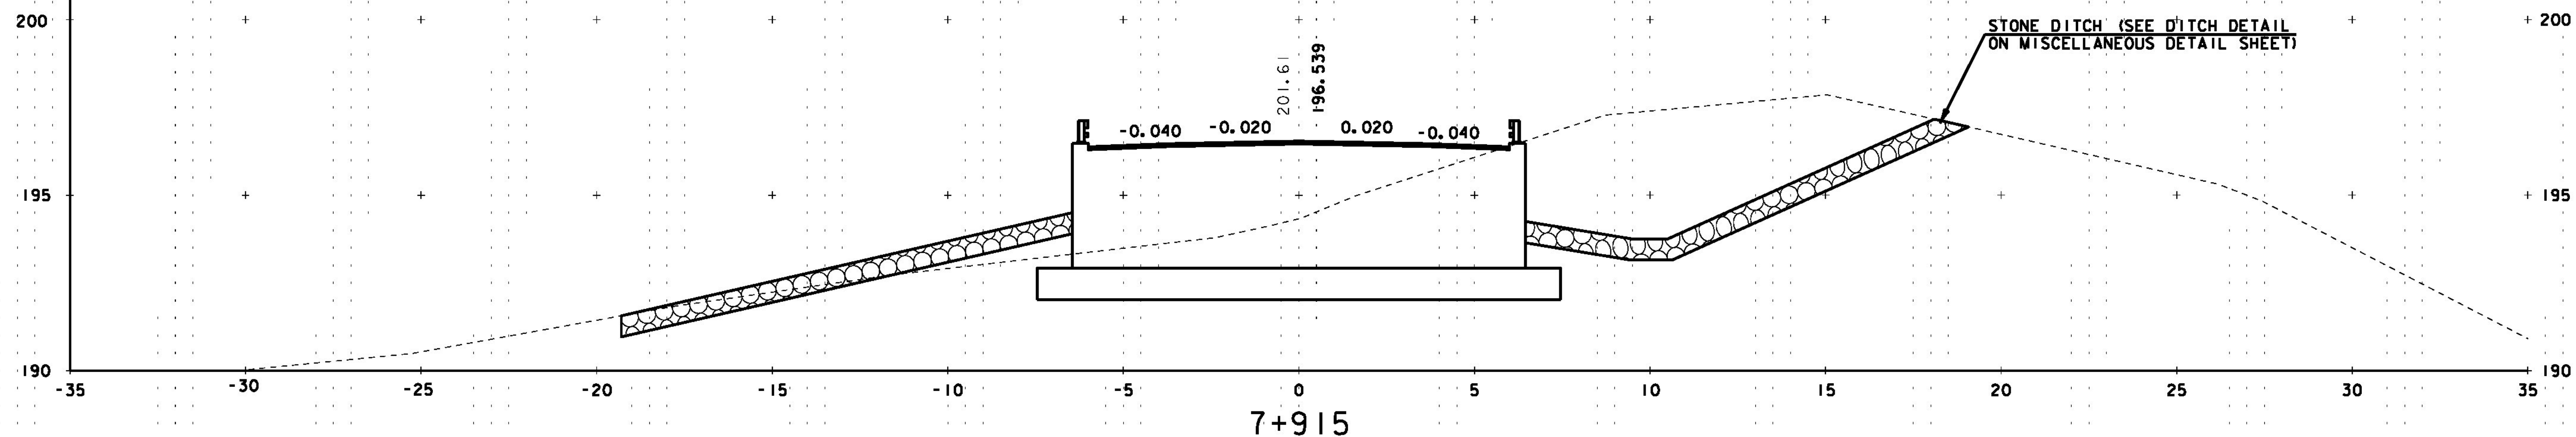


7+915

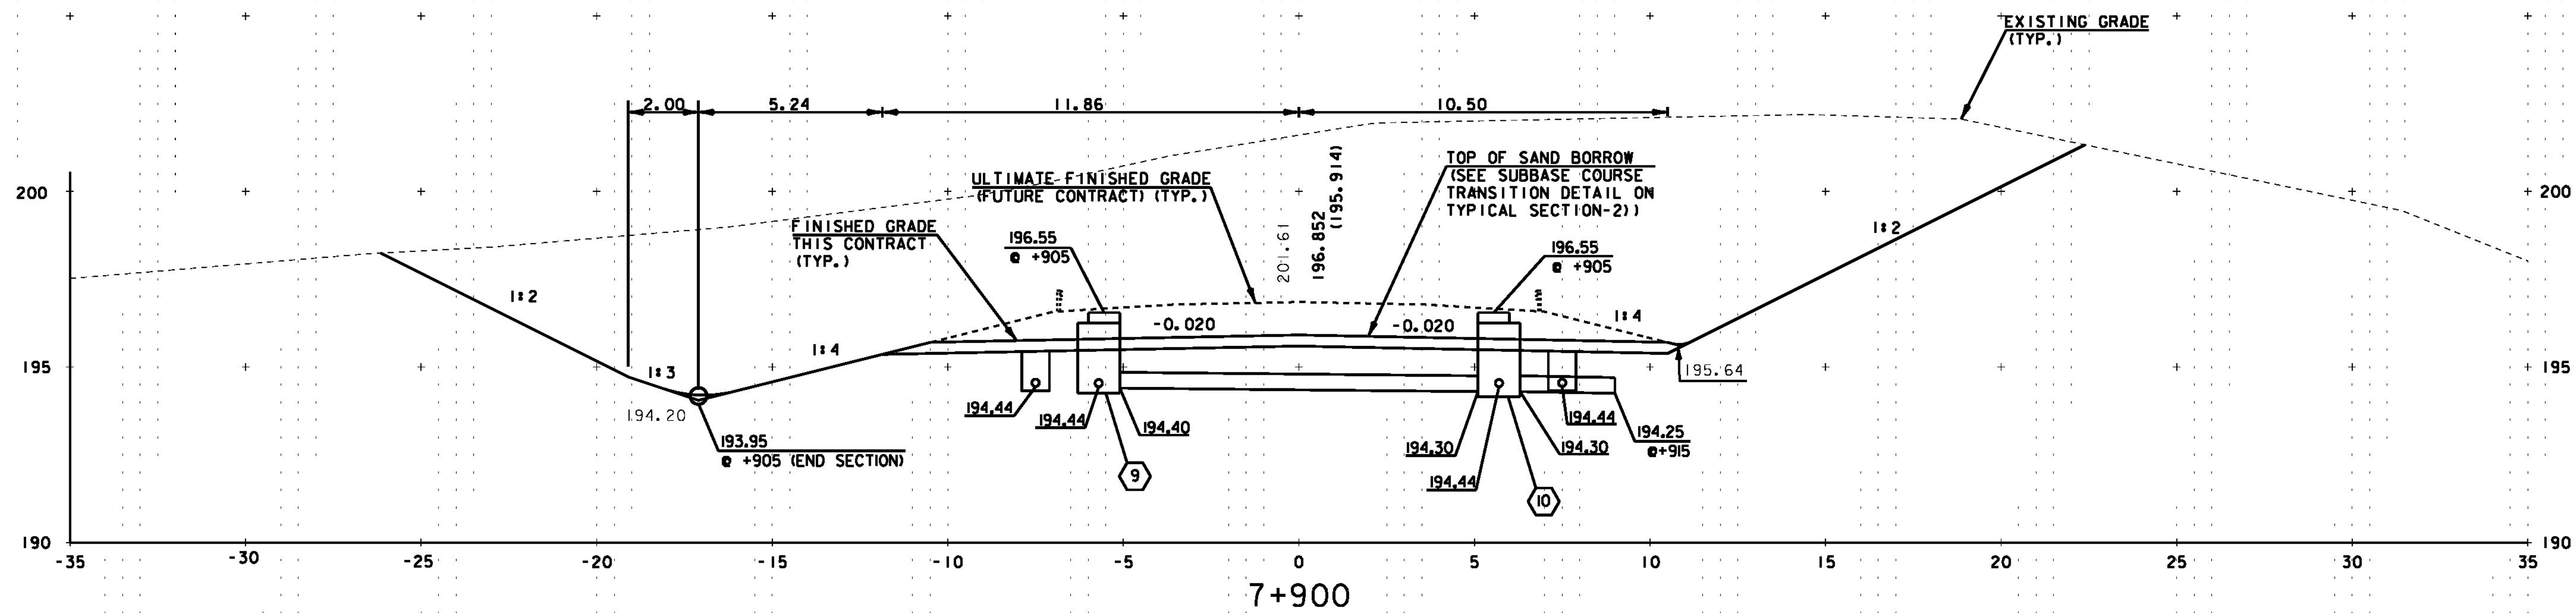

7+900

LEGEND

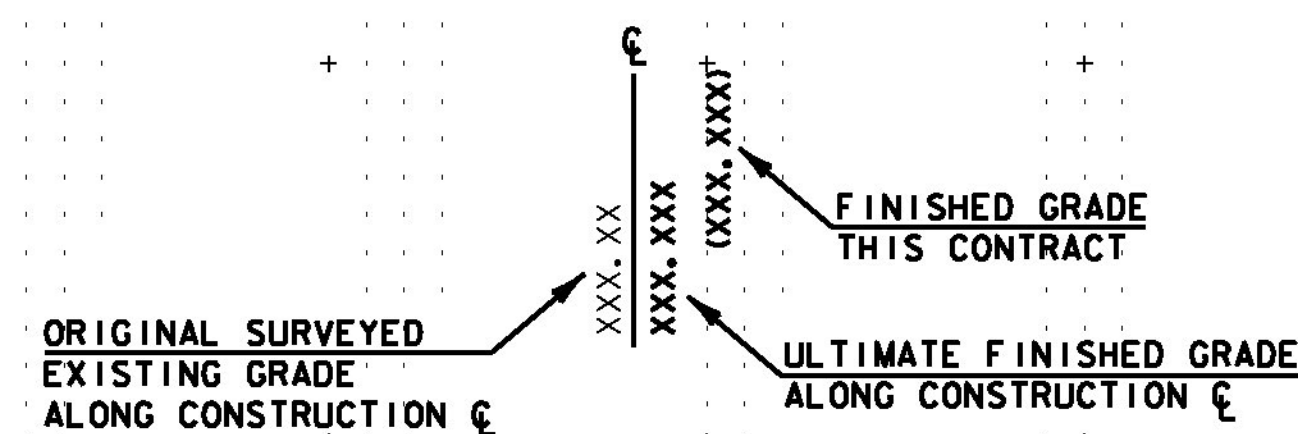

NOTE: ALL DIMENSIONS IN METERS (M) EXCEPT WHERE NOTED.



PROJECT NAME: MORRISTOWN	PLOT DATE: 30-MAR-2012
PROJECT NUMBER: STP F 029-1(2)C/1	DRAWN BY: MAL
FILE NAME: z10b194xs.dgn	CHECKED BY: DMB
PROJECT LEADER: DMB	SHEET 104 OF 123
DESIGNED BY: BRC	
ROADWAY CROSS SECTIONS: 7+900 TO 7+915	