


LEGEND

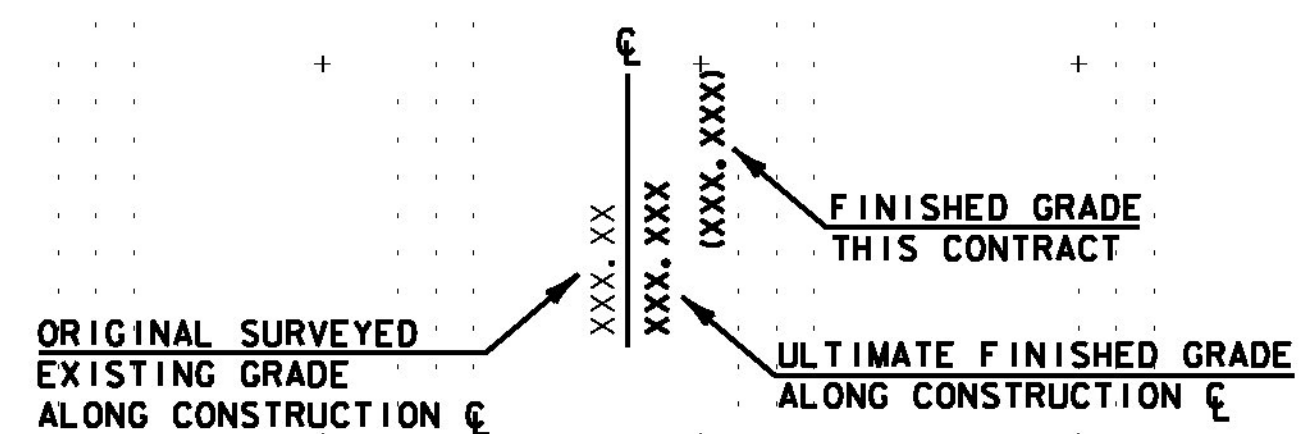

NOTE: ALL DIMENSIONS IN METERS (M) EXCEPT WHERE NOTED.



PROJECT NAME: MORRISTOWN	PLOT DATE: 30-MAR-2012
PROJECT NUMBER: STP F 029-(K2)C/1	DRAWN BY: MAL
FILE NAME: z10b194xs.dgn	CHECKED BY: DMB
PROJECT LEADER: DMB	SHEET 105 OF 123
DESIGNED BY: BRC	
ROADWAY CROSS SECTIONS: 7+920 TO 7+940	